


CONSTRUCTION PLANS FOR CHANNELL BTS

NWC JUSTIN RD. & JOHN KING BLVD. CHANNELL SUBDIVISION LOT 2, BLOCK A

18.762 ACRES
CITY OF ROCKWALL, ROCKWALL COUNTY, TEXAS
NOVEMBER 2014

DRAWING SHEET INDEX

Sheet Number	Sheet Title	Sheet Number	Sheet Title
C0.0	COVER SHEET	C4.1	STORM SEWER PLAN
-	REPLAT	C4.2	STORM SEWER PLAN
A1.0	SITE PLAN	C4.3	STORM SEWER PROFILES
C2.1	GRADING PLAN	C4.4	STORM SEWER PROFILES
C2.2	GRADING PLAN	C4.5	STORM SEWER PROFILES
C2.3	GRADING PLAN	C4.6	HYDRAULIC CALCULATIONS
C2.4	GRADING PLAN & CHANNEL SECTIONS	C5.1	WATER & SANITARY SEWER PLAN
C2.5	OVERALL CROSS SECTION PLAN	C5.2	SANITARY SEWER PROFILE
C2.6	SUB-BALLAST CROSS SECTIONS	C6.1	PAVING PLAN
C2.7	SUB-BALLAST CROSS SECTIONS	C6.2	PAVING DETAILS
C2.8	SUB-BALLAST CROSS SECTIONS	C7.1	EROSION CONTROL PLAN
C3.1	EXISTING DRAINAGE AREA MAP	C7.2	EROSION CONTROL DETAILS
C3.2	PROPOSED DRAINAGE AREA MAP	L0.00- L3.05	LANDSCAPE PLANS

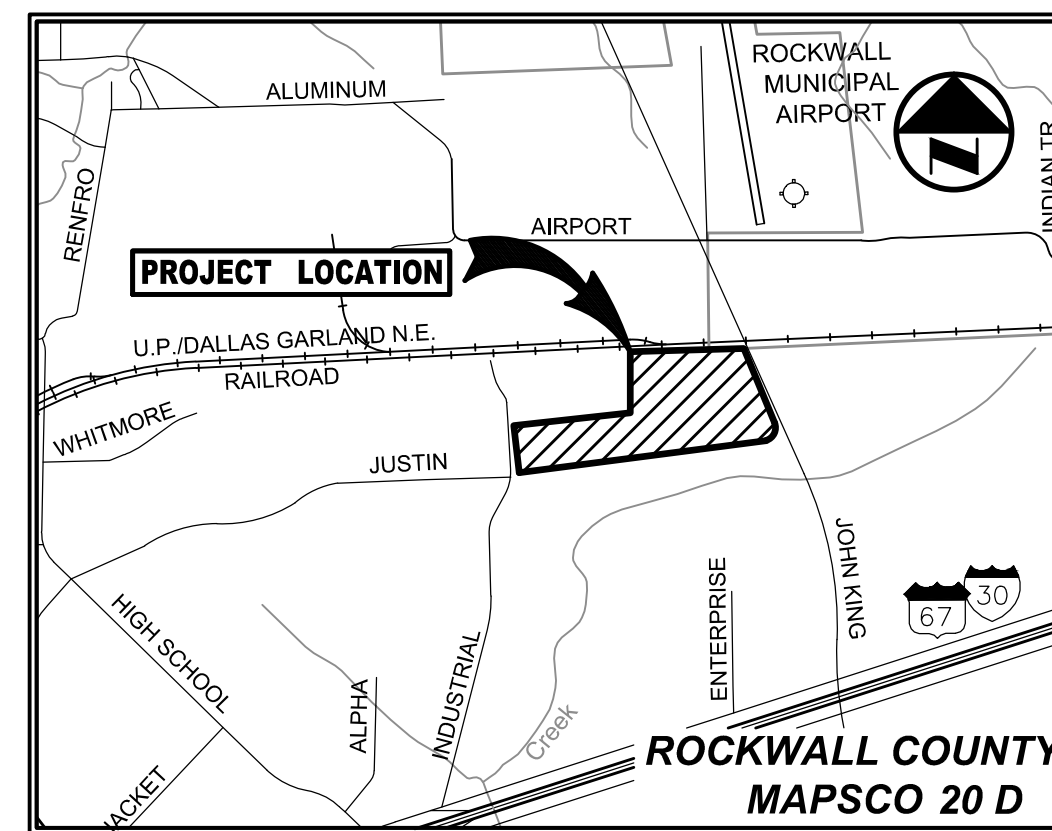

VICINITY MAP
(NOT TO SCALE)

FOR


CHANNELL
Where The Industry Connects.
CHANNELL COMMERCIAL CORPORATION
26040 YNEZ ROAD
PO BOX 9022
TEMECULA, CA 92592-9022
+1 (951) 719-2600

PREPARED BY

 **Pacheco Koch**
7557 RAMBLER ROAD, SUITE 1400 PH. 972.235.3031
DALLAS, TX 75231 FAX 972.235.9544
TX REG. ENGINEERING FIRM F-14439
TX REG. SURVEYING FIRM LS-101938-05

RECORD DRAWING

THE SIGNED AND SEALED CONSTRUCTION DOCUMENT HAS BEEN REVISED TO REFLECT CONSTRUCTION RECORDS MAINTAINED AND PROVIDED BY THE CONTRACTOR FOR THIS PROJECT. THE INFORMATION SHOWN ON THIS RECORD DRAWING, WHICH WAS PROVIDED BY THE CONTRACTOR, OR OTHERS NOT ASSOCIATED WITH THE DESIGN ENGINEER, CANNOT BE VERIFIED FOR ACCURACY OR COMPLETENESS. PACHECO KOCH SHALL ASSUME NO LIABILITY FOR ANY CHANGES MADE DURING CONSTRUCTION THAT WERE NOT SPECIFICALLY APPROVED BY THE ENGINEER PRIOR TO CONSTRUCTION. THE SEALED CONSTRUCTION DRAWINGS ARE ON FILE AT THE OFFICES OF PACHECO KOCH.

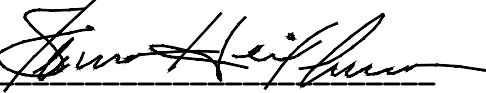ATTESTED BY: 
SIGNATURE: STEVEN HEILBRUN, P.E.
ENGINEER OF RECORD: STEVEN HEILBRUN, P.E.
CONTRACTOR: BOB MOORE CONSTRUCTION, INC.
DATE REVISED: 09/29/2016

NO.	DATE	REVISION
1	09/29/2016	RECORD DRAWINGS
2	09/24/2015	ASI 26