

CONSTRUCTION PLANS

FOR

CHASE BANK

NORTH LAKE SHORE DRIVE

& S.H. 66 (RUSK ROAD)


AN ADDITION TO

THE CITY OF ROCKWALL, TEXAS

PREPARED FOR
J.P. MORGAN CHASE BANK
 8111 PRESTON ROAD, SUITE 250
 DALLAS, TX. 75225

ENGINEER
O'DONALD ENGINEERING
 1601 EAST LAMAR BLVD., SUITE 210
 ARLINGTON, TEXAS 76011
 TEL: 817-794-0202
 FAX: 817-548-8430

SURVEYOR
PIBURN PARTNERS, LLC
 9535 FOREST LANE., SUITE 205
 DALLAS, TEXAS 75243
 TEL: 214-328-3500
 FAX: 214-328-3512

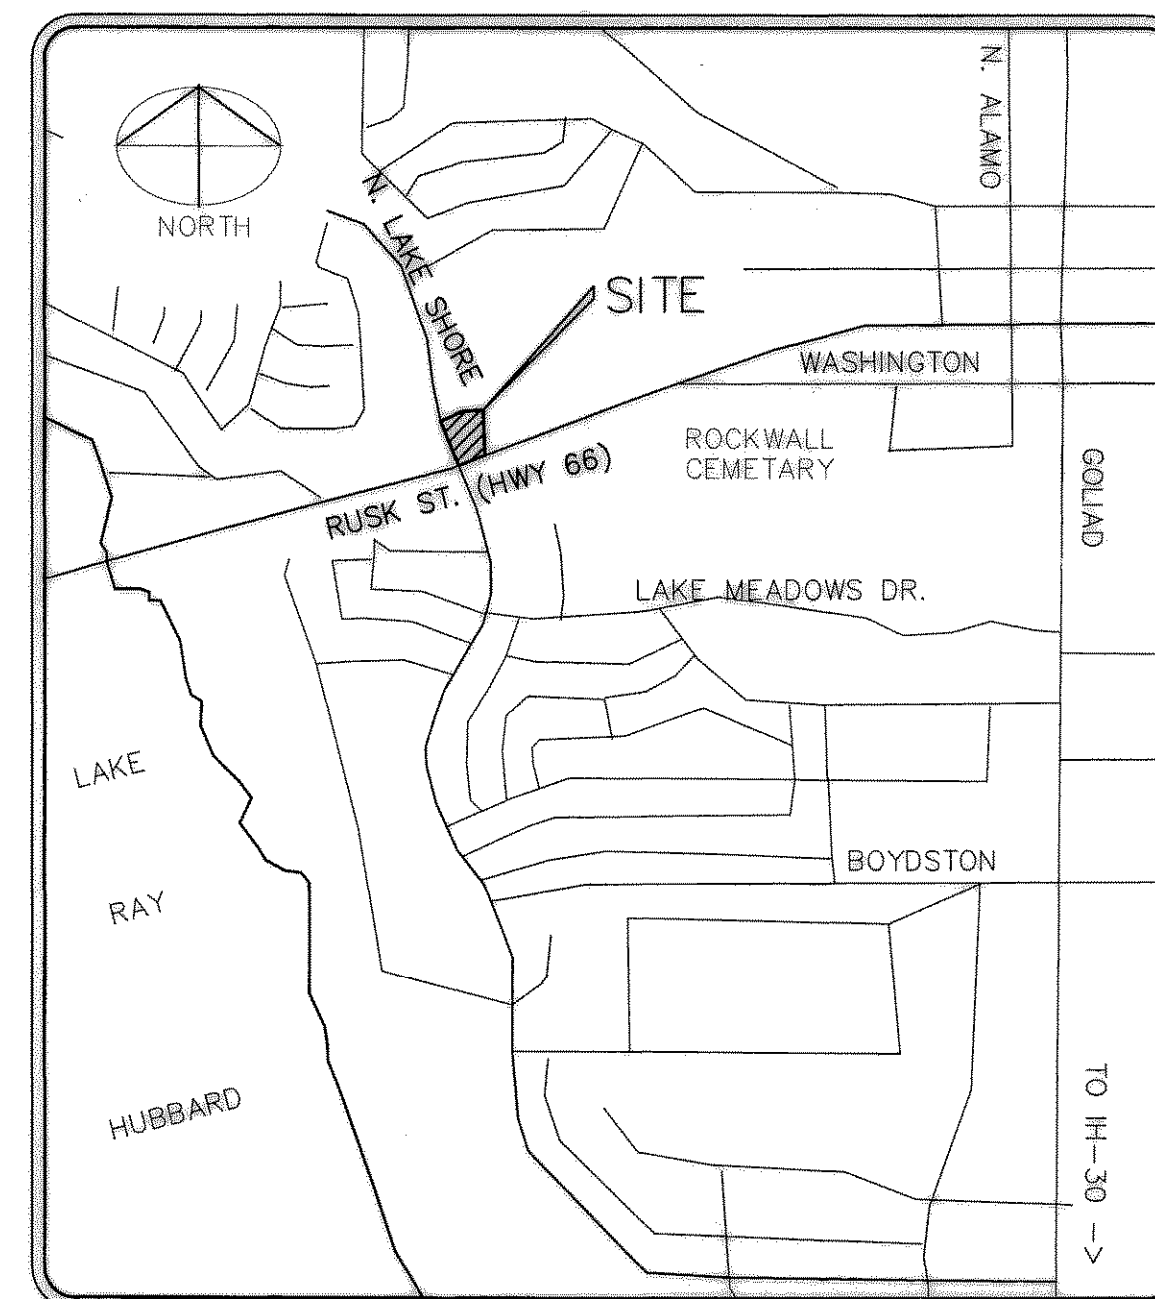

VICINITY MAP
NTS

INDEX OF DRAWINGS

	REPLAT
	SITE PLAN
C1	DEMOLITION PLAN
C2	PAVING PLAN
C3	GRADING PLAN
C4	DRAINAGE AREA MAP
C5	STORM SEWER PLAN
C6	STORM SEWER PROFILE
C7	WATER & SANITARY SEWER PLAN
C8	EROSION CONTROL PLAN
C9	DETAILS (PRIVATE)
L1.01	LANDSCAPE PLAN

AS-BUILT

NOTE:
 THESE PLANS HAVE BEEN REVISED
 TO CONFORM WITH CONSTRUCTION
 RECORDS PROVIDED BY CONTRACTOR.

