


CURVE TABLE						
CURVE	DELTA	RADIUS	TANGENT	LENGTH	BEARING	DISTANCE
C1	90°12'19"	20.00	20.07	31.49	N44°50'22"E	28.33
C1	90°12'19"	20.00	20.07	31.49	N44°50'22"E	28.33
C5	65°09'55"	20.00	12.78	22.75	S32°34'58"W	21.54
C5	65°09'55"	20.00	12.78	22.75	S32°34'58"W	21.54
C7	21°18'23"	198.00	37.25	73.63	N12°02'00"W	73.21
C7	21°18'23"	198.00	37.25	73.63	N12°02'00"W	73.21
C8	88°48'24"	20.00	22.53	33.79	N21°43'17"E	29.91
C8	88°48'24"	20.00	22.53	33.79	N21°43'17"E	29.91
C9	142°25'12"	20.00	58.78	49.71	S70°54'06"W	37.87
C9	142°25'12"	20.00	58.78	49.71	S70°54'06"W	37.87
C11	9°55'59"	248.81	21.43	42.75	N05°26'29"W	42.70
C11	9°55'59"	248.81	21.43	42.75	N05°26'29"W	42.70
C16	90°09'10"	44.00	44.12	62.23	N44°56'38"E	62.31
C16	90°09'10"	44.00	44.12	62.23	N44°56'38"E	62.31
C17	90°09'10"	20.00	20.05	31.47	N44°56'38"E	28.32
C17	90°09'10"	20.00	20.05	31.47	N44°56'38"E	28.32
C18	79°57'20"	44.00	36.89	61.40	S28°45'25"W	56.54
C18	79°57'20"	44.00	36.89	61.40	S28°45'25"W	56.54
C19	15°25'26"	182.00	24.65	48.99	N13°53'29"W	48.65
C20	19°23'58"	387.95	68.31	131.35	S65°40'32"W	130.78

Note: All dimensions are from face of curb.

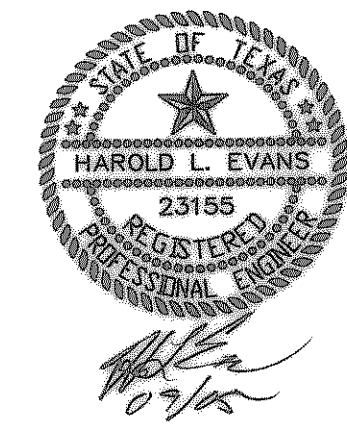

AS BUILT

RALPH HALL PARKWAY
110' R.O.W. PER. PLAT

REVISION	1/17/05	HAROLD L. EVANS CONSULTING ENGINEER P.O. BOX 570355-76370 2331 GUS THOMASSON ROAD, SUITE 102 DALLAS, TEXAS 75228, (214) 328-8138	DIMENSION CONTROL PLAN CHILDRENS PARK II STEGER TOWNE CROSSING, PHASE II CITY OF ROCKWALL		SHEET NO.
REVISION	1/21/05				3
REVISION	2/15/05		7		
REVISION DESCRIPTION	DATE	SCALE	DESIGN	DRAWN	JOB NO.
	12/6/04	1" = 30'	H.L.E.	AC	04053

C:\PROJECTS\04053\04053.DWG, 09/30/2005 12:35:25 PM, AC