



CIVIL CONSTRUCTION PLANS FOR CHILDRENS LIGHTHOUSE AT 3009 GOLIAD STREET ROCKWALL, TEXAS

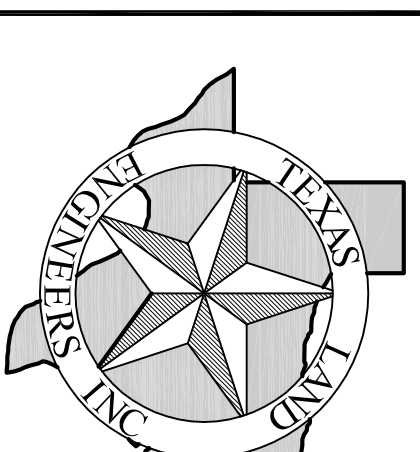


TEXAS LAND ENGINEERS, INC.
1201 SHEPHERD DRIVE
HOUSTON, TX 77007
PH: (281) 576-1085
FAX: (281) 576-1086

REVISIONS	
NO.	DATE DESCRIPTION

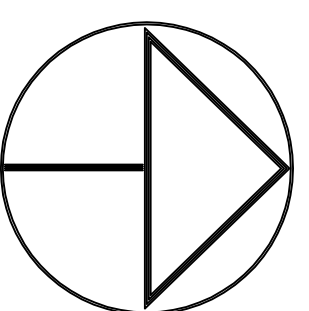

NORTH

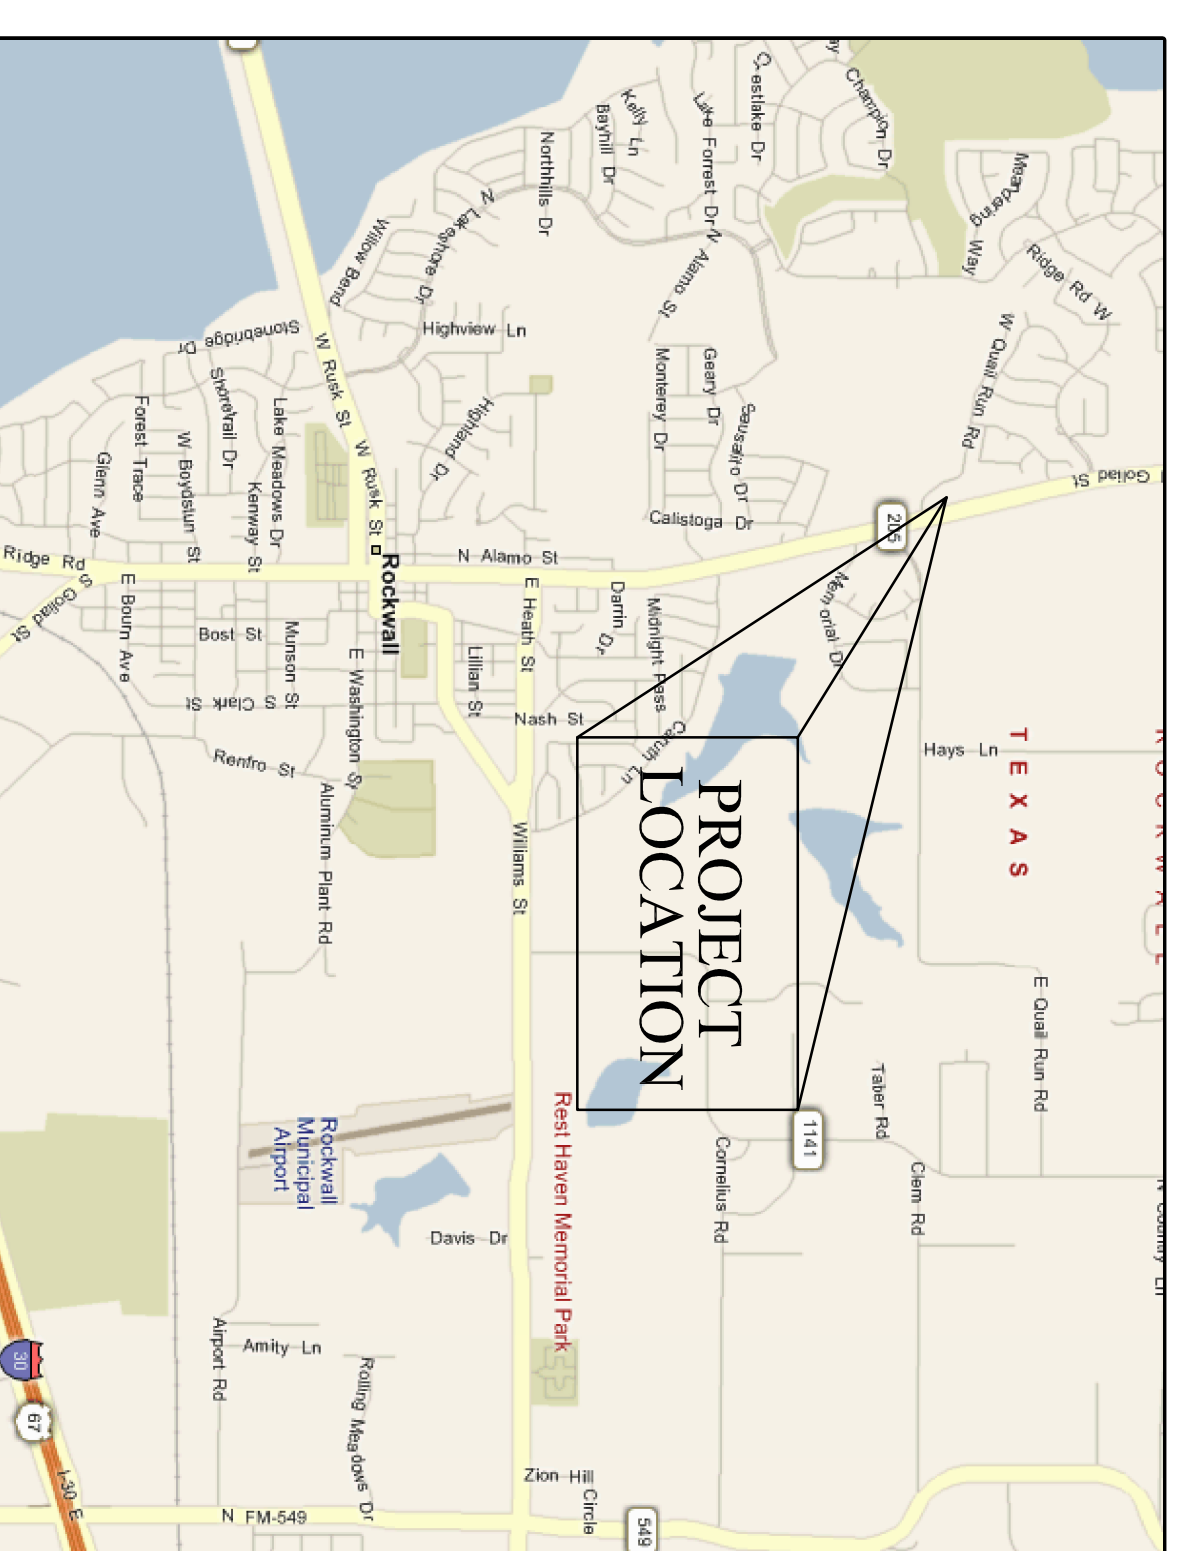

VICINITY MAP
NOT-TO-SCALE

INDEX OF DRAWINGS

- C1 - TITLE SHEET
- C2 - CONSTRUCTION NOTES
- C3 - EXISTING CONDITIONS SURVEY
- C4 - GRADING PLAN
- C5 - DRAINAGE PLAN
- C6 - UTILITY PLAN
- C7 - WATER LINE PLAN AND PROFILE
- C8 - STM SWR AND SAN SWR PLAN AND PROFILE
- C9 - STORM WATER POLLUTION PREVENTION PLAN
- C10 - STORM WATER POLLUTION PREVENTION DETAILS
- C11 - SANITARY SEWER CONST. DETAILS
- C12 - STORM SEWER CONST. DETAILS
- C13 - PAVEMENT CONST. DETAILS

CHILDRENS LIGHTHOUSE
3009 GOLIAD STREET
ROCKWALL, TEXAS

TITLE SHEET



REGISTRATION NO. E-95553

TITLE PROJECT NO. 08-062

DATE: AUGUST 2009

DRAWN BY: DG

CHECKED BY: JG

SHEET

C1

AS-BUILT DRAWINGS

