


General Notes



Vicinity Map

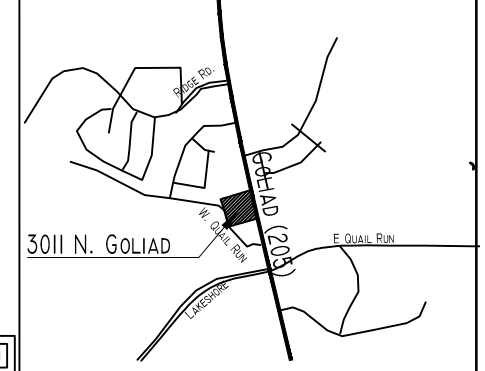

Copyright

ALL INFORMATION, EITHER DRAWN, WRITTEN, OR IMPLIED APPEARING ON THIS DOCUMENT SHALL NOT BE REPLICATED, DISCLOSED OR OTHERWISE USED WITHOUT WRITTEN PERMISSION OF THE AUTHOR.

THIS DOCUMENT IS AN INSTRUMENT OF SERVICE AND IS THE SOLE PROPERTY OF THE AUTHOR. FURTHERMORE, THE USE OF THIS DOCUMENT FOR ANY PURPOSE SHALL BE REVIEWED, IF THE INTENT OF THE DESIGN OR THE CONSTRUCTION TECHNIQUES OR DETAILS SHOWN HEREIN ARE NOT ADHERED TO OR THE CONTRACTUAL AGREEMENT GOVERNING THEIR USE IS NOT STRICTLY ADHERED TO.

No.	Revision/Issue	Date
2	CONTRACT DRAWINGS	3/12/16

Dallas Design Build

6916 Echo Canyon
McKinney, Texas 75070
972-877-6630
eam@dallasdb.com

Project
CHILDRENS LIGHTHOUSE
3011 N. GOLIAD
ROCKWALL, TX

Description
EROSION CONTROL

Date
8/14/15

Drawn By
sle

Scale
1"=20'

DESIGN TEAM:

OWNER:
EMILY AND AMAL FERNANDO
3465 FM 544
WYJIE, TEXAS 75034
214-794-2094

FRANCHISE INFORMATION:
CHILDRENS LIGHTHOUSE FRANCHISE INC.
101 S. JENNINGS SUITE #209
FORT WORTH, TEXAS 76104

DESIGN:
SAM ELLIS
DOB
6916 ECHO CANYON DR.
MCKINNEY, TEXAS 75070
972-877-6630

CIVIL ENGINEER:
RYAN KIM
TEXAS REGISTERED ENGINEERING FIRM # 8280
817-308-6243
JAY149@HOTMAIL.COM

