


LOCATION MAP
NO SCALE

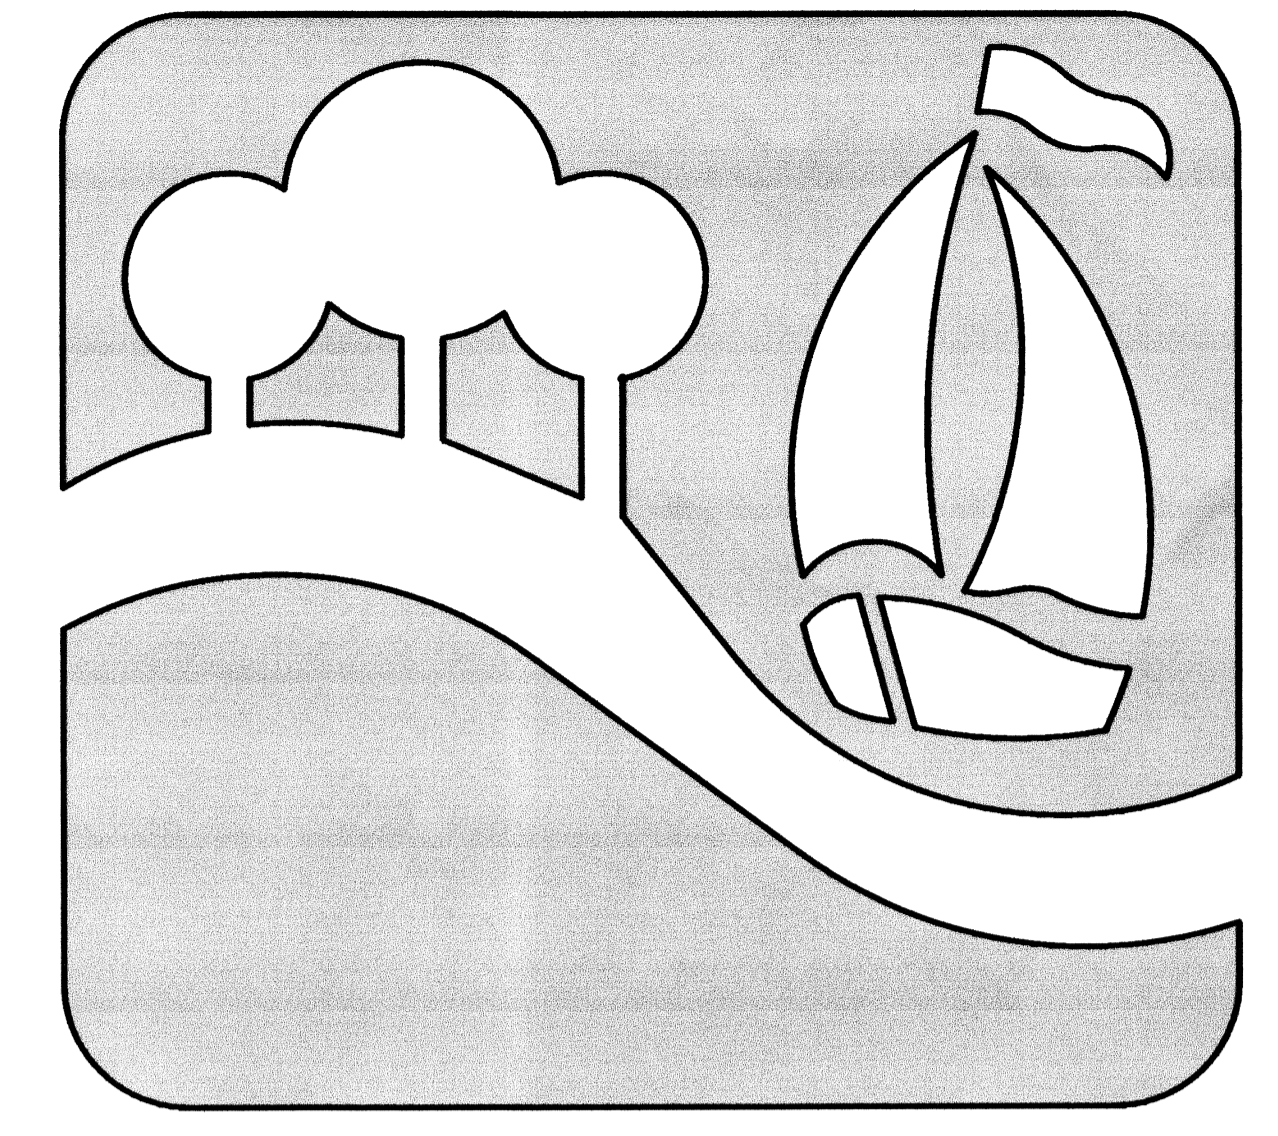

"THE NEW HORIZON"

SITE CONSTRUCTION PLANS

FOR

CHILDREN'S PARK

PARKS OF ROCKWALL ADDITION


LOT 1, BLOCK 1

IN THE


CITY OF ROCKWALL, TEXAS

SHEET INDEX

Sheet No.	Description
1	Cover Sheet
2	Plat - 1 of 2
3	Plat - 2 of 2
C1	Dimension Control
C2	Grading Plan
C3	Drainage Area Map
C4	Water/Sewer/Storm Plan
C5	Erosion Control
C6	Private Onsite Details
DT1	Stormtech Detention System
S5	Stone RW Details

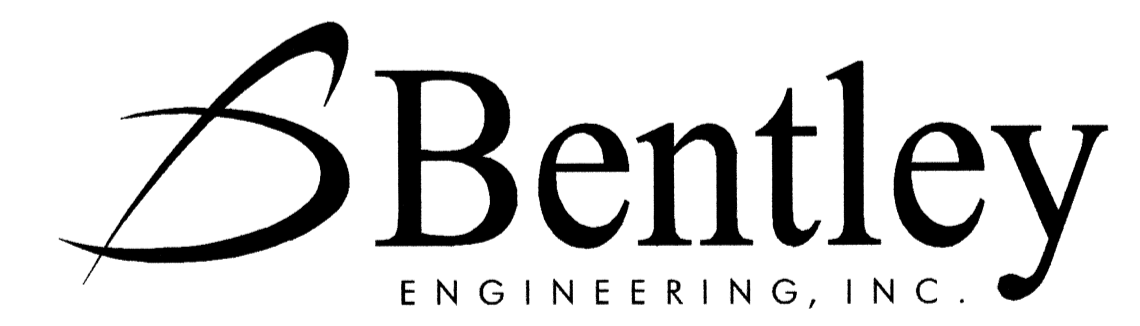

1855 EMERALD BAY DRIVE
ROCKWALL, TEXAS 75087
PH. 214.957.1407
FIRM REG. NO. 674

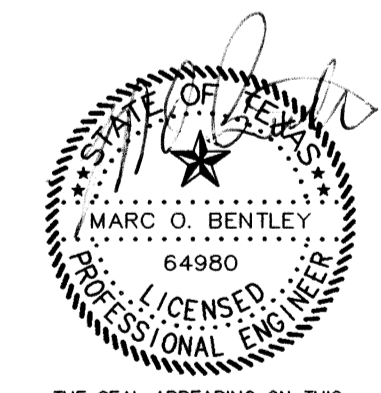

THE SEAL APPEARING ON THIS DOCUMENT WAS AUTHORIZED BY MARC O. BENTLEY, P.E. NO. 64980 ON 03/02/13

MARCH 2013

OWNER:
RICKI ROSE
941 STEGER TOWNE DRIVE
ROCKWALL, TX 75032

RECORD DRAWING

IMPROVEMENTS INDICATED ON THESE PLANS WHERE REVISED IN ACCORDANCE WITH THE ASBUILT SURVEY PERFORMED BY JAMES ANDERSON AND PROVIDED TO BENTLEY ENGINEERING, INC. ON 02/14/14.

DATE: FEBRUARY 19, 2014

CHILDREN'S PARK 2012109

RECORD DRAWING

X:\projects\2012\2012109\cross\item.dwg Wed Feb 19 19:14:39 2014