

ENGINEERING PLANS


CHRISTIAN BROTHERS AUTOMOTIVE

ROCKWALL MARKET CENTER SOUTH ADDITION

129 E. RALPH HALL PKWY., ROCKWALL, TEXAS

Index Of Drawings

- SP Cover Sheet
- Final Plat
- Site Plan
- C 1 Paving Plan
- C 2 Grading Plan
- C 3 Drainage Area Map
- C 4 Storm Sewer Plan
- C 5 Storm Sewer Profiles
- C 6 Utility Plan
- C 7 Erosion Control Plan
- C 8 Construction Details
- L 1 Landscape Plan
- L 2 Landscape Details

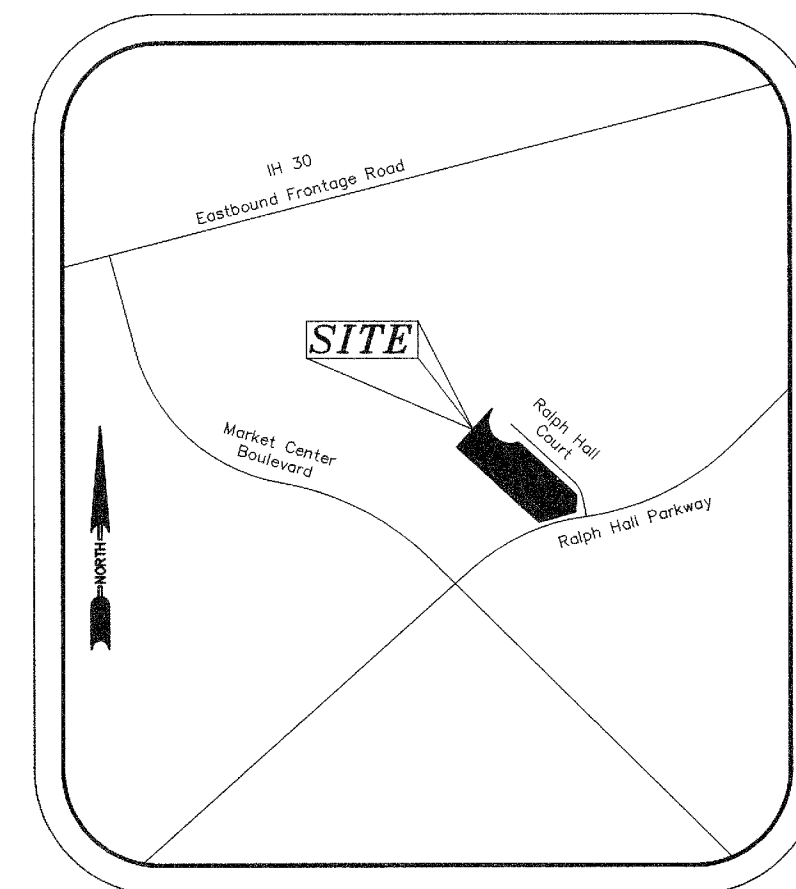

Vicinity Map
NTS


Prepared For
Christian Brothers Automotive

15995 N. Barker Landing
Suite 145
Houston, Texas 77079
Phone: (281)870-8900 ext. 105

Engineer


CROSS ENGINEERING
CONSULTANTS

131 S. Tennessee Street McKinney, Texas 75069
972.562.4409 Texas P.E. Firm No. F-5935

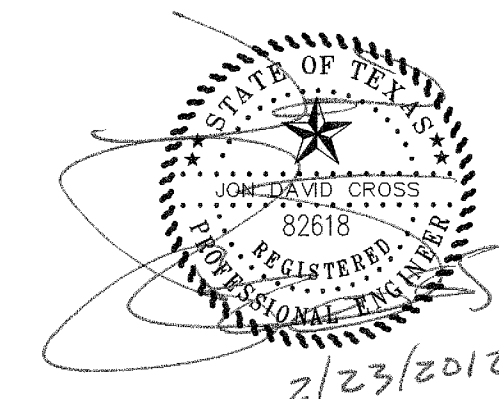

AS-BUILT DRAWINGS

To the best of our knowledge, Cross Engineering Consultants, Inc., hereby states that this plan is As-Built. The information provided is based on surveying at the site and information provided by the contractor.


 JON DAVID CROSS, P.E.
 DATE 2/23/2012

ISSUE DATES:	REVISIONS:	DATE	BY
4-21-11	Revised Water Services	6-14	DZ
	Revised Grades & Sidewalk	8-31	DZ