
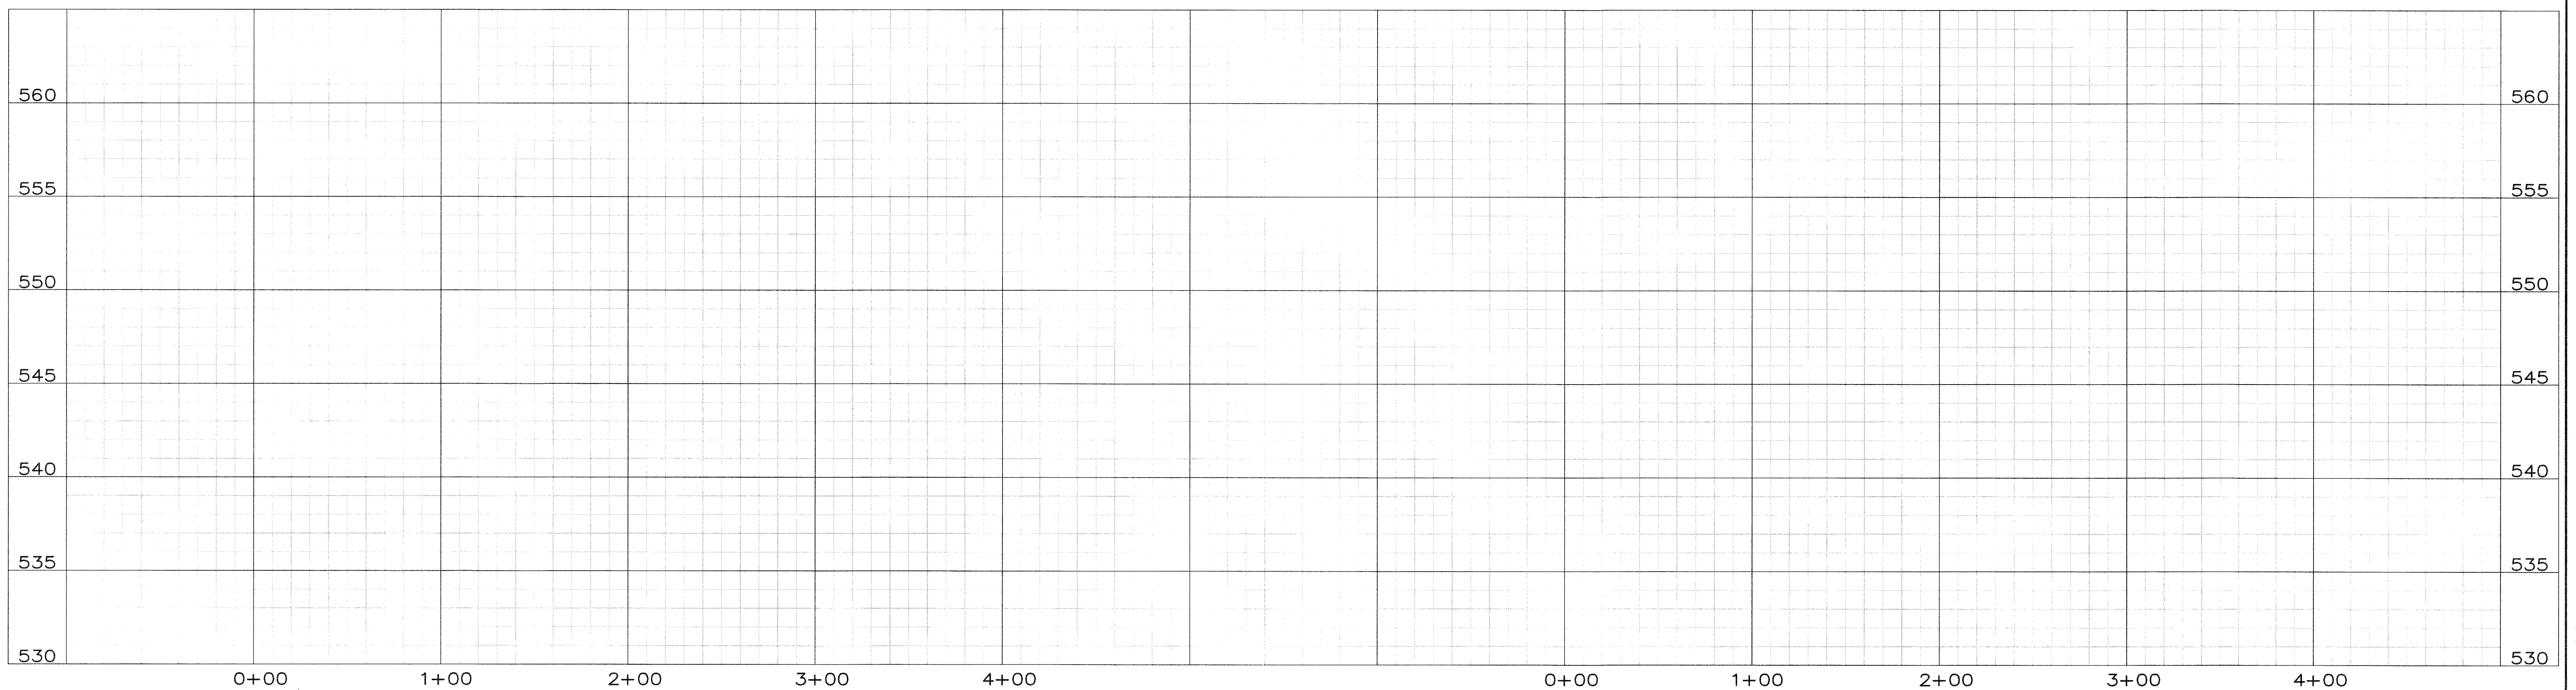


Private Storm Line "A"

Storm Line "B"

Private Storm Line "C"

Private Storm Line "D"

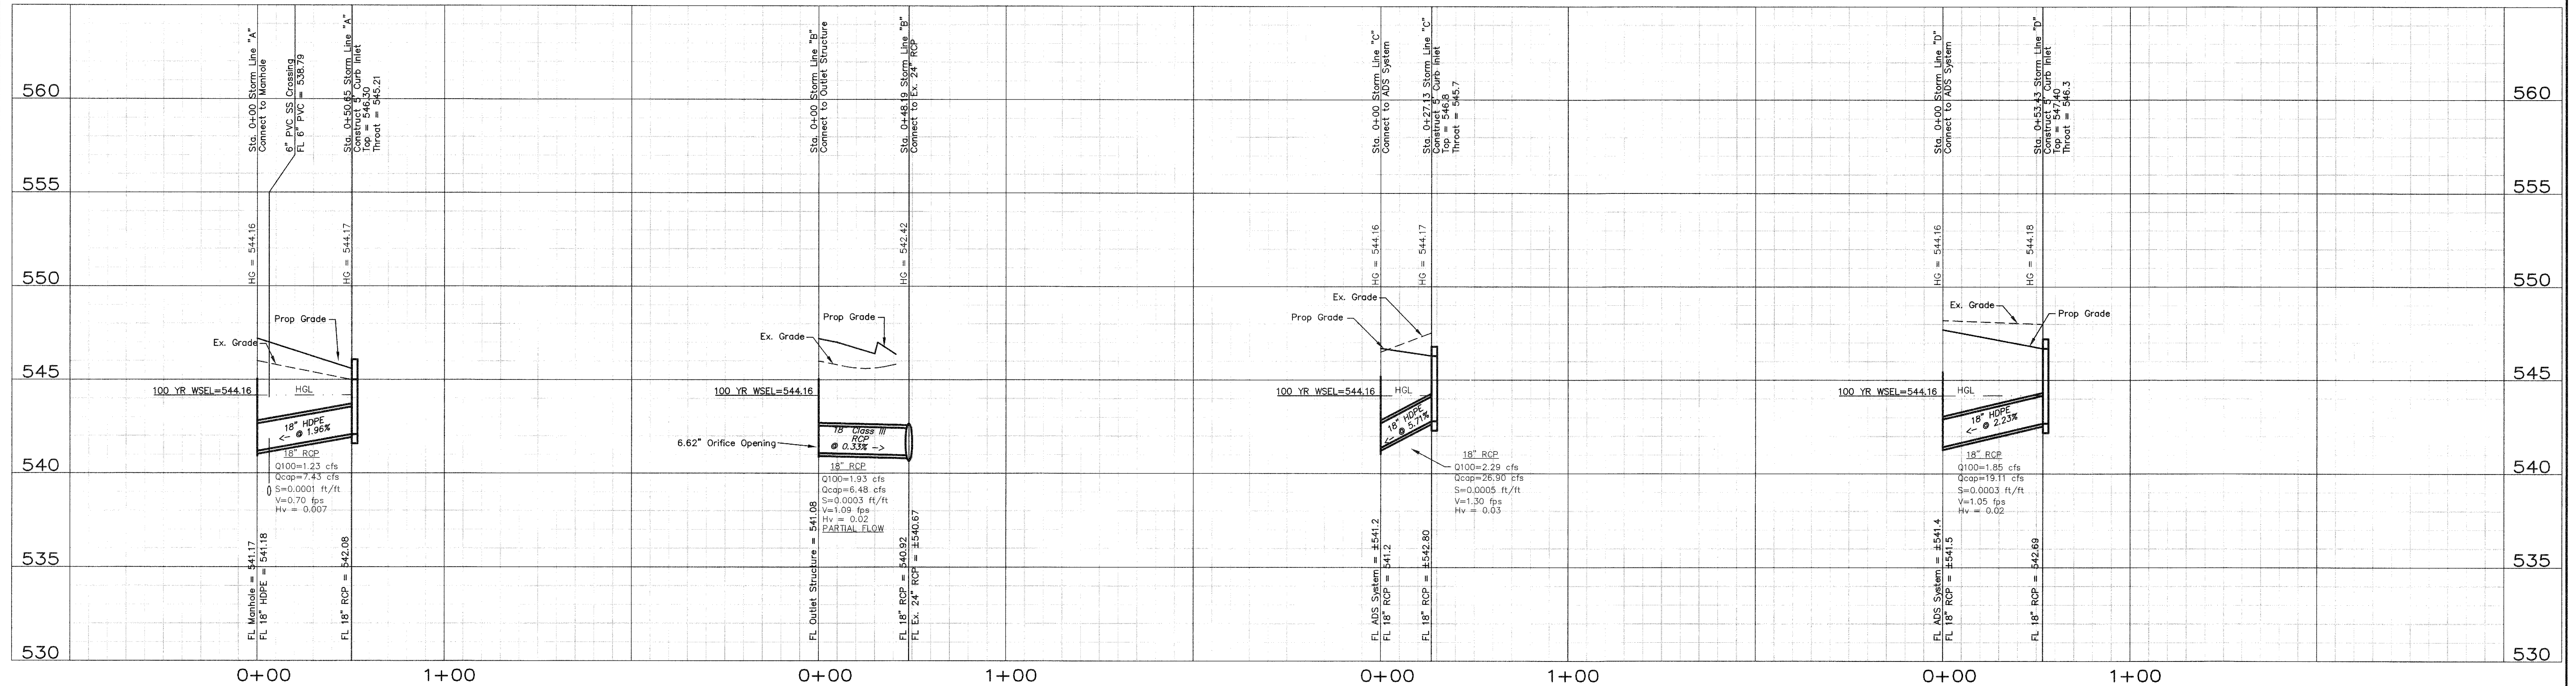


AS-BUILT DRAWINGS
 To the best of our knowledge, Cross Engineering Consultants, Inc., hereby states that this plan is As-Built. The information provided is based on surveying at the site and information provided by the contractor.
 JON DAVID CROSS, P.E.
 2/22/2012
 DATE

Issue Dates:	Revisions:	Date:
1 4/22/11	1 Water	6/14/11
2	2 Grd & SW	8/31/11
3	3	
4	4	
5	5	
6	6	

CROSS ENGINEERING CONSULTANTS
 106 W. Louisiana Street • McKinney, Texas 75069
 972.562.4409 • Texas P.E. Firm No. F-5935

Drawn By: C.E.C.I. Checked By: J.D.C. Scale: H: 1"=40' V: 1"=4'

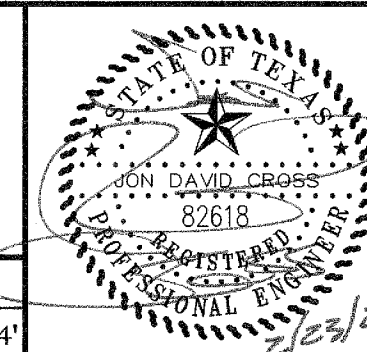

PLAN & PROFILE
 CHRISTIAN BROTHERS - ROCKWALL
 Rockwall Market Center South Addition
 CITY OF ROCKWALL, TEXAS

Sheet No.
C5
 of 8
 Project No.
 11014

PLAN & PROFILE
 CHRISTIAN BROTHERS AUTOMOTIVE