


JULIAN V. JONES TRUSTEE
 % RAYMOND CAMERON

NOTE:
 It is the responsibility of the Contractor to notify all utility companies and verify all existing utilities prior to the start of construction.



SANITARY SEWER MAIN						
ROCKWALL CHURCH ON THE ROCK INC.						
WATER UTILITIES DEPT.						
CITY OF ROCKWALL, TEXAS						
DESIGN	DRAWN	DATE	SCALE	NOTES	FILE	NO.
DAT	DAT	2-81	1"=40'H 1"=6'V	DAT	Rockwall Surveys	4 4

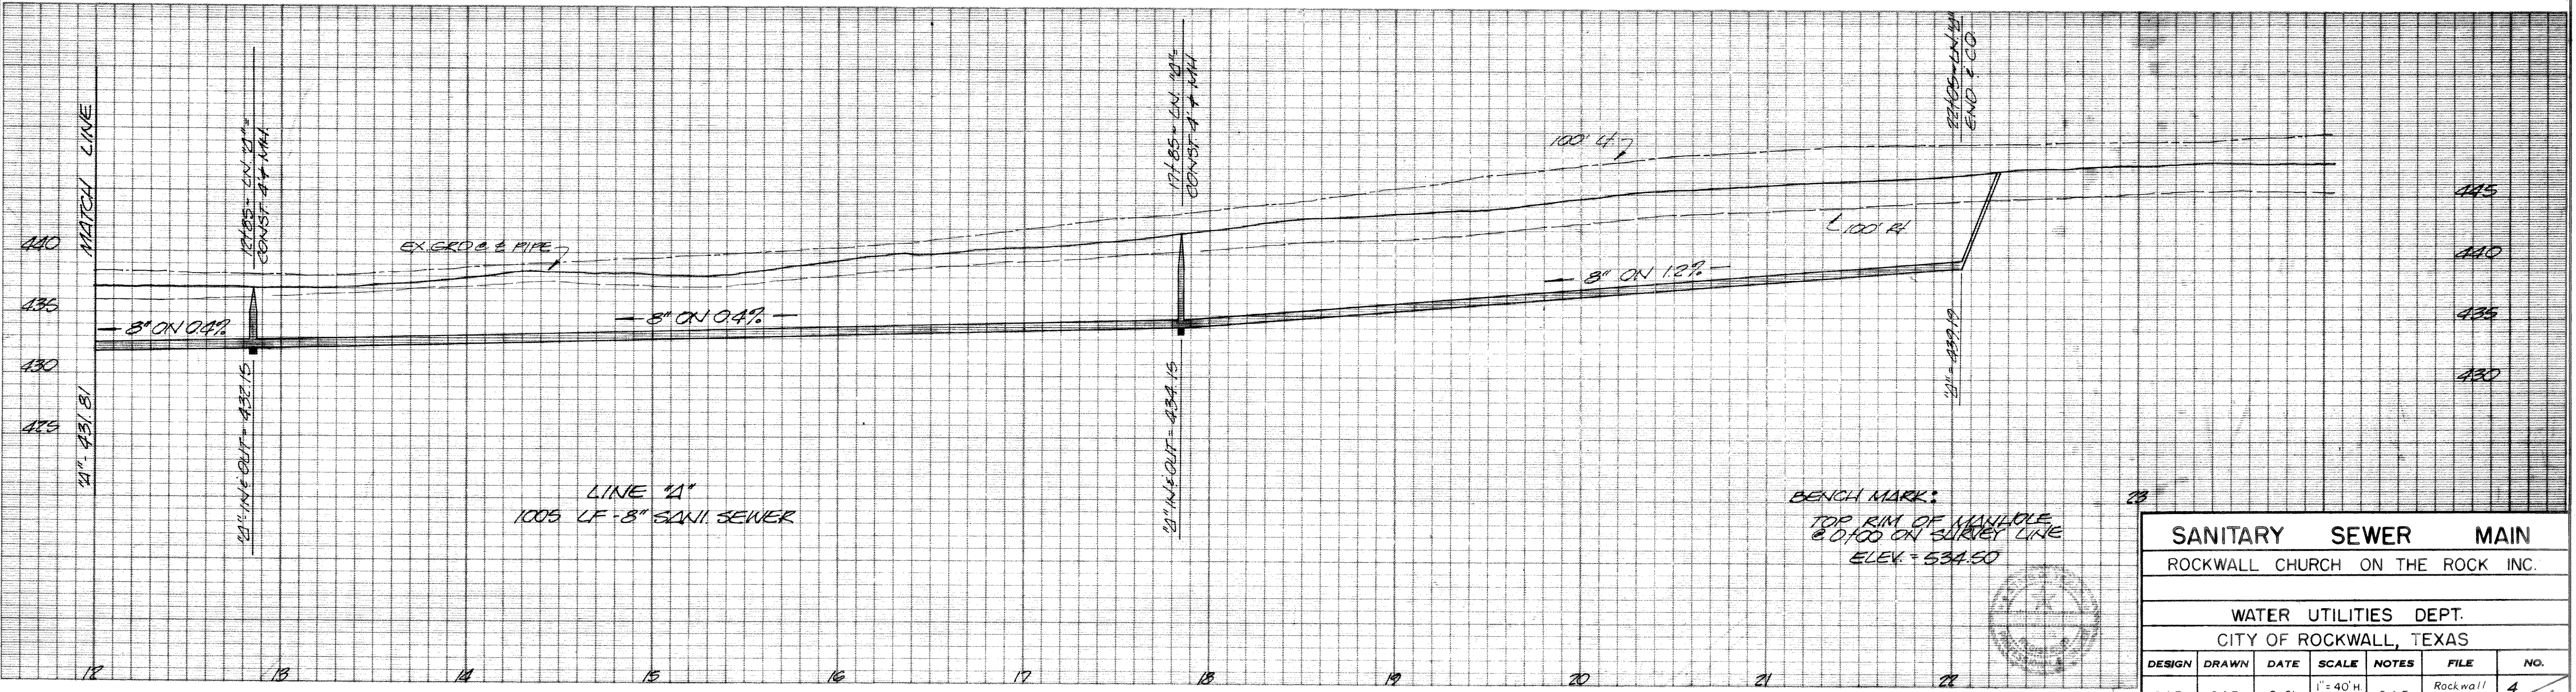