

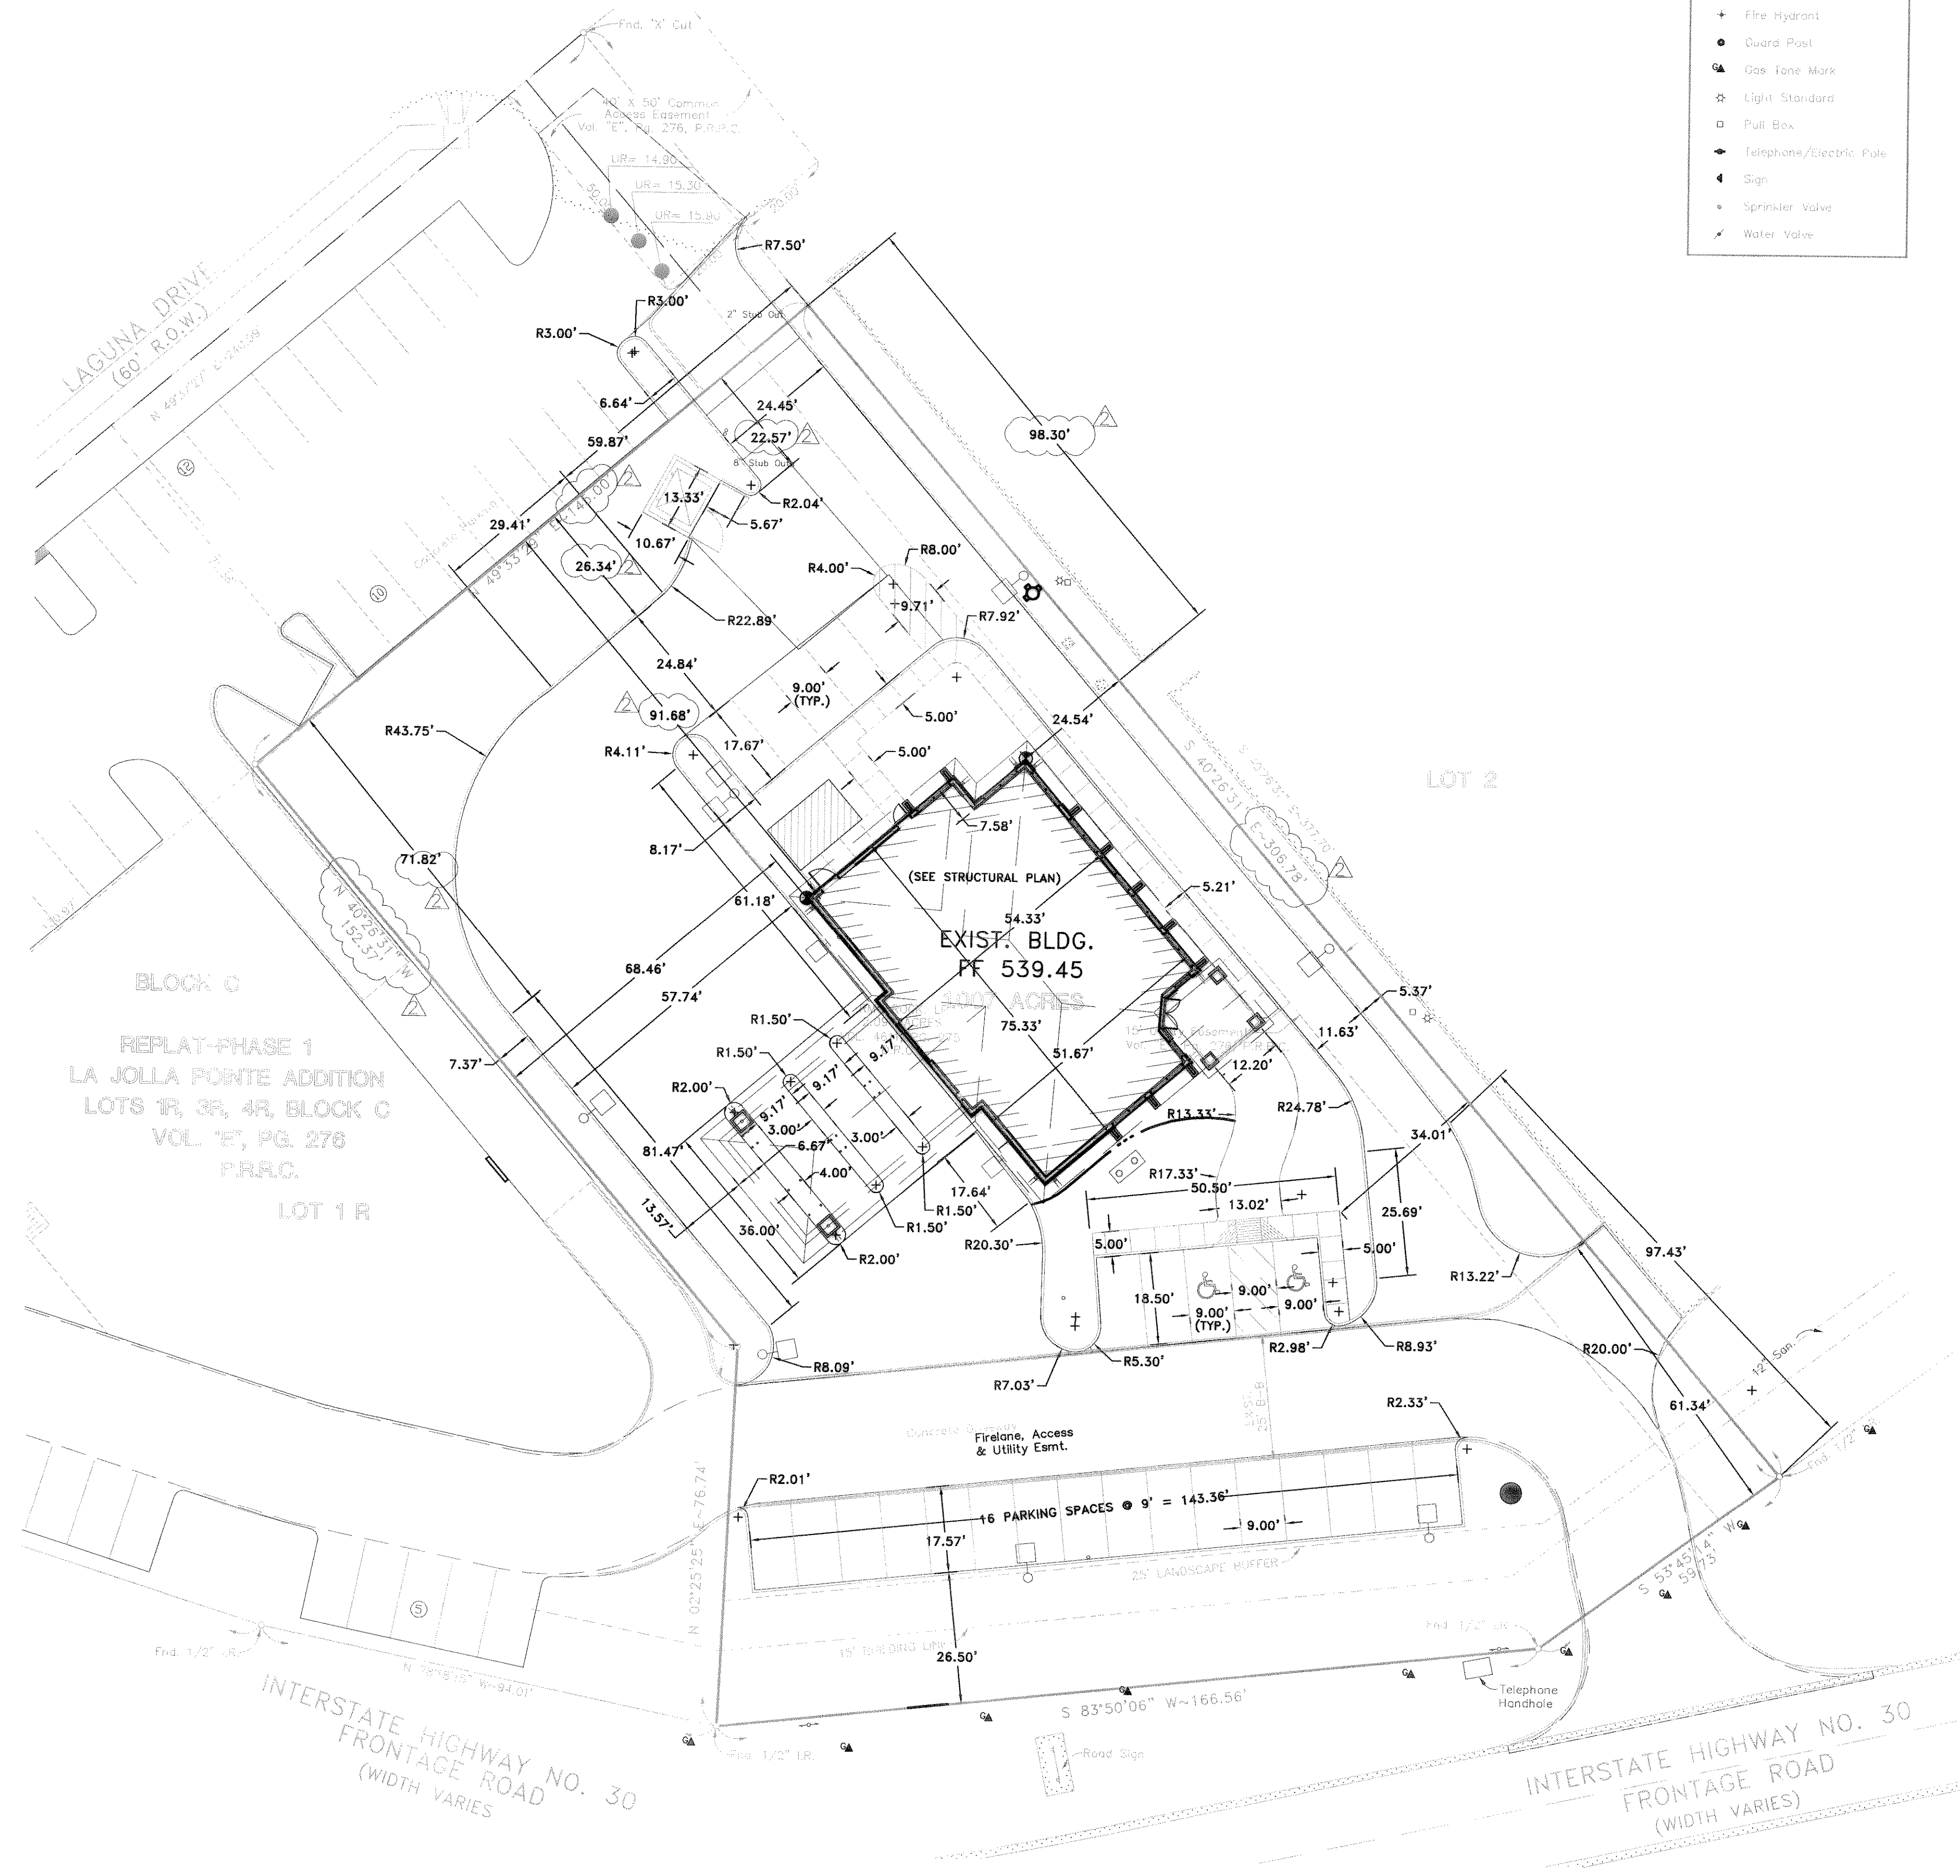


CFA No. 06071180001; 10/15/2007 09:12:14 AM

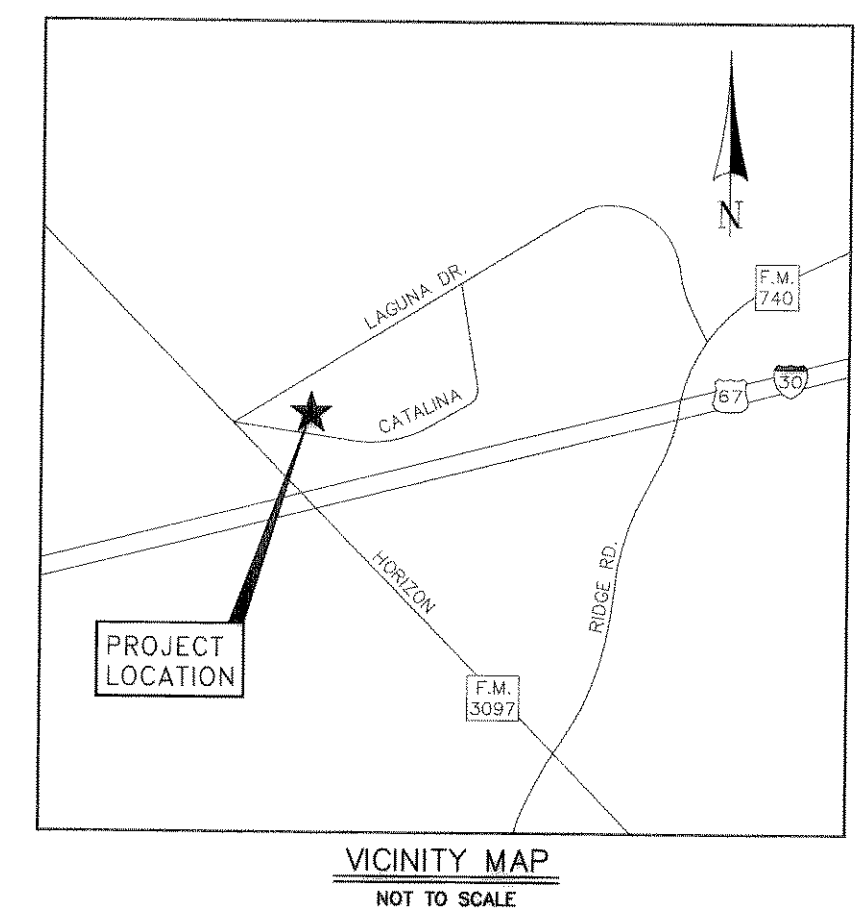

LEGEND	
⊙	Anchor
⊙	Telephone Cable Marker
+	Fire Hydrant
⊙	Guard Post
⊙	Gas Line Mark
⊙	Light Standard
⊙	Pull Box
⊙	Telephone/Electric Pole
⊙	Sign
⊙	Sprinkler Valve
⊙	Water Valve

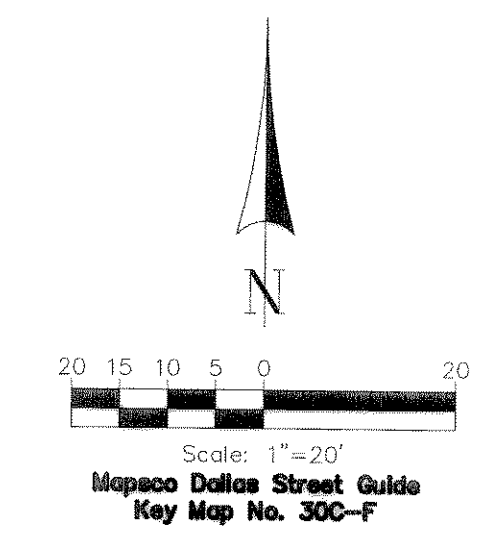

⊙ EXIST. BUILDING CORNER LOCATION

ALL DIMENSIONS SHOWN ARE FROM THE FACE OF CURB UNLESS SPECIFICALLY OTHERWISE NOTED.

RS&H
Architectural, Engineering, Planning and Environmental Services


Reynolds, Smith and Hills, Inc.
11011 Richmond Ave. Suite 700
Houston, Texas 77042
713-914-4455 FAX 713-914-0155
www.rsandh.com
FL Cert. Nos. AAC001886 • EB0005620 • LCC000210

COLONIAL BANK

ROCKWALL BRANCH

1-30 W & LAGUNA DR.
ROCKWALL, TX 75087

3500L_WESTERN

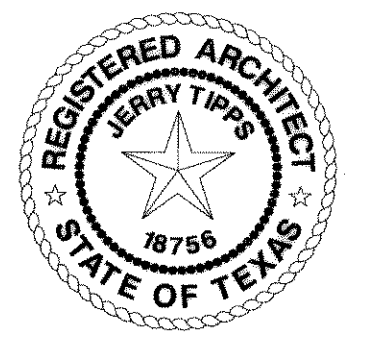


REVISIONS		
NO.	DESCRIPTION	DATE
	BID/PERMIT ISSUE	7-16-07
Δ	DIMENSION CONTROL	01-02-08
	AS-BUILT	07-02-08

DATE ISSUED: 04-13-07
REVIEWED BY: RR
DRAWN BY: MH
DESIGNED BY: RR/MH

AEP PROJECT NUMBER
512-6041-021

© 2006 REYNOLDS, SMITH AND HILLS, INC.

RECORD DRAWINGS

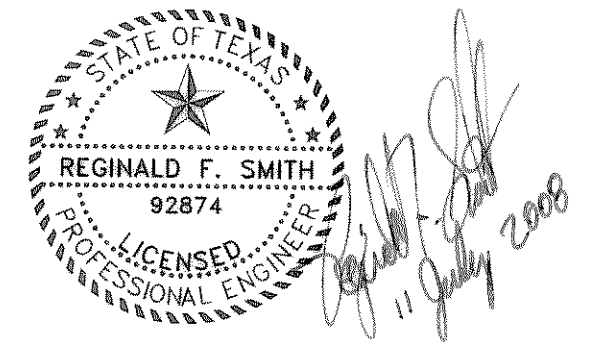

PLANS PREPARED BY
COBB, FENDLEY & ASSOC. INC.
10945 ESTATE LANE, SUITE 308
DALLAS, TEXAS 75238 (214) 349-4300
JOB NO. 0607118 CFA DWG. NO. 060711800C2

DIMENSIONED CONTROL PLAN

SHEET NUMBER

CO