




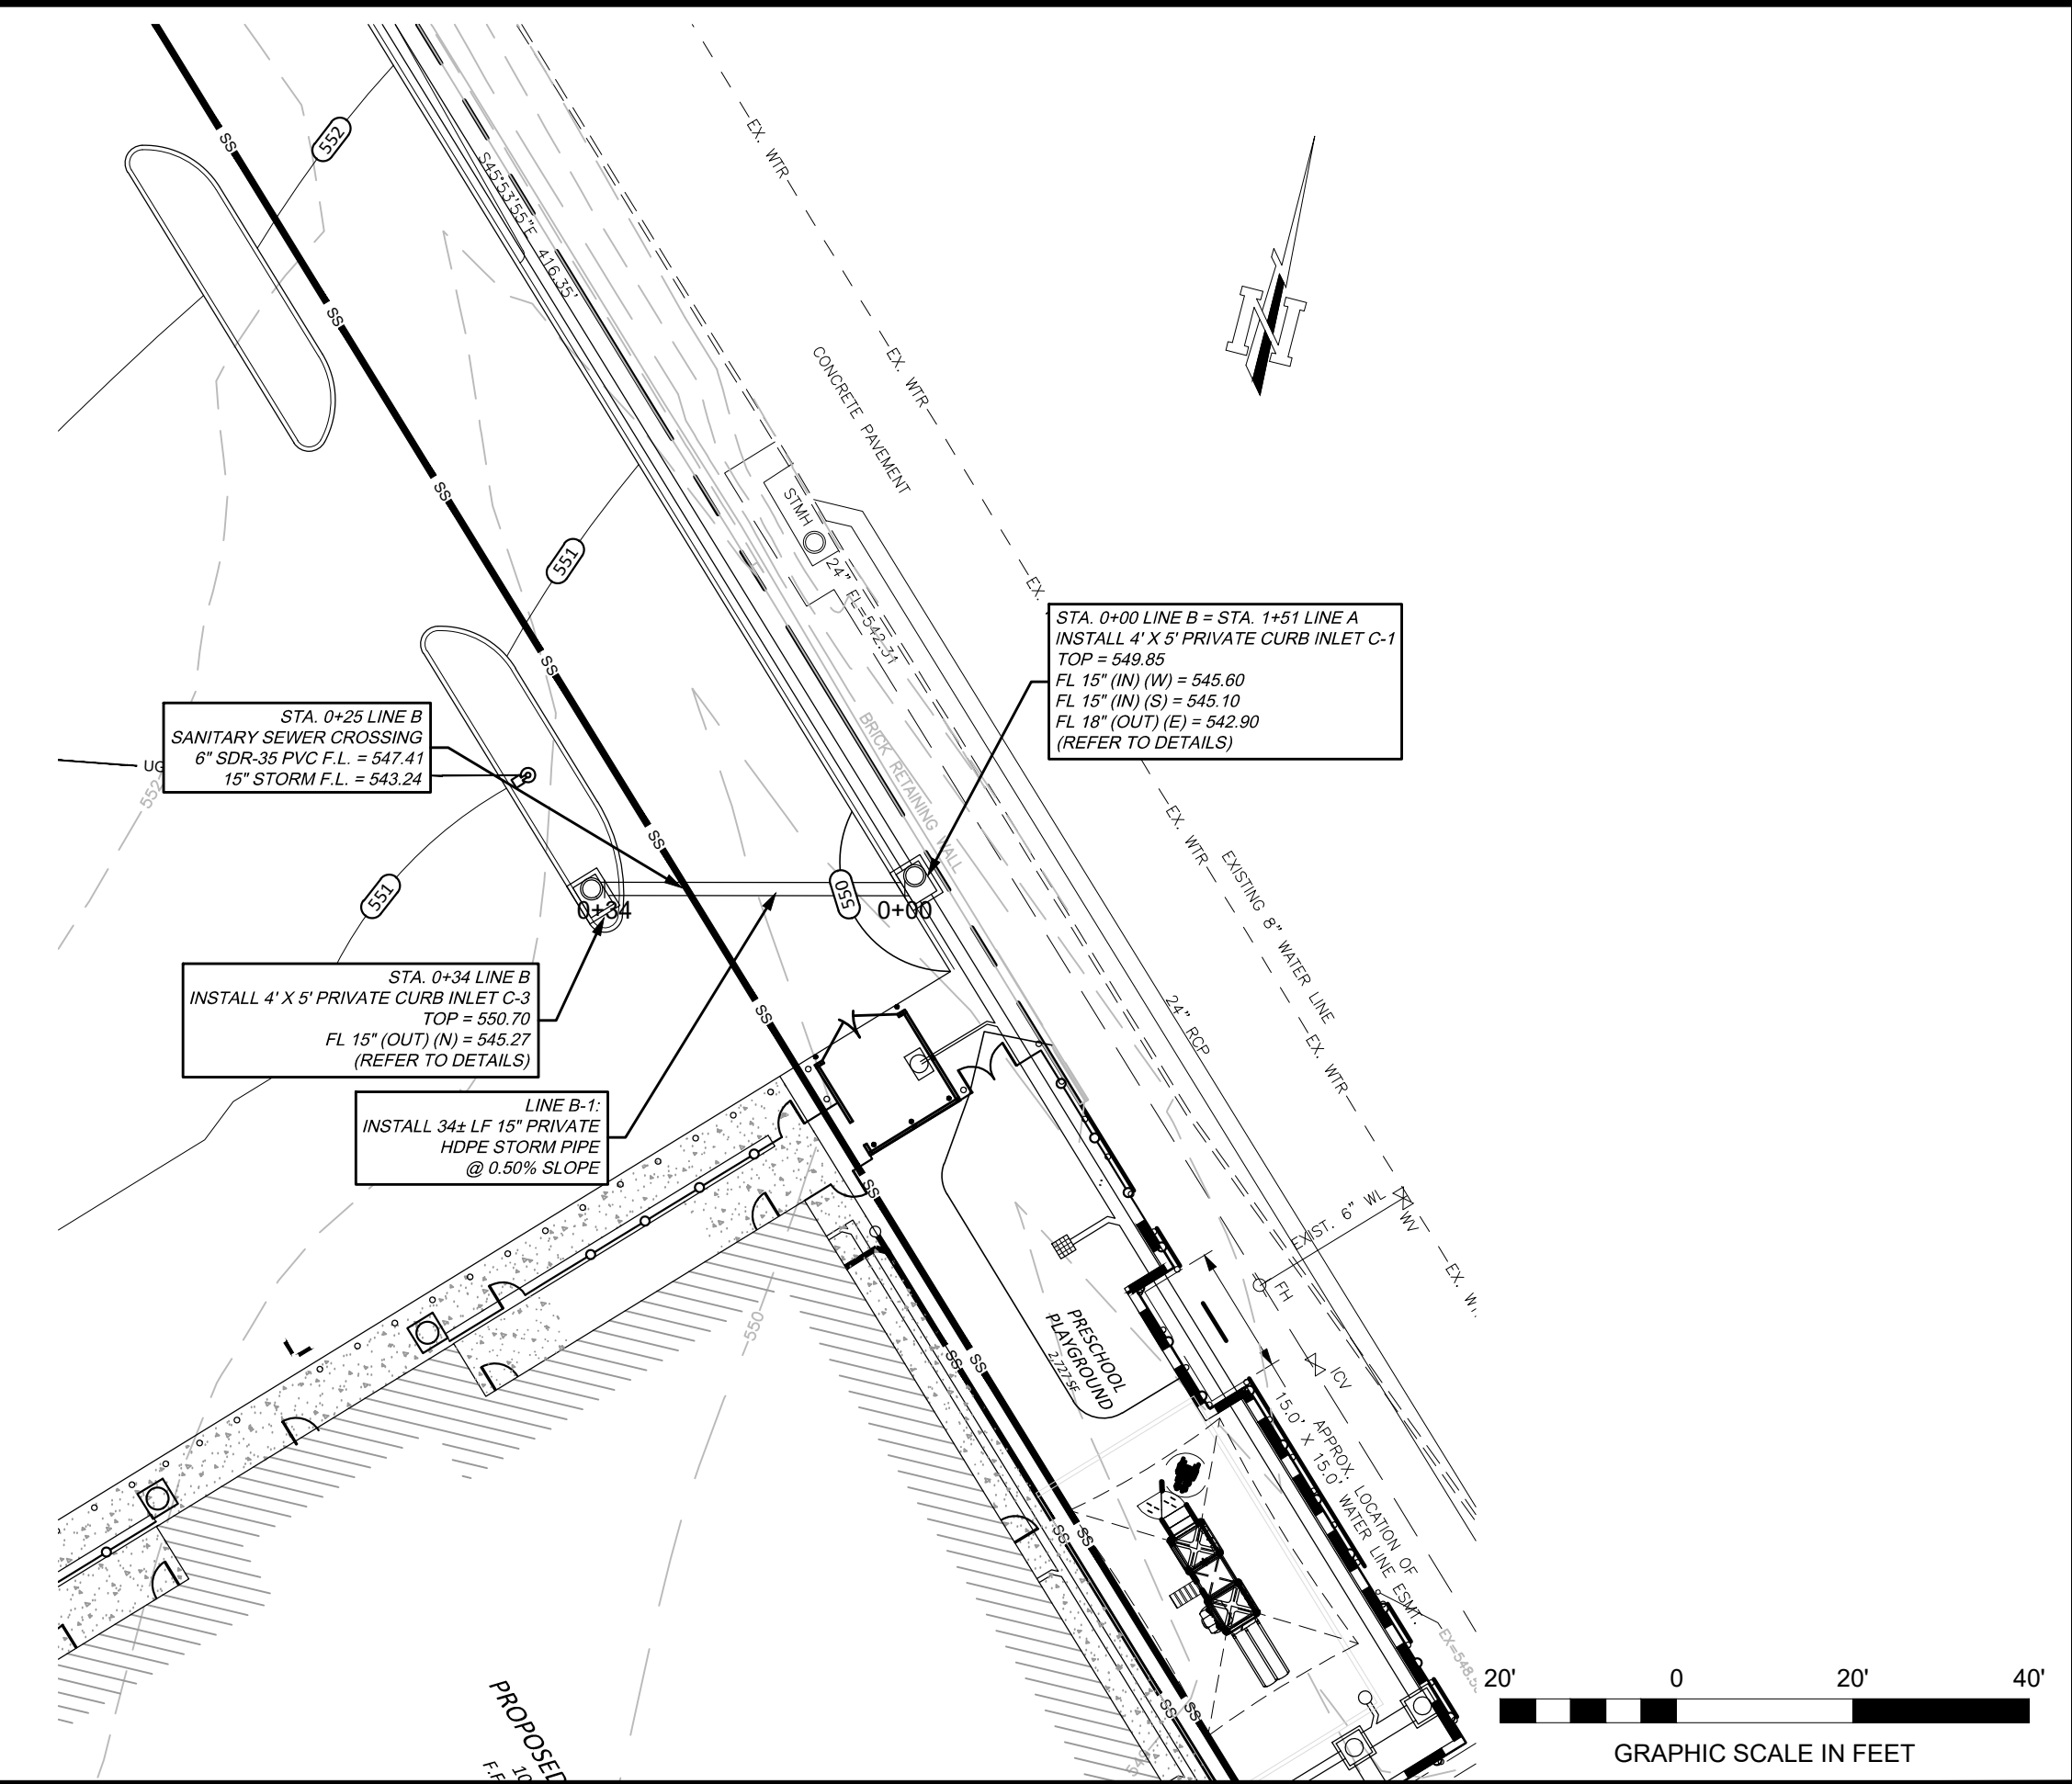


Know what's below.  
Call before you dig.

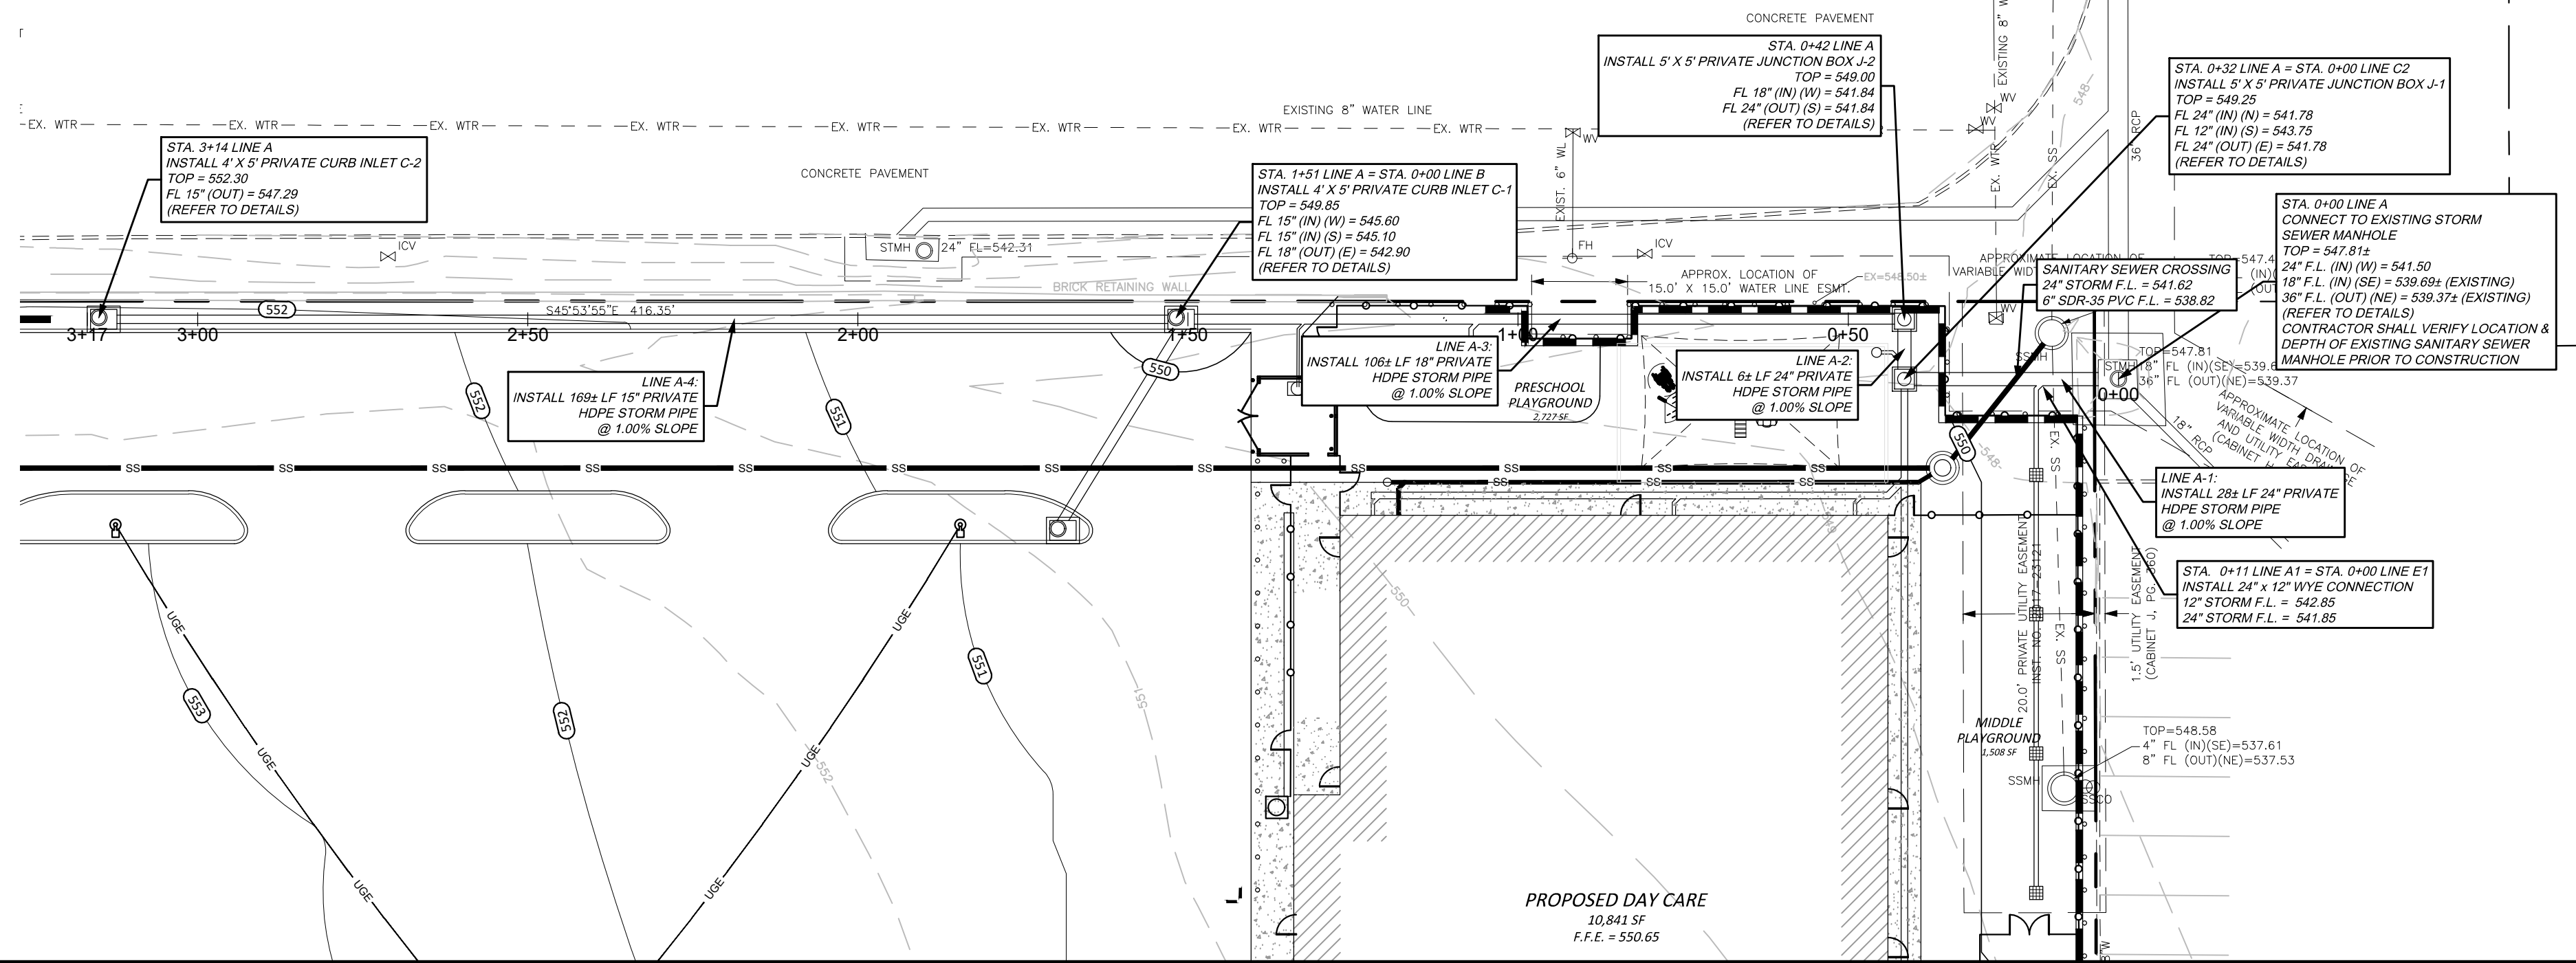

### LINE A

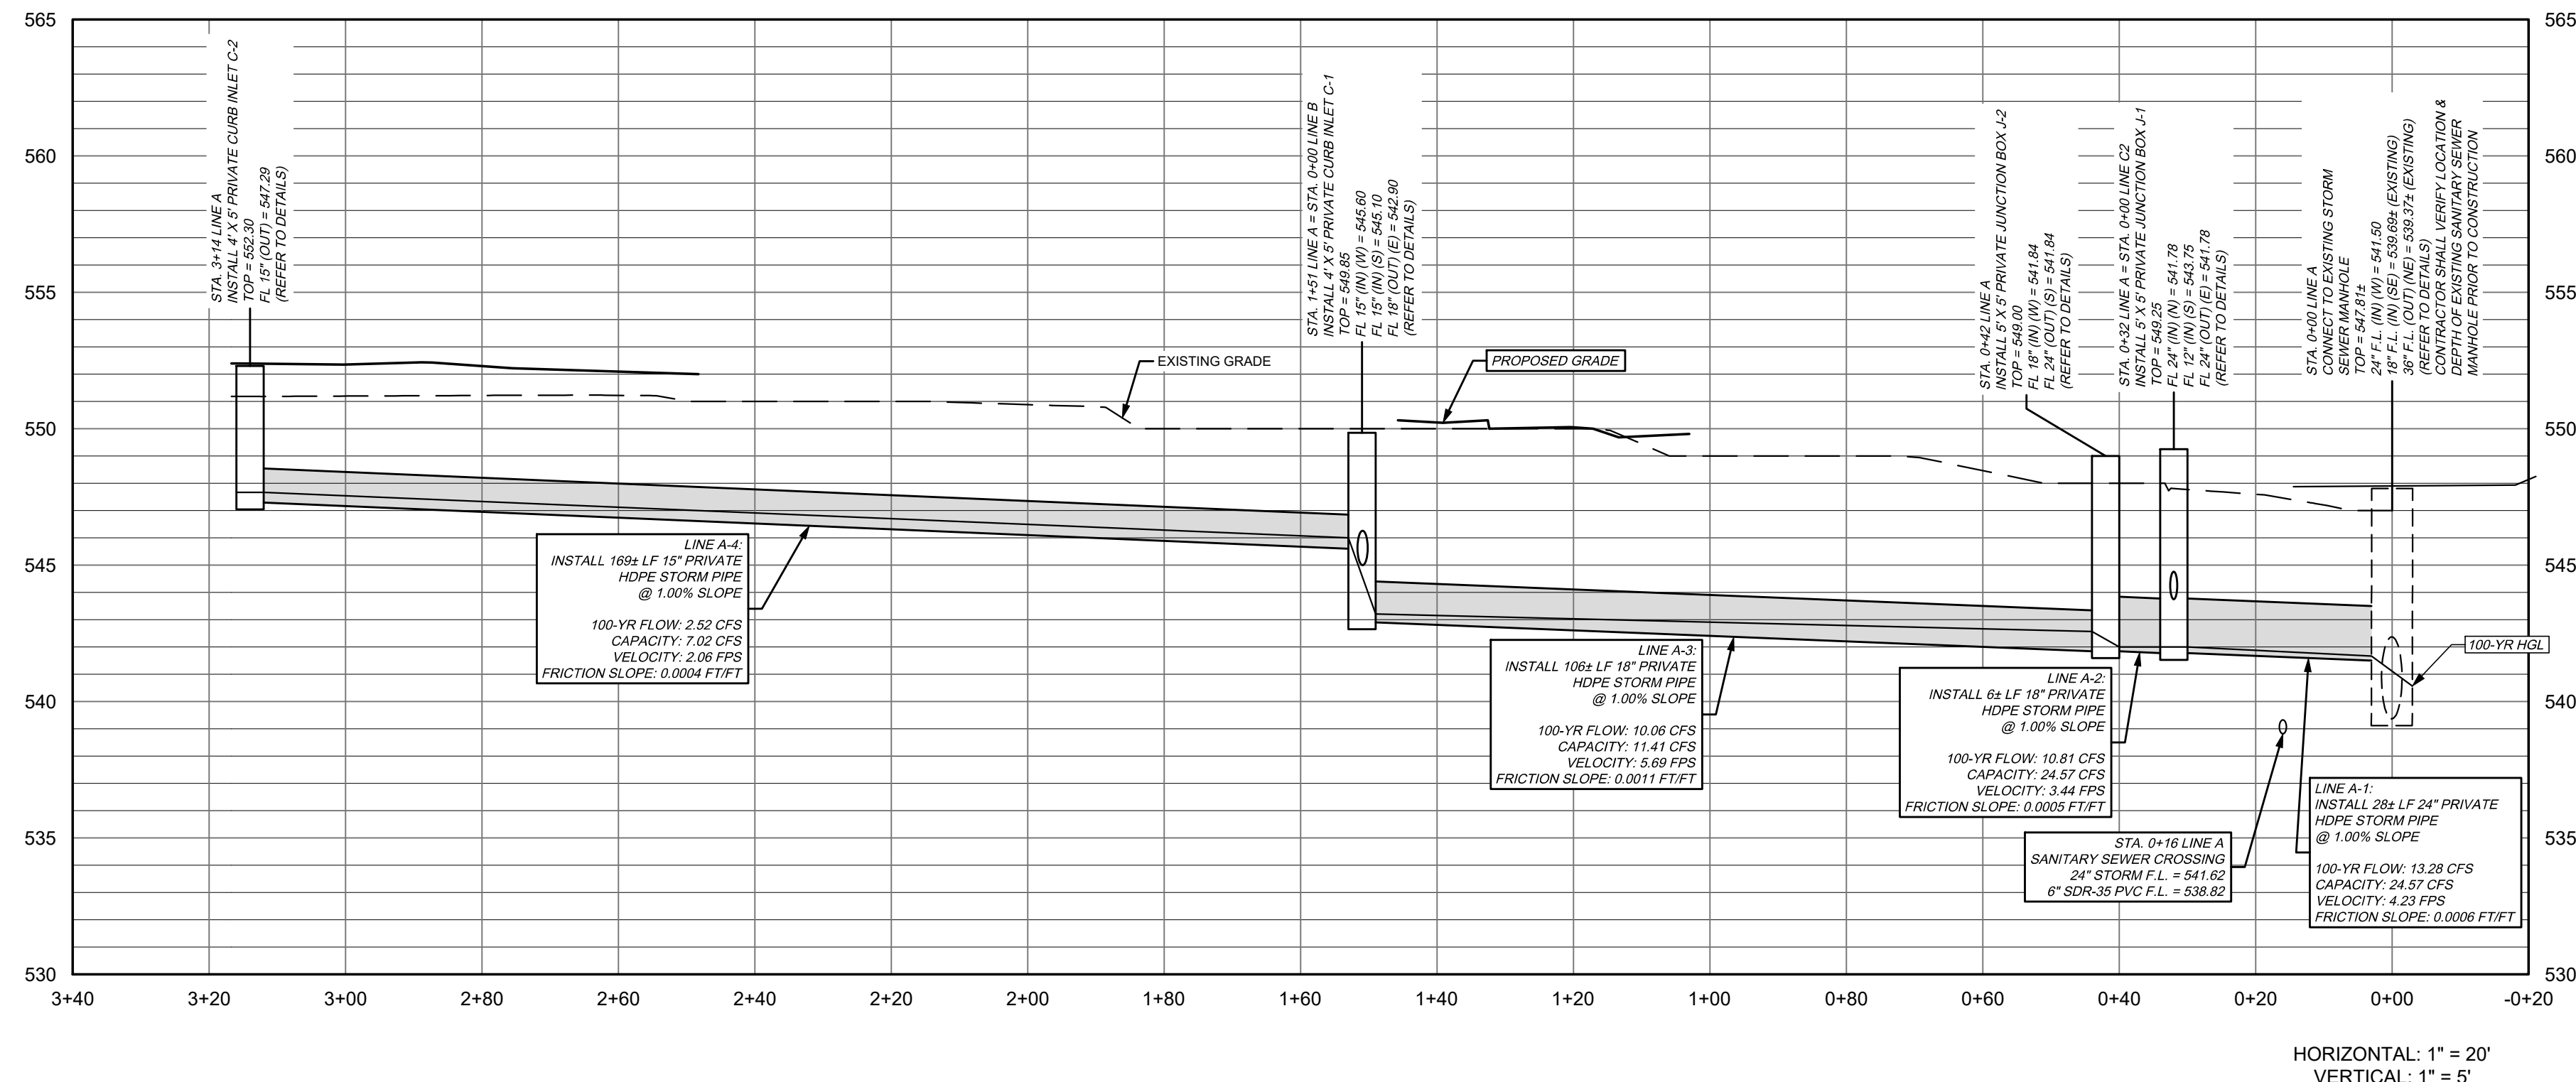

### LINE B

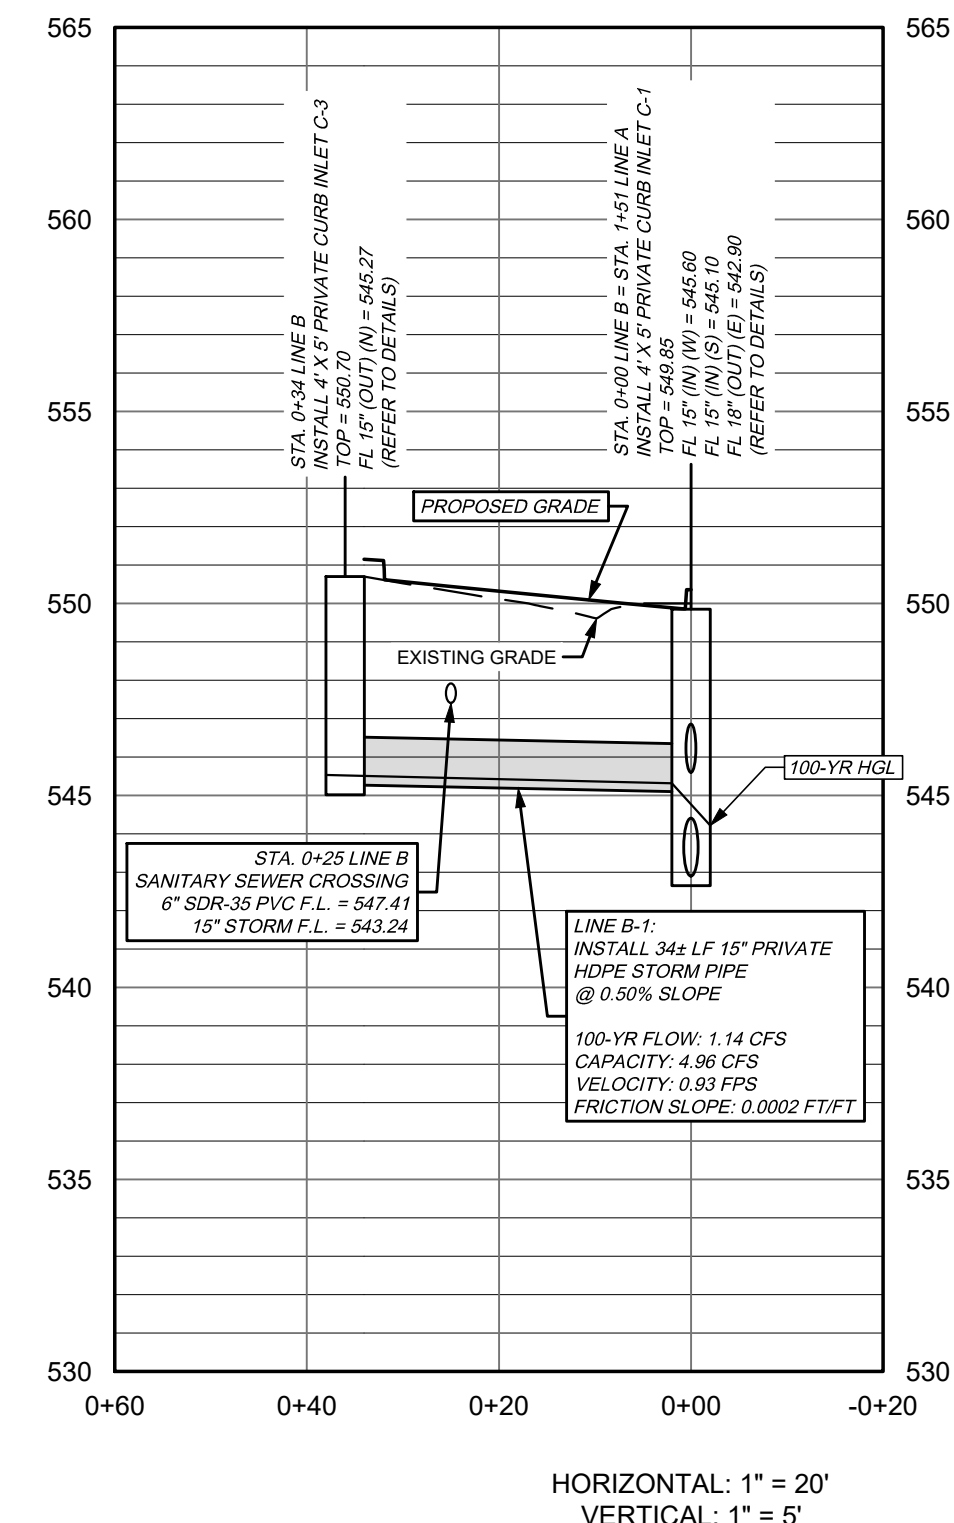

**FINAL AS-BUILT  
RECORD PLANS**

TO THE BEST OF OUR KNOWLEDGE, KSA, HEREBY STATES  
THAT THIS PLAN IS AS-BUILT. THIS INFORMATION  
PROVIDED IS BASED ON SURVEYING AT THE SITE AND  
INFORMATION PROVIDED BY THE CONTRACTOR.

NO.	REVISION	DATE
5		
4		
3		
2		
1		

## STORM PLAN & PROFILE LINE A & LINE B

COURTIN DENTAL OFFICE  
ROCKWALL, TEXAS 75032

DRAWN BY:	TG
DESIGNED BY:	DK
LATEST REVISION:	07/20/2021
KSA JOB NO.:	18-1620-01



SEAL:  
TBPE Firm Registration No. F-1356  
SHEET NO.

C6.1