

**FINAL AS-BUILT  
RECORD PLANS**

TO THE BEST OF OUR KNOWLEDGE, KSA, HEREBY STATES THAT THIS PLAN IS AS-BUILT. THIS INFORMATION PROVIDED IS BASED ON SURVEYING AT THE SITE AND INFORMATION PROVIDED BY THE CONTRACTOR.

**811**  
Know what's below.  
Call before you dig.

**LINE C2 & D1**

**LINE C1**


NO.	REVISION	DATE
5		
4		
3		
2		
1		

**STORM PLAN & PROFILE LINE  
C & LINE D**

**COURTIN DENTAL OFFICE  
ROCKWALL, TEXAS 75032**

DRAWN BY:	TG
DESIGNED BY:	DK
LATEST REVISION:	07/20/2021
KSA JOB NO.:	18-1620-01

**KSA**  
678 Oak-Hill Blvd.,  
Rockwall, Texas 75087  
T. 972.592.8800  
www.ksaeng.com

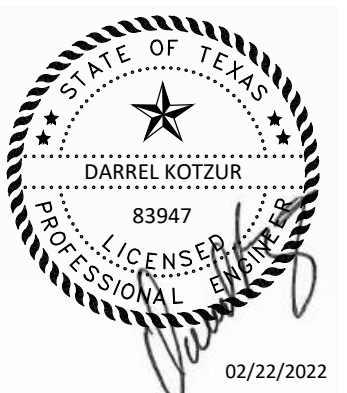

SEAL:  
TBPE Firm Registration No. F-1356  
SHEET NO.

**C6.2**