



DIRECTIONAL CURB RAMP


CITY OF ROCKWALL


MAR. '17 R-2125B

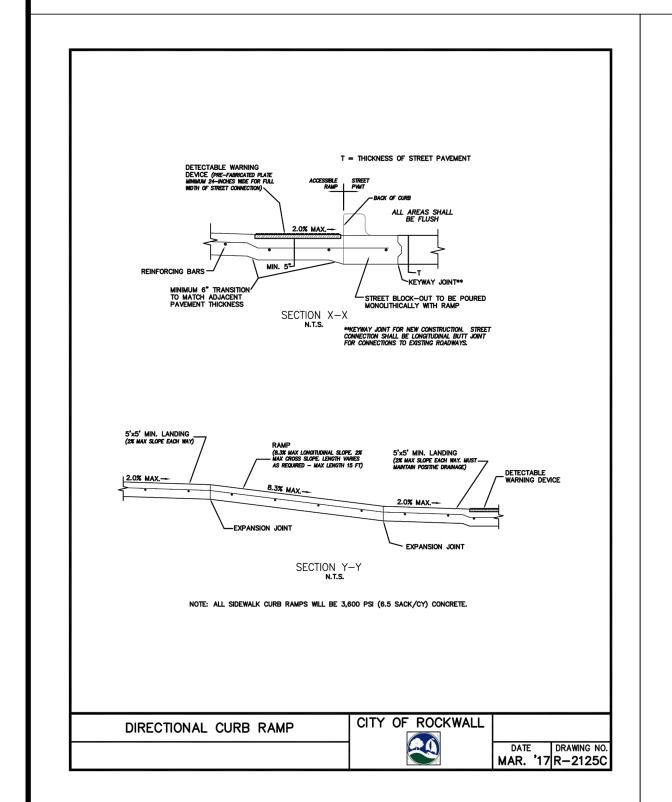

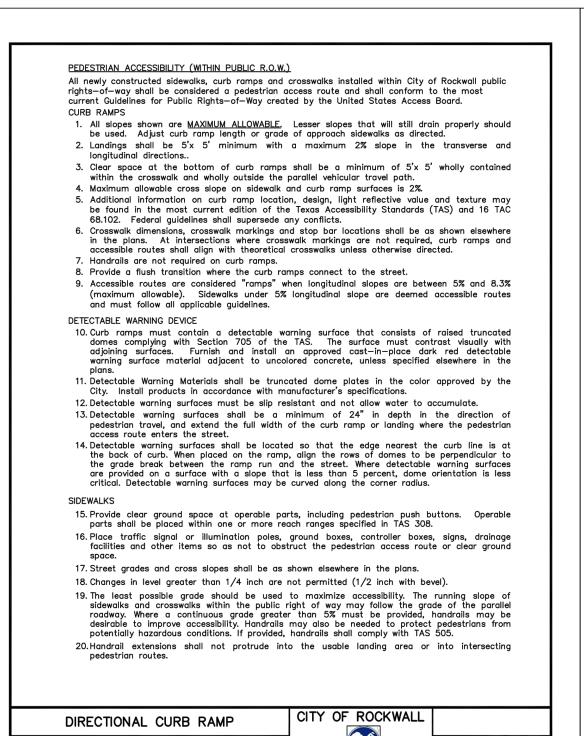


MAR. '17 R-2125D

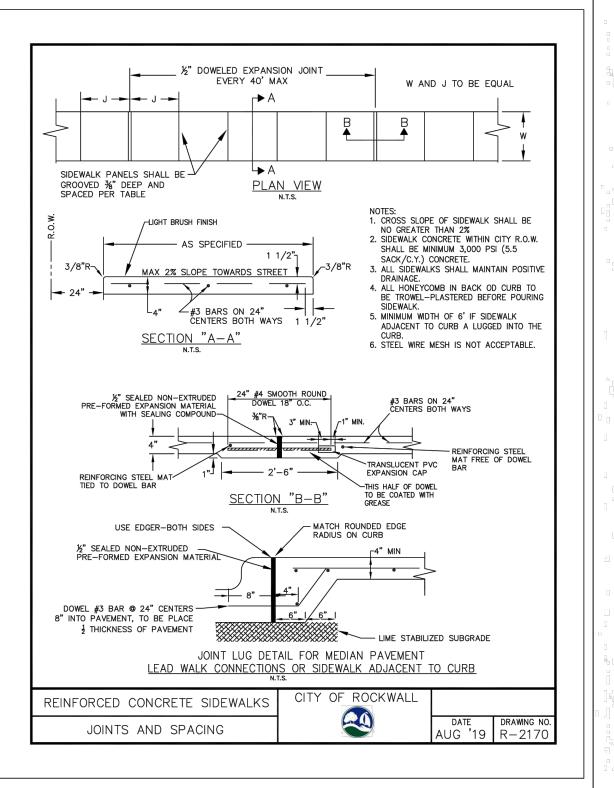

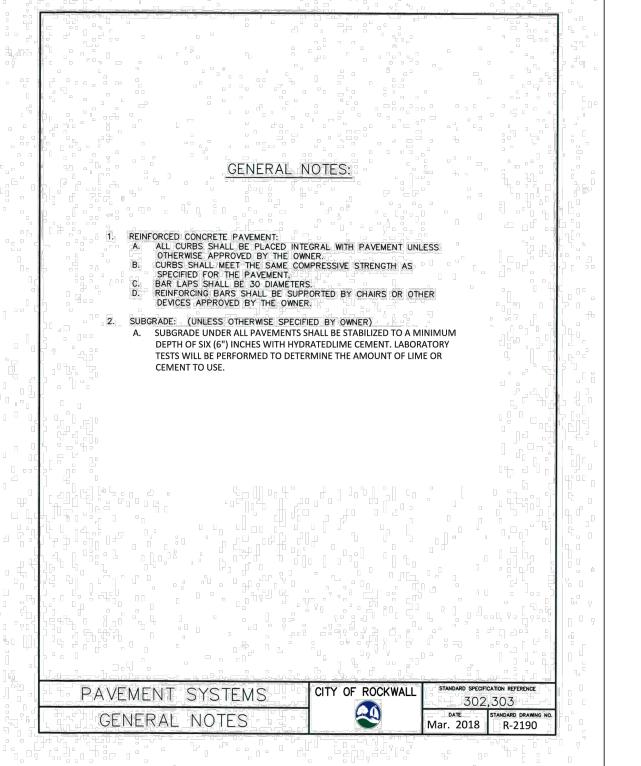



TO THE BEST OF OUR KNOWLEDGE, KSA, HEREBY STATES THAT THIS PLAN IS AS-BUILT. THIS INFORMATION PROVIDED IS BASED ON SURVEYING AT THE SITE AND INFORMATION PROVIDED BY THE CONTRACTOR.

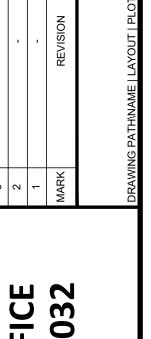

COURTIN DENTAL OFFICE ROCKWALL, TEXAS 750

CITY OF ROCKWALL DETAILS

7/20/2021 SA JOB NO.:

ill Blvd., ss 75703 ; 888-224-9418 ng.com

DARREL KOTZUR

83947

02/22/2022

SEAL:
TBPE Firm Registration No. F-1356

C9.1