



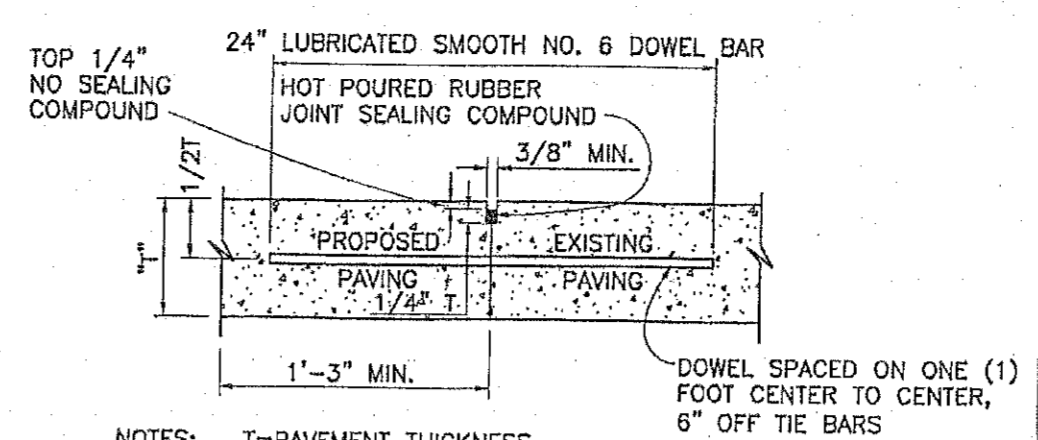

GRAPHIC SCALE  
VERTICAL AND HORIZONTAL  
1"=20' FOR 24" X 36" PLANS

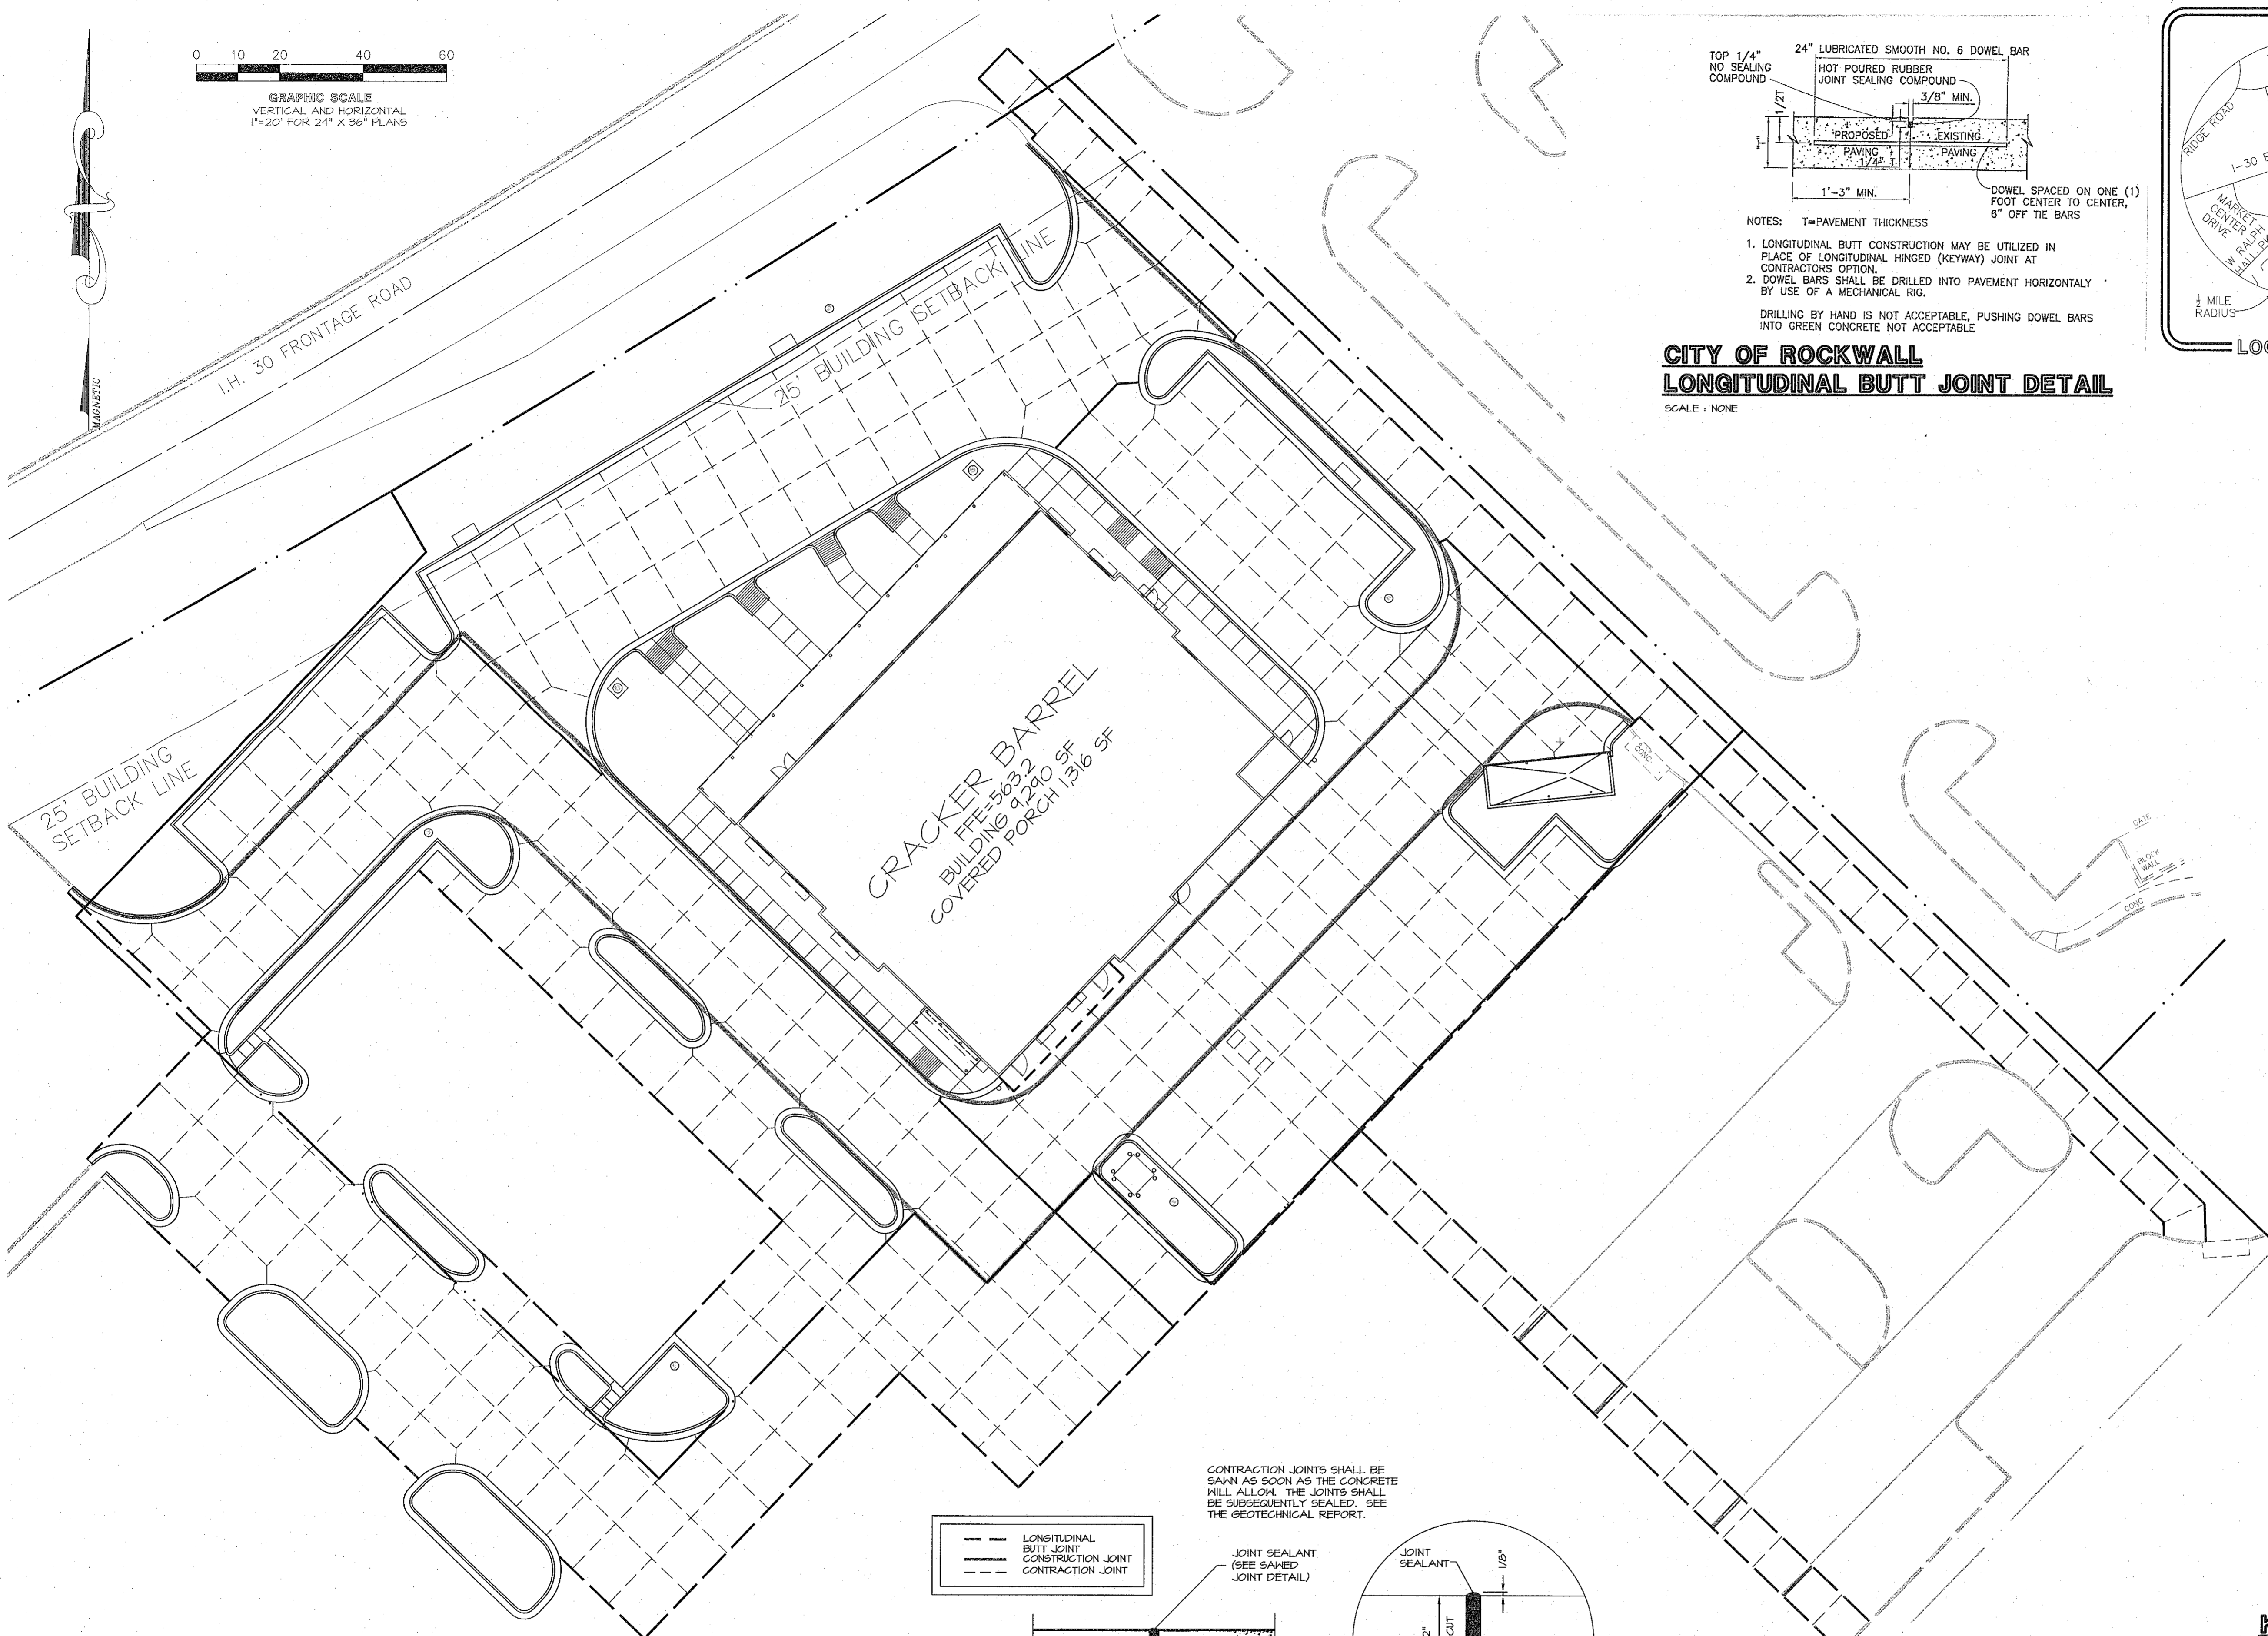


NOTES: T=PAVEMENT THICKNESS

- LONGITUDINAL BUTT CONSTRUCTION MAY BE UTILIZED IN PLACE OF LONGITUDINAL HINGED (KEYWAY) JOINT AT CONTRACTOR'S OPTION.
- DOWEL BARS SHALL BE DRILLED INTO PAVEMENT HORIZONTALLY BY USE OF A MECHANICAL RIG.

DRILLING BY HAND IS NOT ACCEPTABLE, PUSHING DOWEL BARS INTO GREEN CONCRETE NOT ACCEPTABLE.

**CITY OF ROCKWALL  
LONGITUDINAL BUTT JOINT DETAIL**

SCALE: NONE

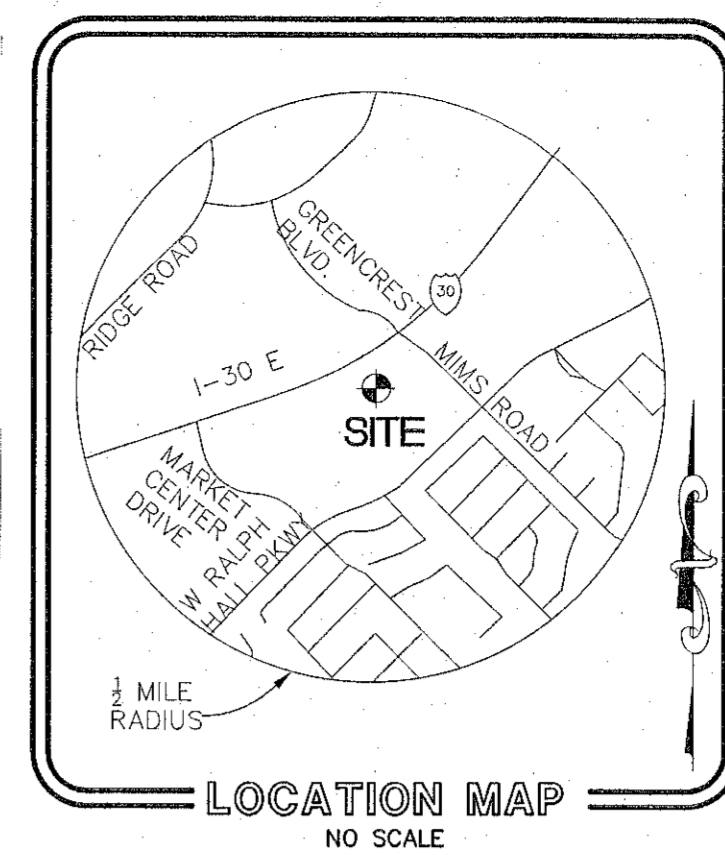

**LEGEND**


EXISTING	PROPOSED
CONTOUR	SPOT EL.
SS - SANITARY SEWER	STORM SEWER
MANHOLE	CLEAN OUT
N/A	WATER LINE
OC - OVERHEAD ELEC.	N/A
N/A	UNDERGROUND ELEC.
UG - UNDERGROUND GAS	N/A
CBQ	CATCH BASIN
GV	GATE VALVE
FH	FIRE HYDRANT
UP	UTILITY POLE
LP	LIGHT POLE
N/A	PARKING COUNT

SPOT ELEVATION ABBREVIATIONS:  
 TC - TOP OF CURB  
 FL - FLOW LINE  
 TR - TOP OF RAMP  
 BR - BOTTOM OF RAMP  
 TLIP - TOP OF CONCRETE LIP  
 BLIP - BOTTOM OF CONCRETE LIP

CRACKER BARREL PROJECT NUMBER: CB 164 ROCKWALL, TX-03  
**CRACKER BARREL  
OLD COUNTRY STORE, INC.**  
 845 EAST INTERSTATE 30  
 ROCKWALL, TEXAS 75087

This construction documents are the exclusive property of Cracker Barrel Old Country Store, Inc. No part of these drawings reproduced without written permission of Cracker Barrel Old Country Store, Inc.

**Cracker Barrel**  
 P.O. Box 787  
 Hartmann Drive, Lebanon, TN 37087

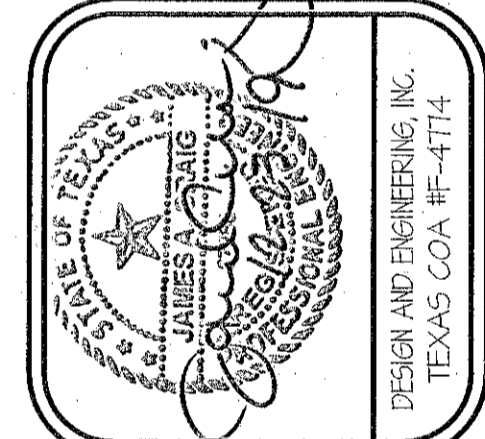

1445 Westgate Circle  
 Brentwood, TN 37027  
 615-370-1777  
 Fax: 370-9106  
 www.gberinc.com

**DESIGN and ENGINEERING**  
**G B E R INC**  
 STRUCTURAL AND CIVIL ENGINEERS

DATE: 12-16-14  
 PROJECT NO: 11-16-15

REVISIONS




RECORD SITE PAVEMENT  
 JOINT AND FIRELANE  
 STRIPING PLAN

**RC-1A**  
 PROTO 176-14F

**CAUTION**


THE UTILITIES SHOWN ARE SHOWN FOR THE CONTRACTOR'S CONVENIENCE ONLY. THERE MAY BE OTHER UTILITIES NOT SHOWN ON THESE PLANS. THE ENGINEER ASSUMES NO RESPONSIBILITY FOR THE LOCATIONS SHOWN, AND IT SHALL BE THE CONTRACTOR'S RESPONSIBILITY TO VERIFY THE LOCATIONS OF ALL UTILITIES WITHIN THE LIMITS OF THE WORK. ALL DAMAGE MADE TO EXISTING UTILITIES BY THE CONTRACTOR SHALL BE THE SOLE RESPONSIBILITY OF THE CONTRACTOR.

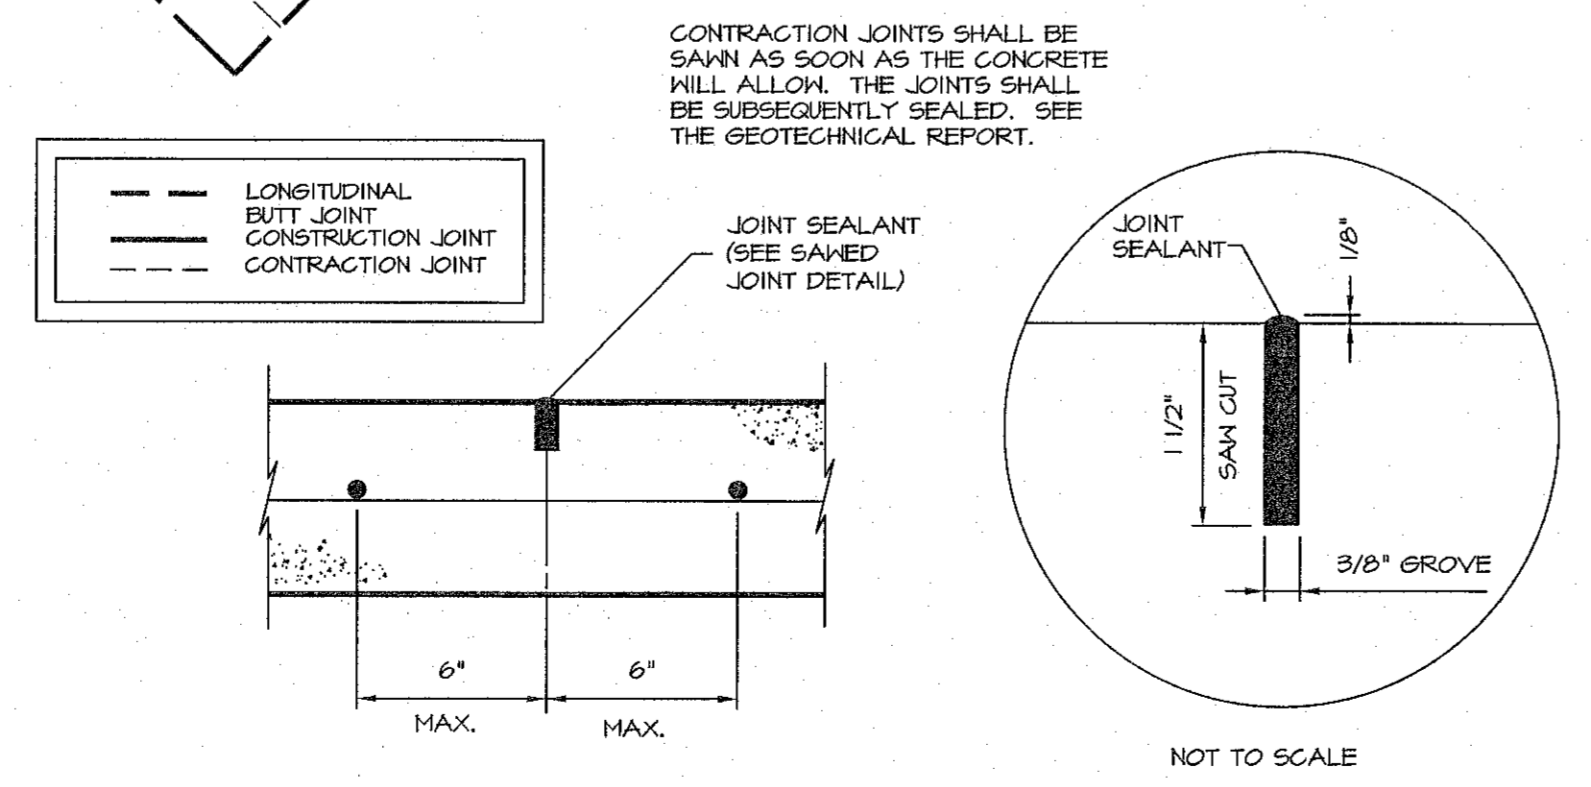

**SAW CUT CONTRACTION JOINT DETAILS**

SCALE: NONE

CONSTRUCTION JOINTS SHALL BE UNDETAILED BY A NON-NOVEN GEOTEXTILE ABOUT 2' WIDE. SEE THE GEOTECHNICAL REPORT.

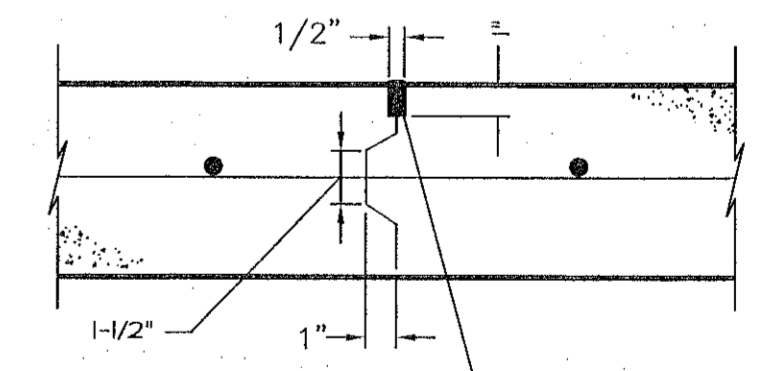

**KEYED CONSTRUCTION JOINT DETAIL**

SCALE: NONE

ALL RESPONSIBILITY FOR ADEQUACY OF DESIGN REMAINS WITH THE DESIGN ENGINEER. THE CITY OF ROCKWALL, IN REVIEWING AND RELEASING PLANS FOR CONSTRUCTION, ASSUMES NO RESPONSIBILITY FOR ADEQUACY OR ACCURACY OF DESIGN.

PROPERTY OWNER: KOHL'S ILLINOIS, INC.  
 15817OOD RIDGEWOOD DRIVE  
 MENOMONEE FALLS, WISCONSIN 53051  
 ERIC BORKENHAGEN  
 (262) 709-1000

OWNER: CBOCS TEXAS LIMITED PARTNERSHIP  
 P.O. BOX 181  
 LEBANON, TENNESSEE 37088-0181  
 TELEPHONE: (615) 444-5533

PLANS PREPARED BY: JAMES A. CRANG, P.E.  
 DESIGN AND ENGINEERING, INC.  
 1645 WESTGATE CIRCLE  
 BRENTWOOD, TENNESSEE 37021  
 (615) 370-1777

**CRACKER BARREL  
OLD COUNTRY STORE, INC.**  
 845 E. INTERSTATE 30 FRONTAGE RD.  
 ROCKWALL, TEXAS 75087  
 BLOCK A, LOT 1  
 CASE NUMBER: SP2016-028