


STORM LINE PROFILE


SCALE: 1" = 10' HORIZONTAL
1" = 5' VERTICAL

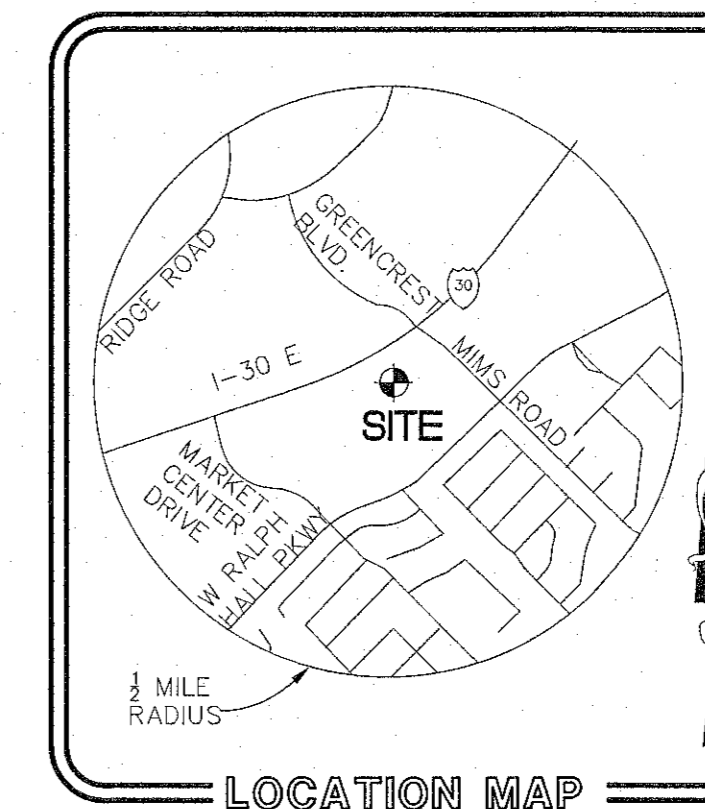

LEGEND

EXISTING	PROPOSED
	CONTOUR
	SPOT EL.*
	STORM SEWER
	SANITARY SEWER
	MANHOLE
	CLEAN OUT
	WATER LINE
	OVERHEAD ELEC.
	UNDERGROUND ELEC.
	UNDERGROUND GAS
	CATCH BASIN
	GATE VALVE
	FIRE HYDRANT
	UTILITY POLE
	LIGHT POLE
	PARKING COUNT

* SPOT ELEVATION ABBREVIATIONS:
 TG - TOP OF CURB
 FL - FLOW LINE
 TR - TOP OF RAMP
 BLIP - BOTTOM OF CONCRETE LIP
 BLIP - BOTTOM OF CONCRETE LIP

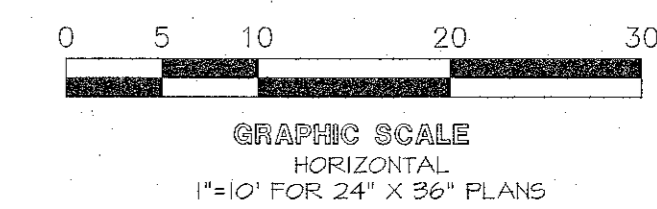

FLOOD INFORMATION:
 THIS PROPERTY IS LOCATED IN FLOOD ZONE "X"
 PER NFP FIRM COMMUNITY PANEL NO. 4839700040L
 EFFECTIVE DATE: SEPTEMBER 26, 2008

CAUTION
 THE UTILITIES SHOWN ARE SHOWN FOR THE CONTRACTOR'S CONVENIENCE ONLY. THERE MAY BE OTHER UTILITIES NOT SHOWN ON THESE PLANS. THE ENGINEER ASSUMES NO RESPONSIBILITY FOR THE LOCATIONS SHOWN, AND IT SHALL BE THE CONTRACTOR'S RESPONSIBILITY TO VERIFY THE LOCATIONS OF ALL UTILITIES WITHIN THE LIMITS OF THE WORK. ALL DAMAGE MADE TO EXISTING UTILITIES BY THE CONTRACTOR SHALL BE THE SOLE RESPONSIBILITY OF THE CONTRACTOR.

ALL RESPONSIBILITY FOR ADEQUACY OF DESIGN REMAINS WITH THE DESIGN ENGINEER, THE CITY OF ROCKWALL, IN REVIEWING AND RELEASING PLANS FOR CONSTRUCTION, ASSUMES NO RESPONSIBILITY FOR ADEQUACY OR ACCURACY OF DESIGN.

PROPERTY OWNER: KOHL'S ILLINOIS, INC.
 18641000 RIDGEWOOD DRIVE
 MENOMONEE FALLS, WISCONSIN 53051
 ERIC BORKENHAGEN
 (262) 703-1000

OWNER: CBOGS TEXAS LIMITED PARTNERSHIP
 P.O. BOX 181
 LEBANON, TENNESSEE 37088-0181
 TELEPHONE: (615) 444-5533


PLANS PREPARED BY: JAMES A. CRAIG, P.E.
 DESIGN AND ENGINEERING, INC.
 1645 WESTGATE CIRCLE
 BRENTWOOD, TENNESSEE 37027
 (615) 370-1779

CRACKER BARREL
OLD COUNTRY STORE, INC.
 845 E. INTERSTATE 30 FRONTAGE RD.
 ROCKWALL, TEXAS 75087
 BLOCK A, LOT 1
 CASE NUMBER: SP2018-028

CRACKER BARREL PROJECT NUMBER: CB 161 ROCKWALL, TX -03
CRACKER BARREL
OLD COUNTRY STORE, INC.
 845 EAST INTERSTATE 30
 ROCKWALL, TEXAS 75087

These construction documents are the exclusive property of Cracker Barrel Old Country Store, Inc. and may not be used or reproduced without written permission of Cracker Barrel Old Country Store, Inc.

Cracker Barrel
 P.O. Box 787
 Hartmann Drive, Lebanon, Tn. 37087

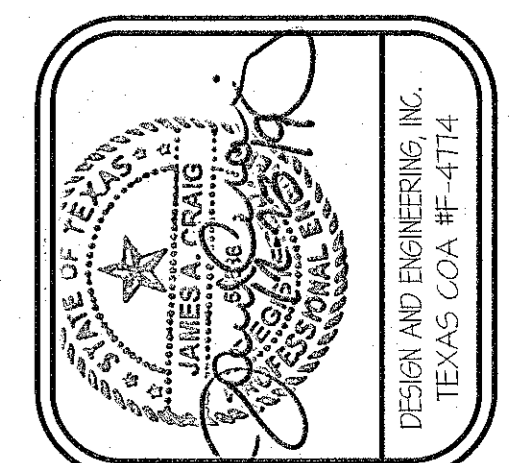

DESIGN and ENGINEERING, INC.
STRUCTURAL AND CIVIL ENGINEERS
 1645 Westgate Circle
 Brentwood, TN 37027
 615-370-1779
 fax: 370-9108
 www.deneinc.us

DATE:	12-16-14
PROJECT NO.:	11-1645
REVISIONS	
△	
△	
△	



RECORD STORM DRAINAGE PLAN (2)
RC-2C
 PROTO 116-19F