

UTILITY INSET FOR WORK IN ROW


BARREL SITE


1" = 10"


GRAPHIC SCALE

VERTICAL AND HORIZONTAL

1"=10' FOR 24" X 36" PLANS

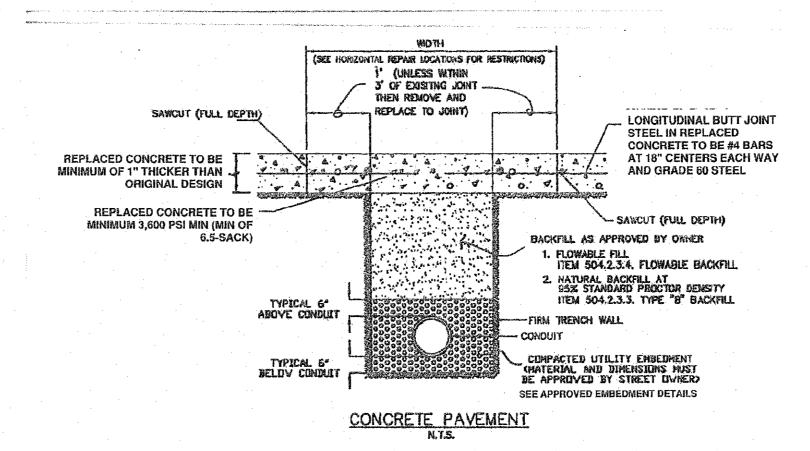


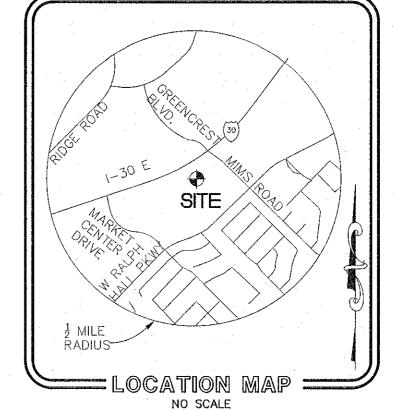

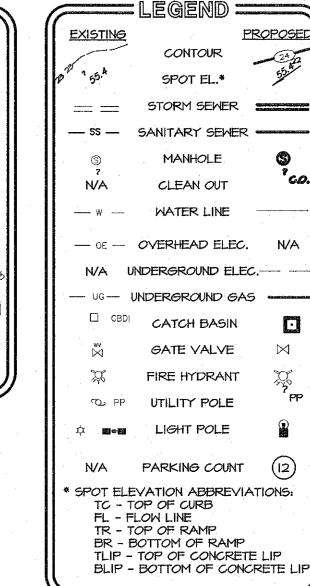


OF ROCKWALL CONCRETE REPLACEMENT


NO SCALE

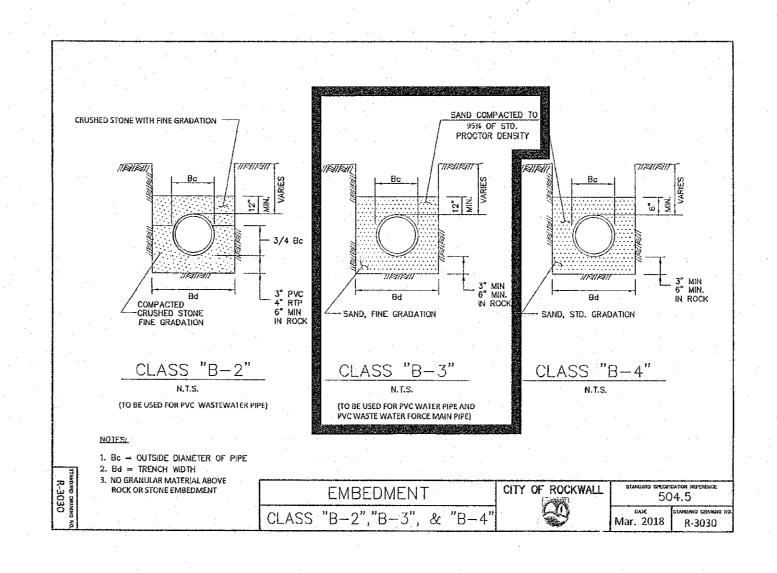

OF ROCKWALL EMBEDMENT DETAILS NO SCALE

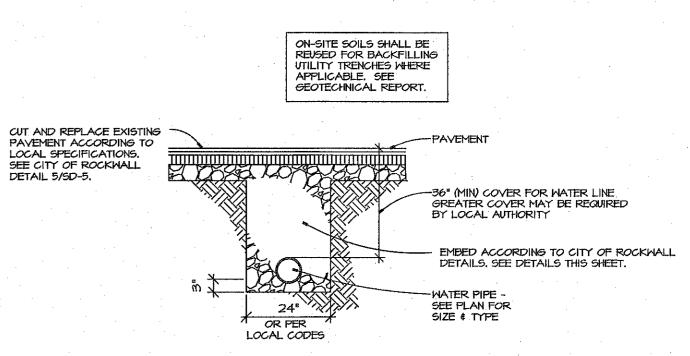

TRENCH DETAIL NO SCALE

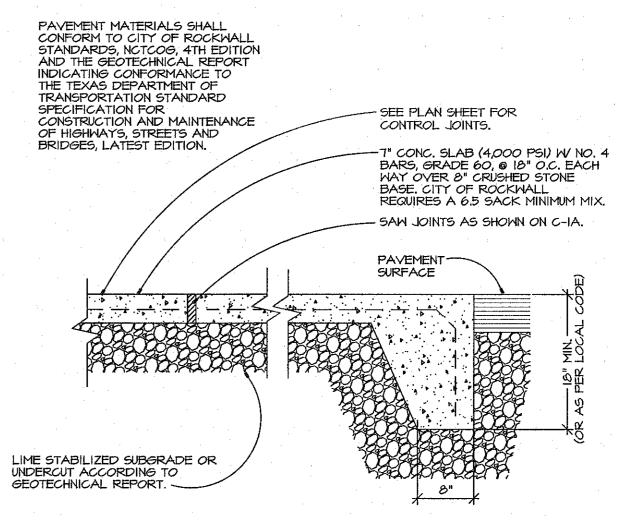

HEAVY DUTY CONCRETE PAVEMENT DETAIL NO SCALE

ALL RESPONSIBILITY FOR ADEQUACY OF DESIGN REMAINS WITH THE DESIGN ENGINEER, THE CITY OF ROCKWALL, IN REVIEWING AND RELEASING PLANS FOR CONSTRUCTION, ASSUMES NO RESPONSIBILITY FOR ADEQUACY OR ACCURACY OF DESIGN.


PROPERTY KOHL'S ILLINOIS, INC. OWNER: N56WI7000 RIDGEWOOD DRIVE MENOMONEE FALLS, WISCONSIN 53051 ERIC BORKENHAGEN (262) 703-7000

OWNER: CBOCS TEXAS LIMITED PARTNERSHIP P.O. BOX 787 LEBANON, TENNESSEE 37088-0787 TELEPHONE: (615) 444-5533

PLANS JAMES A. CRAIG, P.E. PREPARED DESIGN AND ENGINEERING, INC. 1645 WESTGATE CIRCLE BRENTWOOD, TENNESSEE 37027 (615) 370-1779

CRACKER BARREL OLD COUNTRY STORE, INC. 845 E. Interstate 30 frontage Rd. ROCKWALL, TEXAS 75087 BLOCK A, LOT 1

CASE NUMBER: SP2018-028

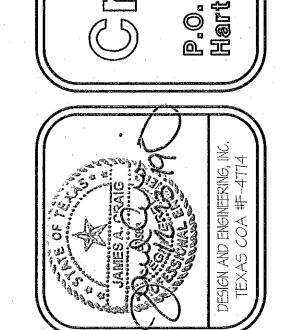

Ø

ate Circle TN 37027 -370-1779 370-9108 Indeinc.us 1645Westga Brentwood, 7 615-3 fax: 3 www.dan

