


2 DUMPSTER ENCLOSURE PLAN  
D-1 SCALE: 1/2"=1'-0"

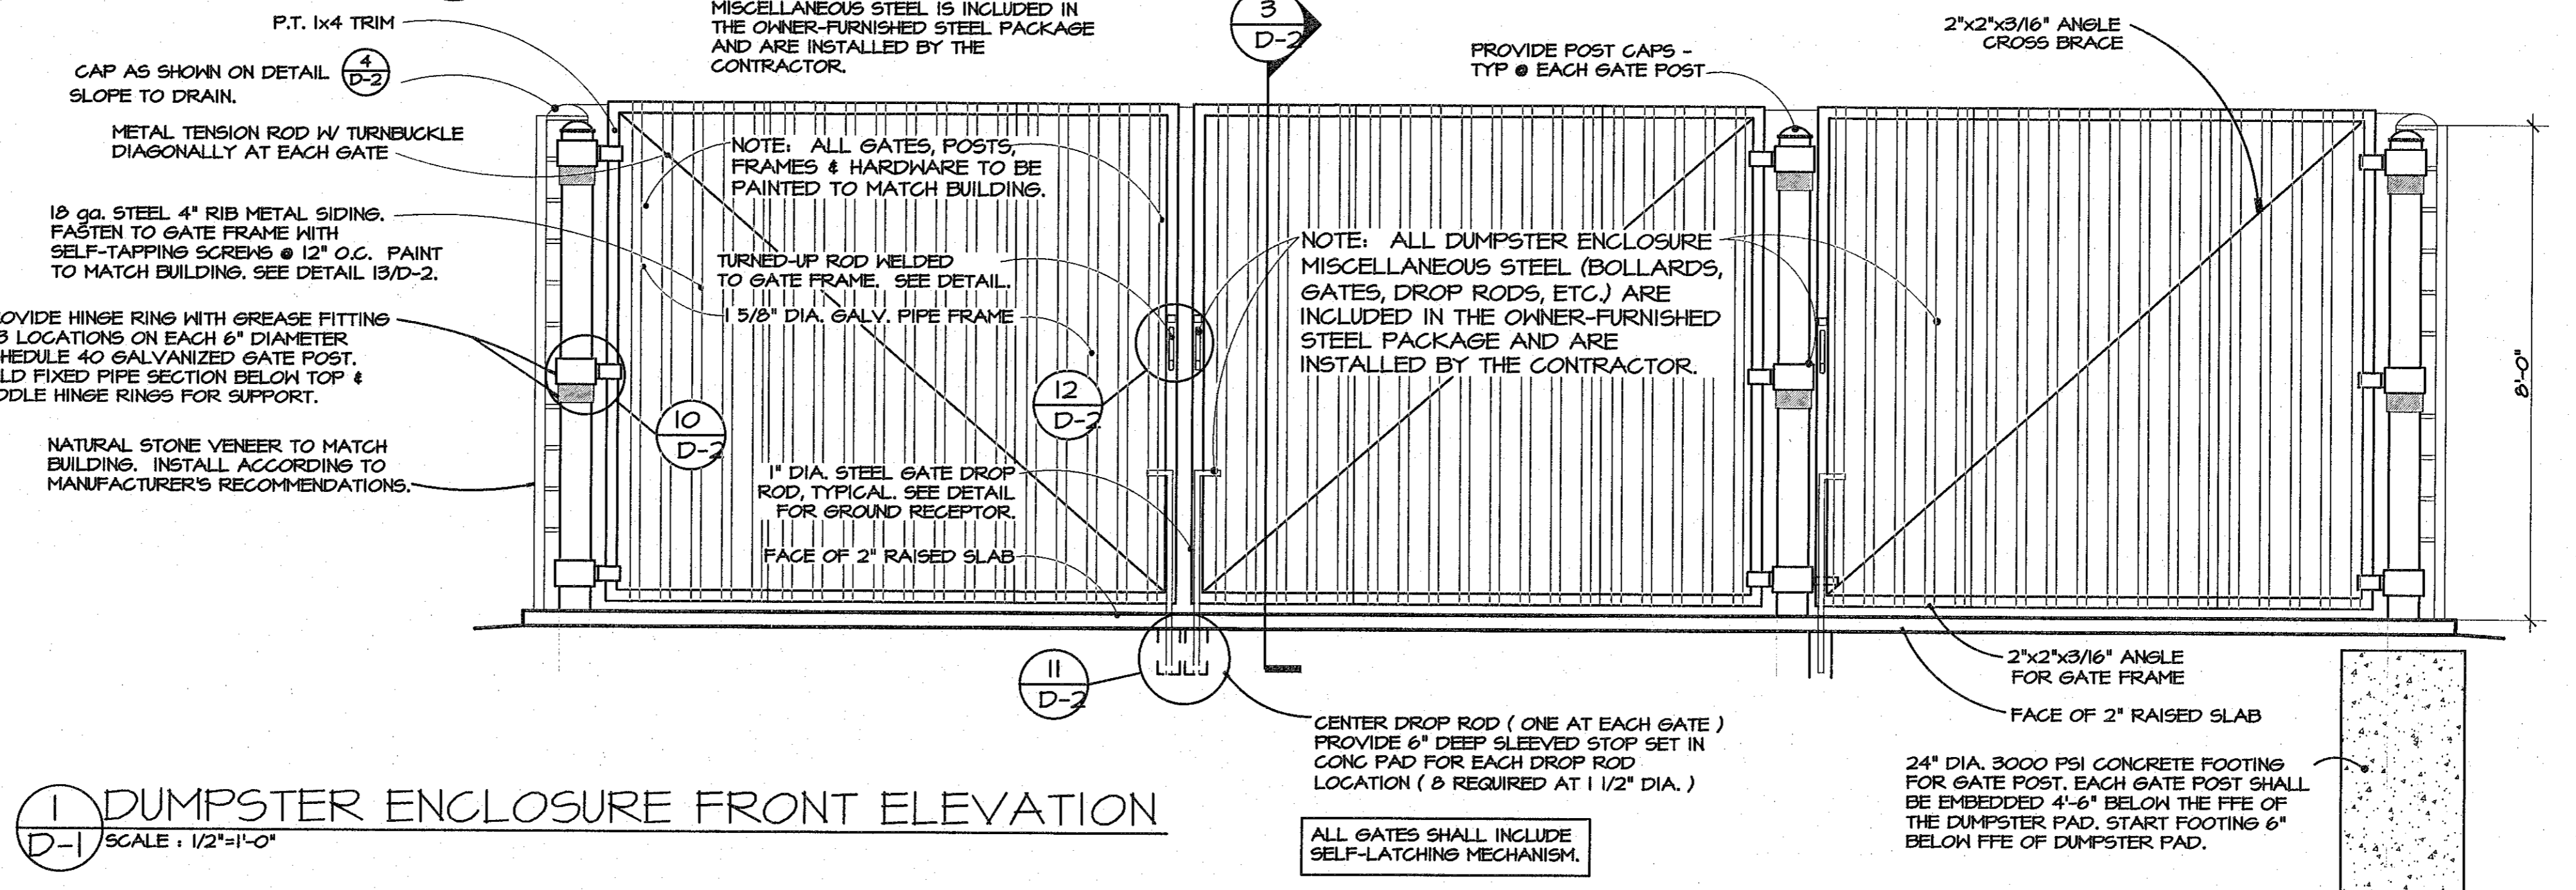

1 DUMPSTER ENCLOSURE FRONT ELEVATION  
D-1 SCALE: 1/2"=1'-0"

PROPERTY OWNER: KOHL'S ILLINOIS, INC. N84N1000 RIDGEWOOD DRIVE MEMONEE FALLS, WISCONSIN 53051 ERIC BORKENHAGEN (262) 709-1000


OWNER: CBOCS TEXAS LIMITED PARTNERSHIP P.O. BOX 781 LEBANON, TENNESSEE 37089-0781 TELEPHONE: (615) 444-5533

PLANS PREPARED BY: JAMES A. CRAIG, P.E. DESIGN AND ENGINEERING, INC. 1645 WESTGATE CIRCLE BRENTWOOD, TENNESSEE 37027 (615) 370-1774

CRACKER BARREL  
OLD COUNTRY STORE, INC.  
845 E. INTERSTATE 30 FRONTAGE RD.  
ROCKWALL, TEXAS 75087  
BLOCK A, LOT 1  
CASE NUMBER: SP2018-028

CRACKER BARREL PROJECT NUMBER: CB 769 ROCKWALL, TX -03  
CRACKER BARREL  
OLD COUNTRY STORE, INC.  
845 EAST INTERSTATE 30  
ROCKWALL, TEXAS 75087  
These construction documents are the exclusive property of Cracker Barrel Old Country Store, Inc. The information shown herein shall not be used or the drawings reproduced without the written permission of Cracker Barrel Old Country Store, Inc.

Cracker Barrel  
P.O. Box 787  
Hartmann Drive, Lebanon, TN. 37087

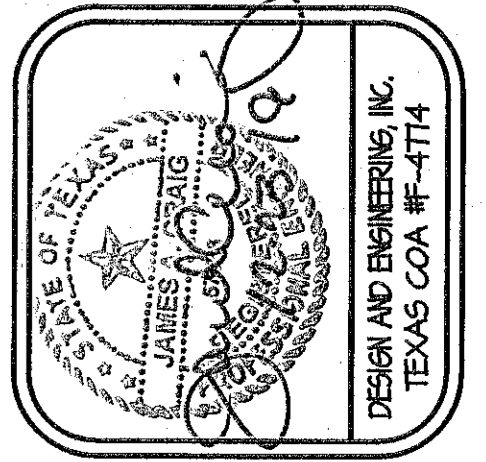

DESIGN AND ENGINEERING, INC.  
ARCHITECTS, STRUCTURAL AND CIVIL ENGINEERS

1645 Westgate Circle  
Brentwood, TN 37027  
615-370-1779  
615-370-1778  
615-370-9108  
www.dandei.com

DATE: 12-18-18  
PROJECT NO.: 11-16-18

NO.	REVISIONS

CRACKER BARREL  
Old Country Store

RECORD  
DUMPSTER DETAILS

RD-1

FRG TO 116-14E