



10 GATE DETAIL
D-2 NO SCALE

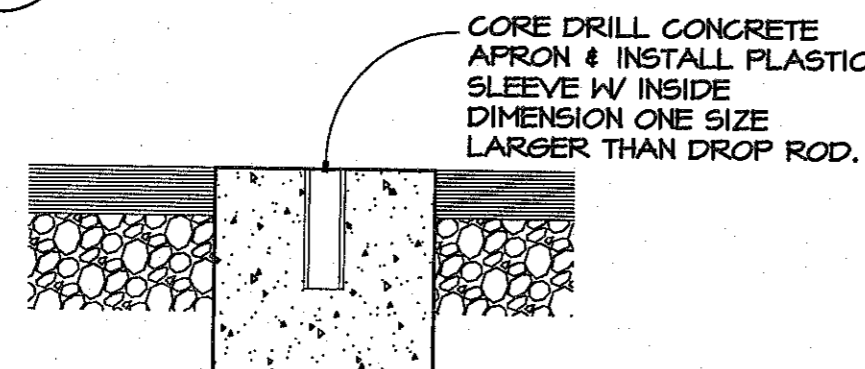


11 GATE HOLD DETAIL
D-2 SCALE: 1 1/2" = 1'-0"

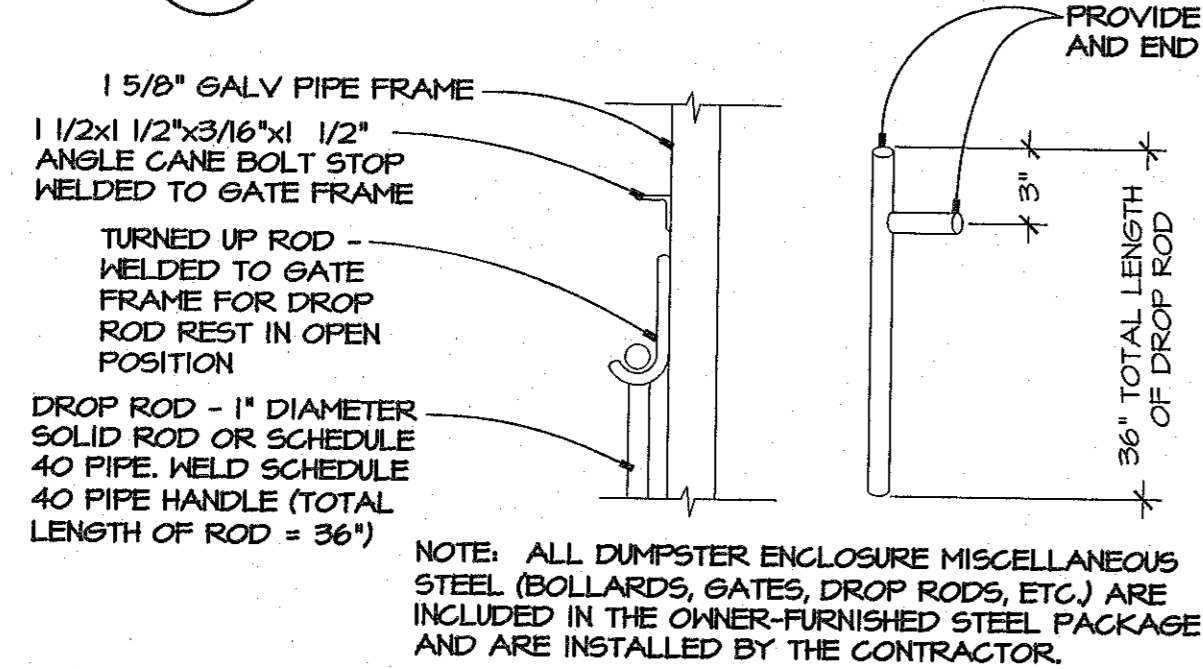


ALL GATES SHALL INCLUDE SELF-LATCHING MECHANISM.


12 GATE DETAIL
D-2 NO SCALE

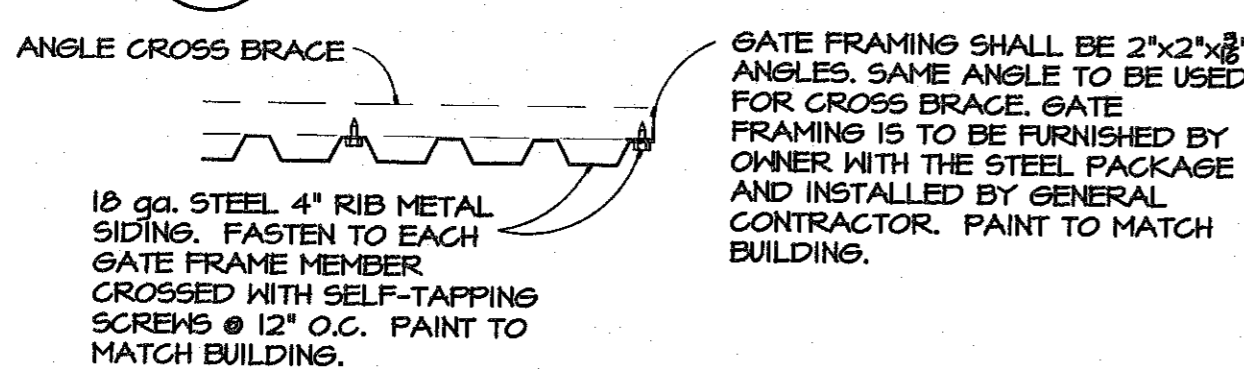


13 GATE PANEL ATTACHMENT
D-2 NO SCALE

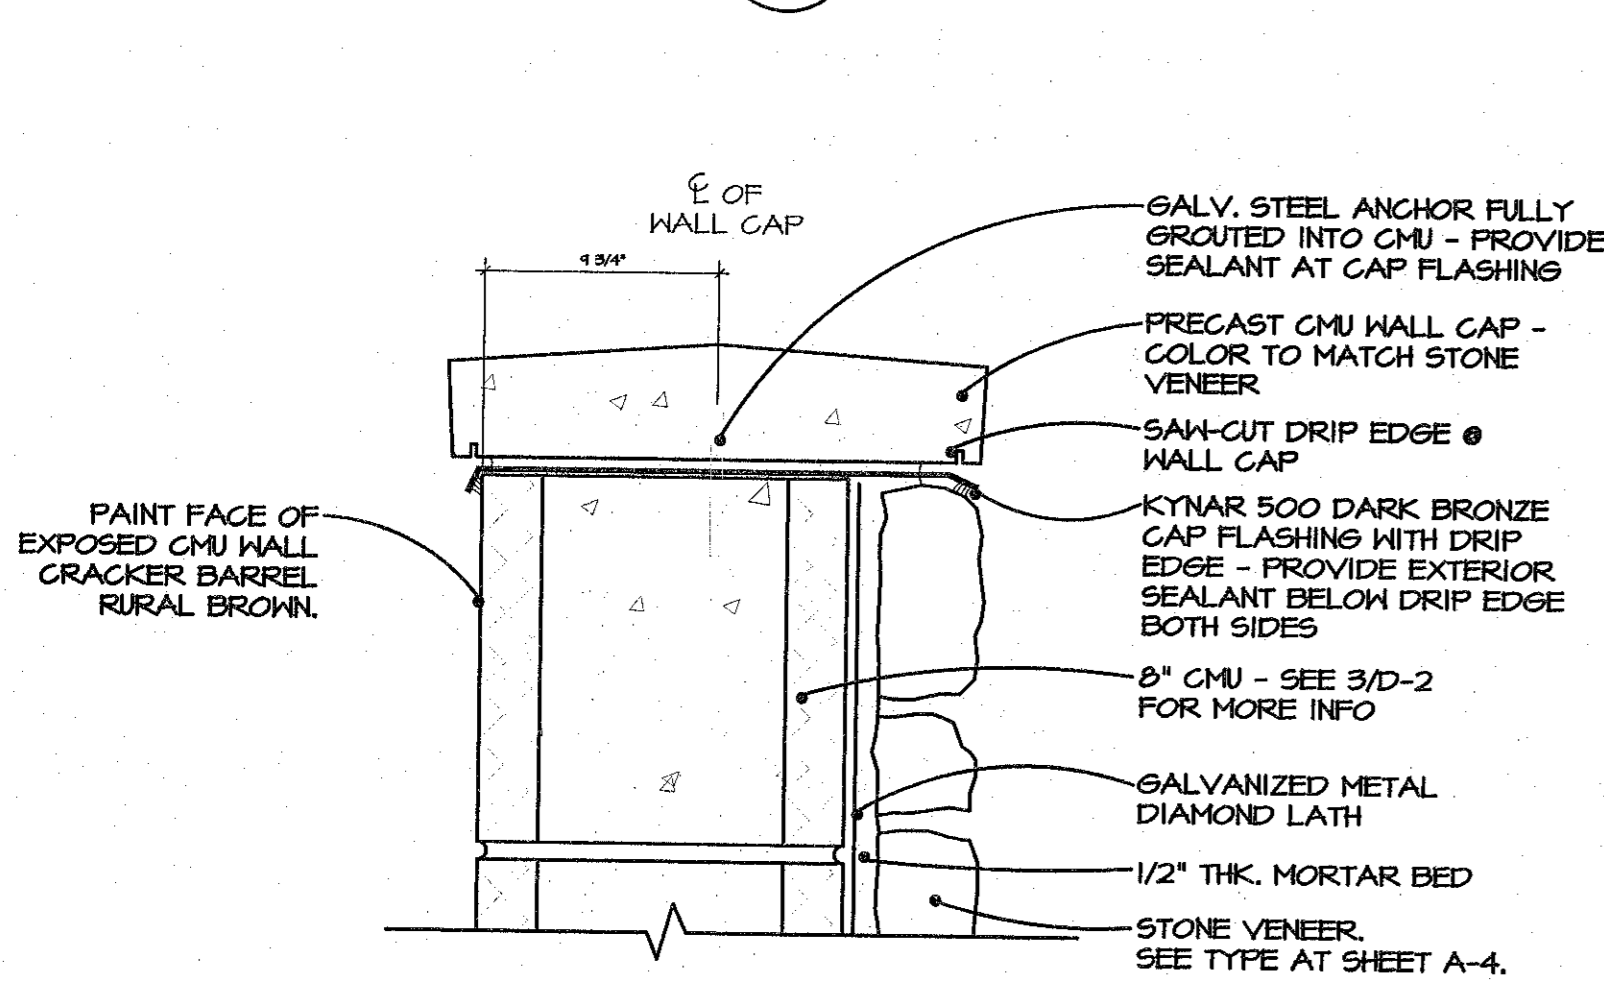

4 STONE BASE VENEER DETAIL
D-2 SCALE: 3\"/>

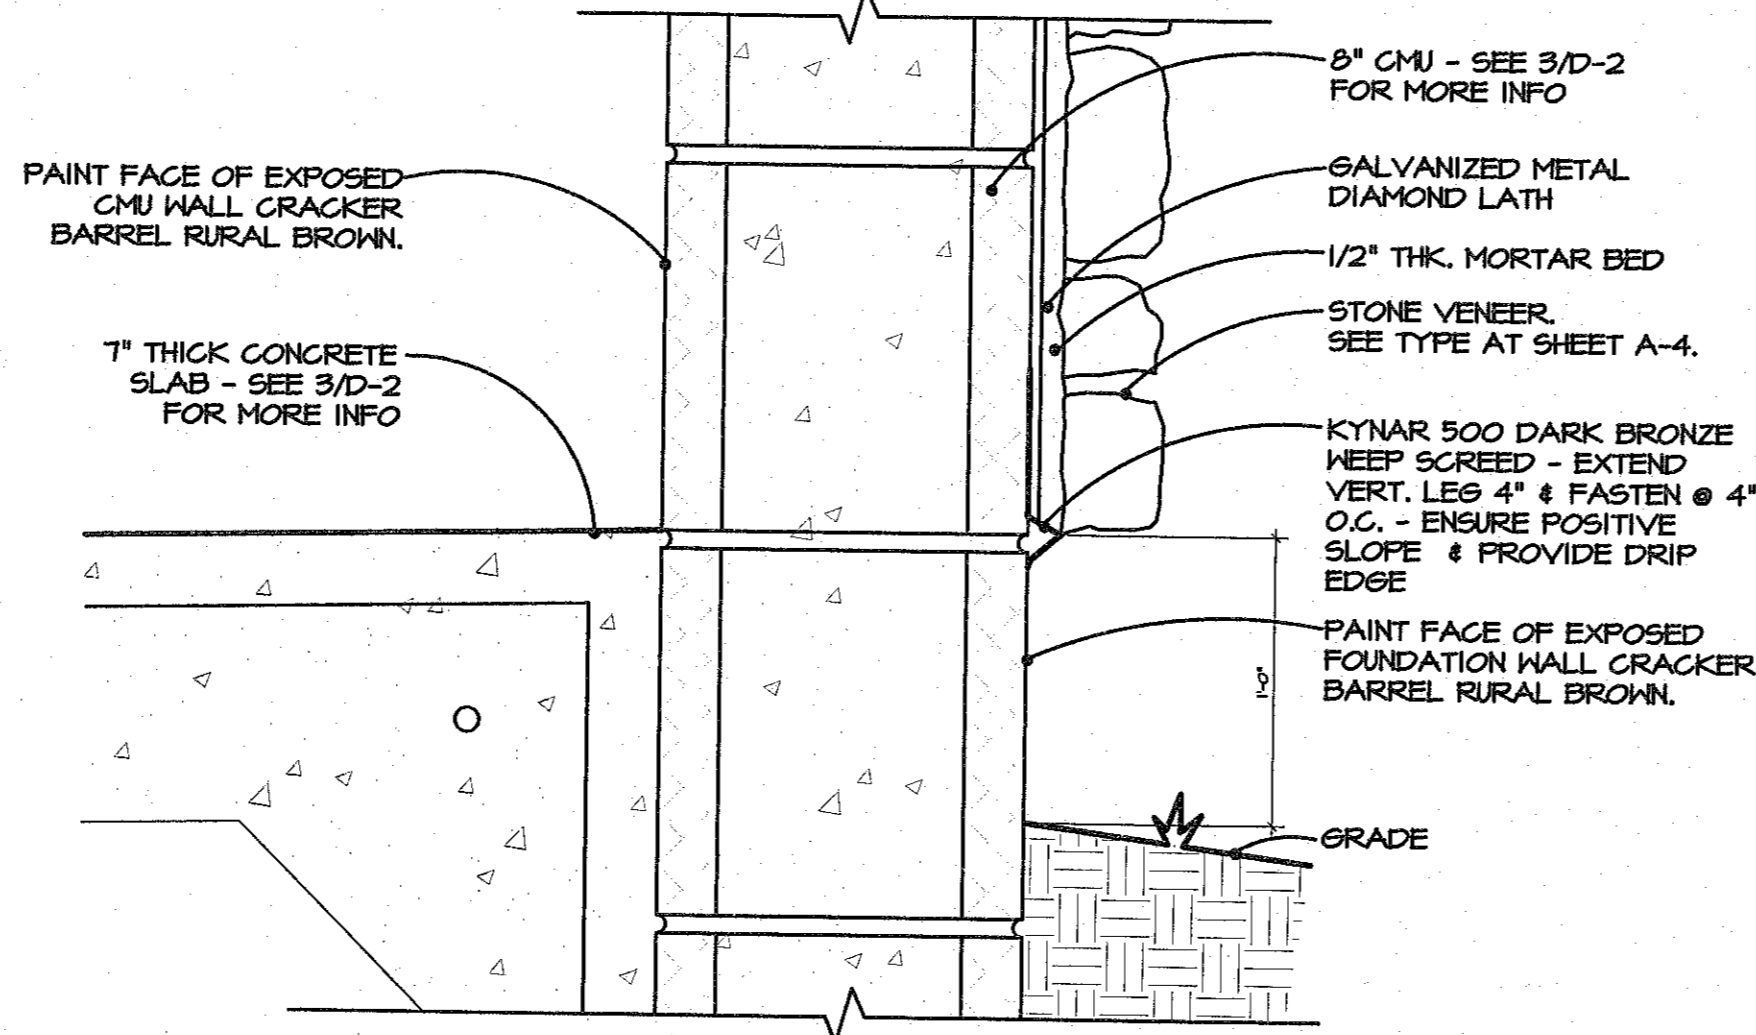


5 STONE BASE VENEER DETAIL
D-2 SCALE: 3\"/>

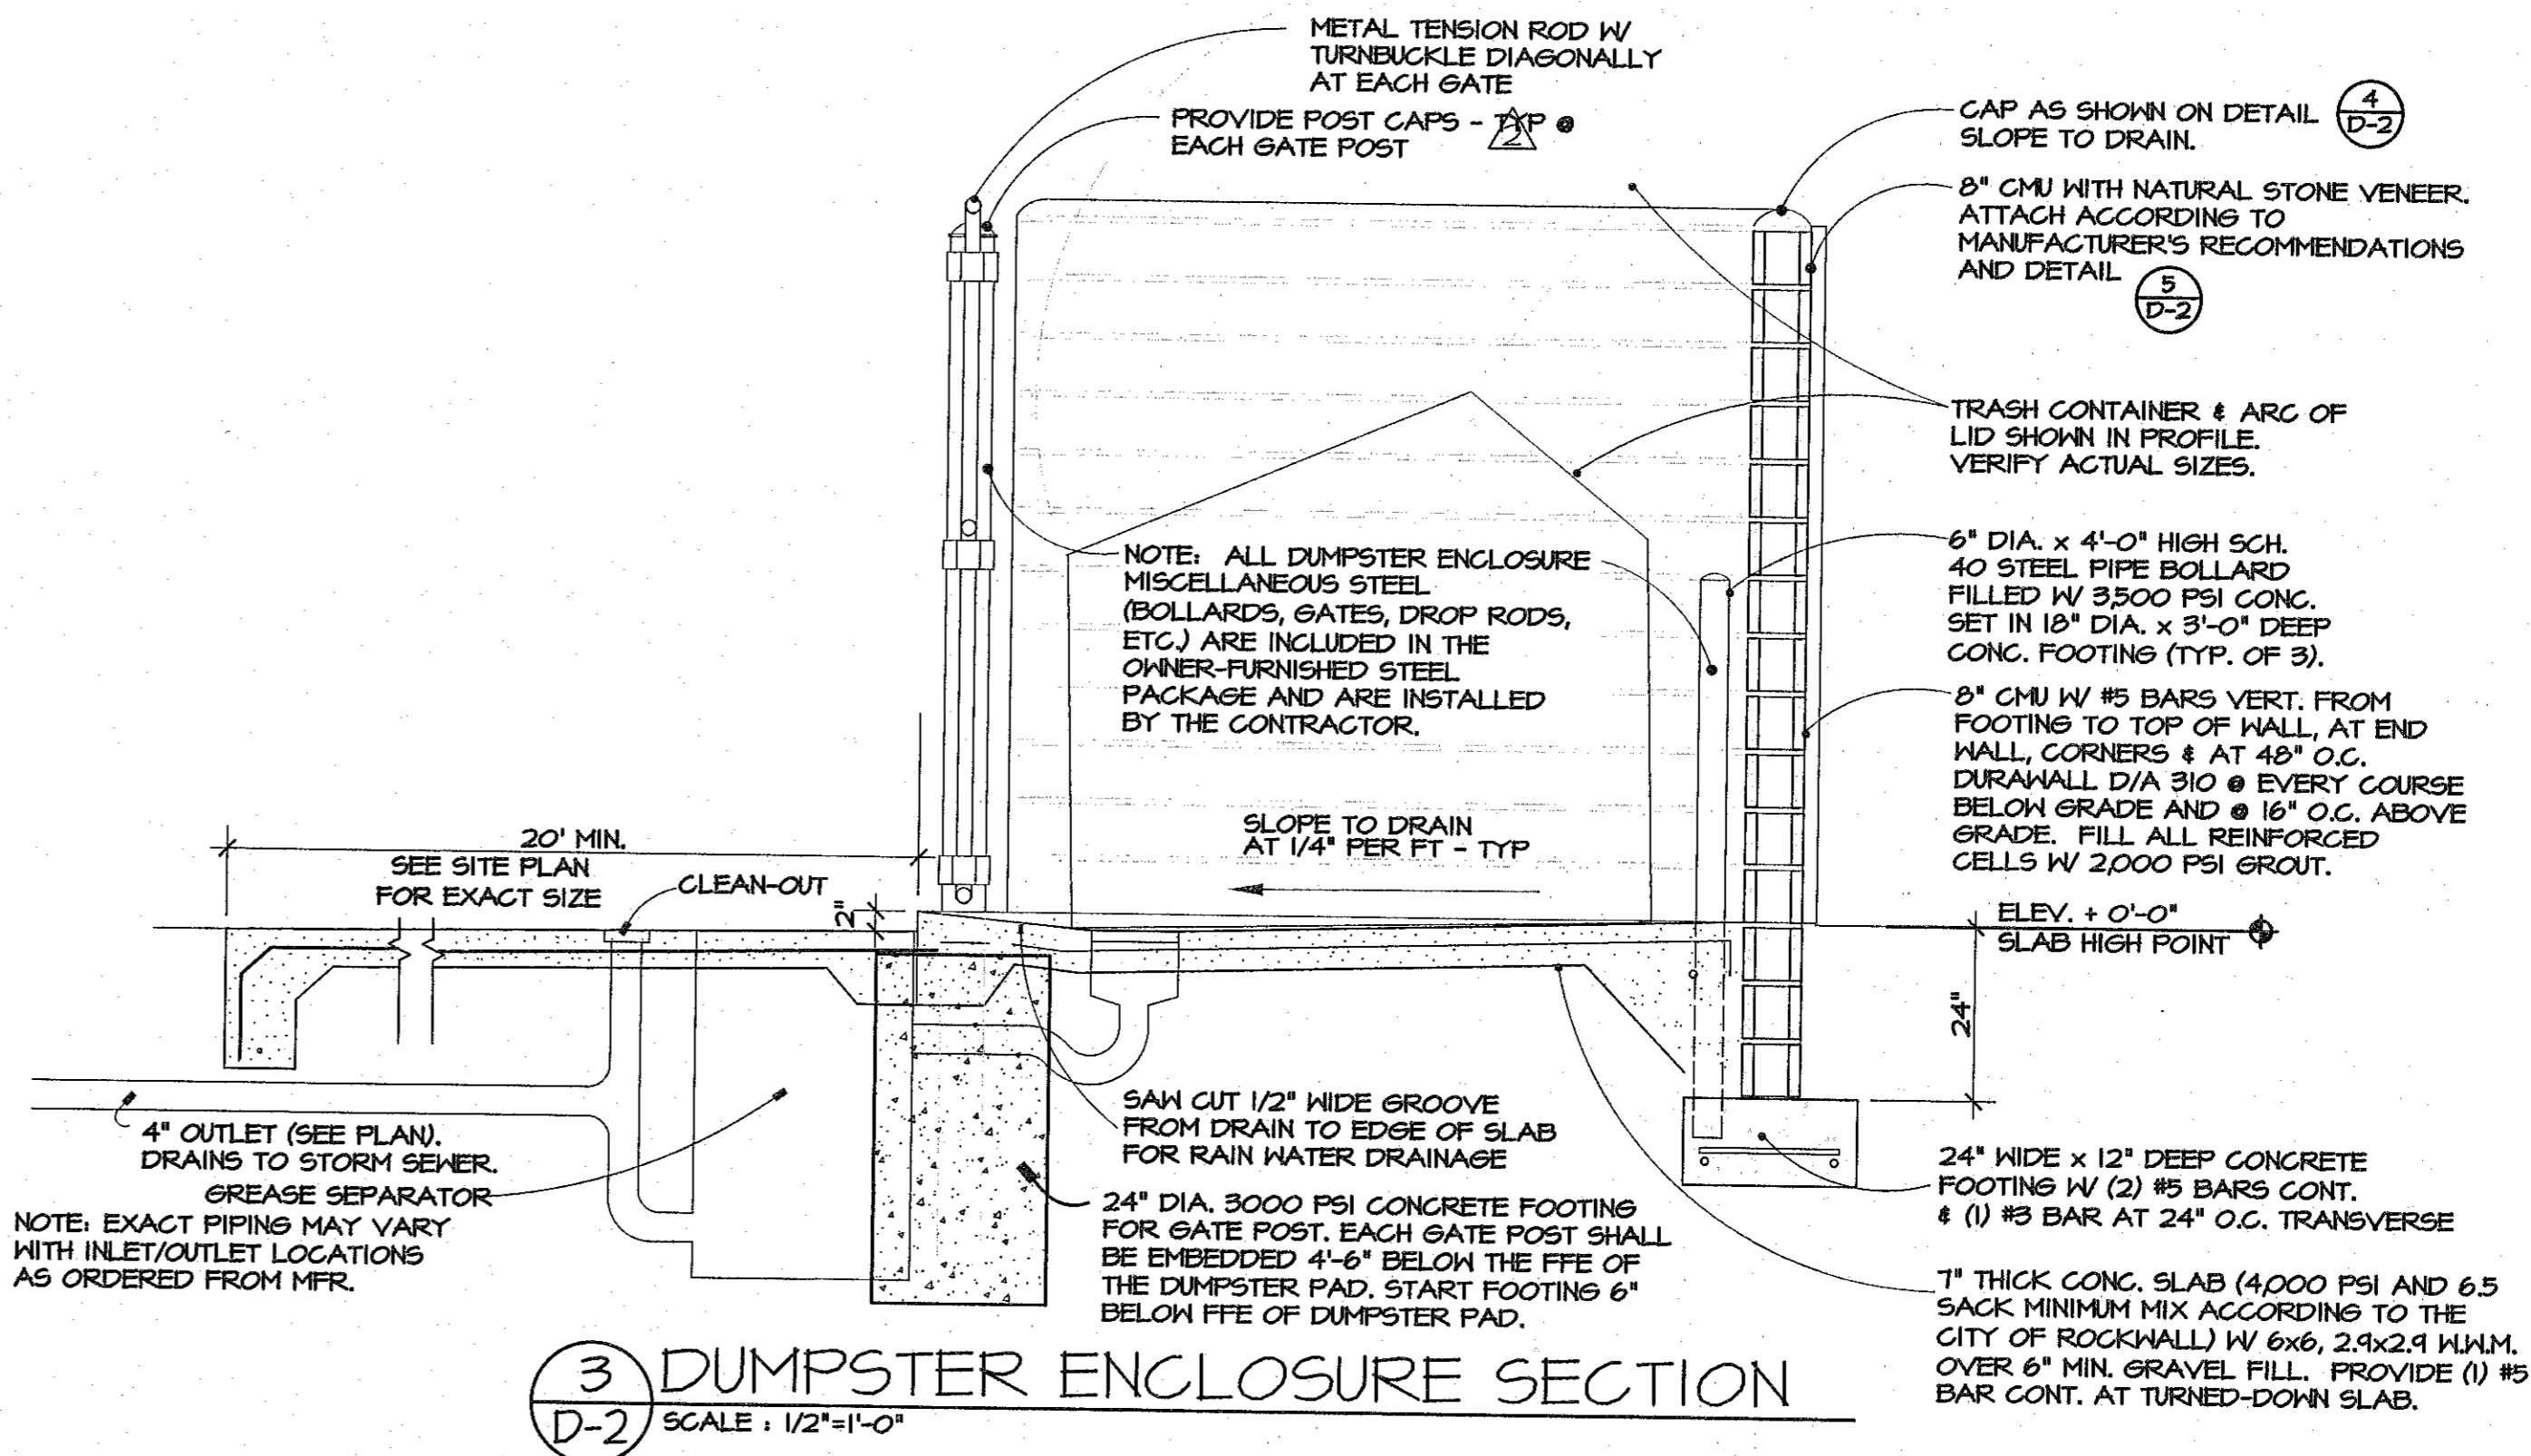

3 DUMPSTER ENCLOSURE SECTION
D-2 SCALE: 1/2\"/>

CRACKER BARREL PROJECT NUMBER: CB 164 ROCKWALL, TX 09
CRACKER BARREL
OLD COUNTRY STORE, INC.
 845 EAST INTERSTATE 30
 ROCKWALL, TEXAS 75087
These construction documents are the exclusive property of Cracker Barrel Old Country Store, Inc. The information shown herein is for the use of Cracker Barrel Old Country Store, Inc. only.

Cracker Barrel
 P.O. Box 787
 Hartmann Drive, Lebanon, TN. 37087

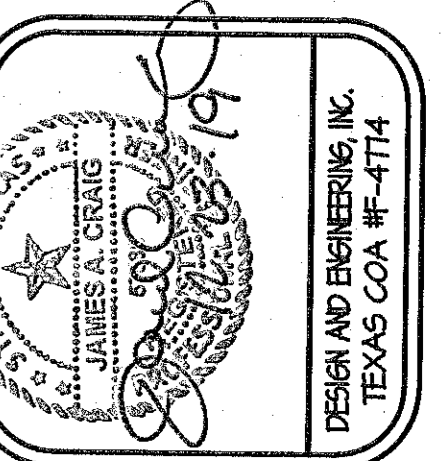

1645 Westgate Circle
 Brentwood, TN 37027
 615-370-1779
 fax: 370-9108
 www.dandengr.com
DESIGN AND ENGINEERING, INC.
 ARCHITECTS, STRUCTURAL AND CIVIL ENGINEERS

DATE:	12-18-14
PROJECT NO.:	11-1645
REVISIONS:	



RECORD
DUMPSTER DETAILS

RD-2
 PROTO 116-14F

PROPERTY OWNER: KOHL'S ILLINOIS, INC.
 18611000 RIDGEBROOK DRIVE
 MENOMONEE FALLS, WISCONSIN 53051
 ERIC BORKENHAGEN
 (262) 703-1000

OWNER: CBOCS TEXAS LIMITED PARTNERSHIP
 P.O. BOX 787
 LEBANON, TENNESSEE 37088-0787
 TELEPHONE: (615) 444-5533

PLANS PREPARED BY: JAMES A. CRAIG, P.E.
 DESIGN AND ENGINEERING, INC.
 1645 WESTGATE CIRCLE
 BRENTWOOD, TENNESSEE 37027
 (615) 370-1779

CRACKER BARREL
OLD COUNTRY STORE, INC.
 845 E. INTERSTATE 30 FRONTAGE RD.
 ROCKWALL, TEXAS 75087
 BLOCK A, LOT 1
 CASE NUMBER: SP2018-028