




PIPE BOLLARDS AND EXPANDED METAL GRATING INCLUDED IN OWNER FURNISHED STEEL PACKAGE AND INSTALLED BY THE CONTRACTOR.

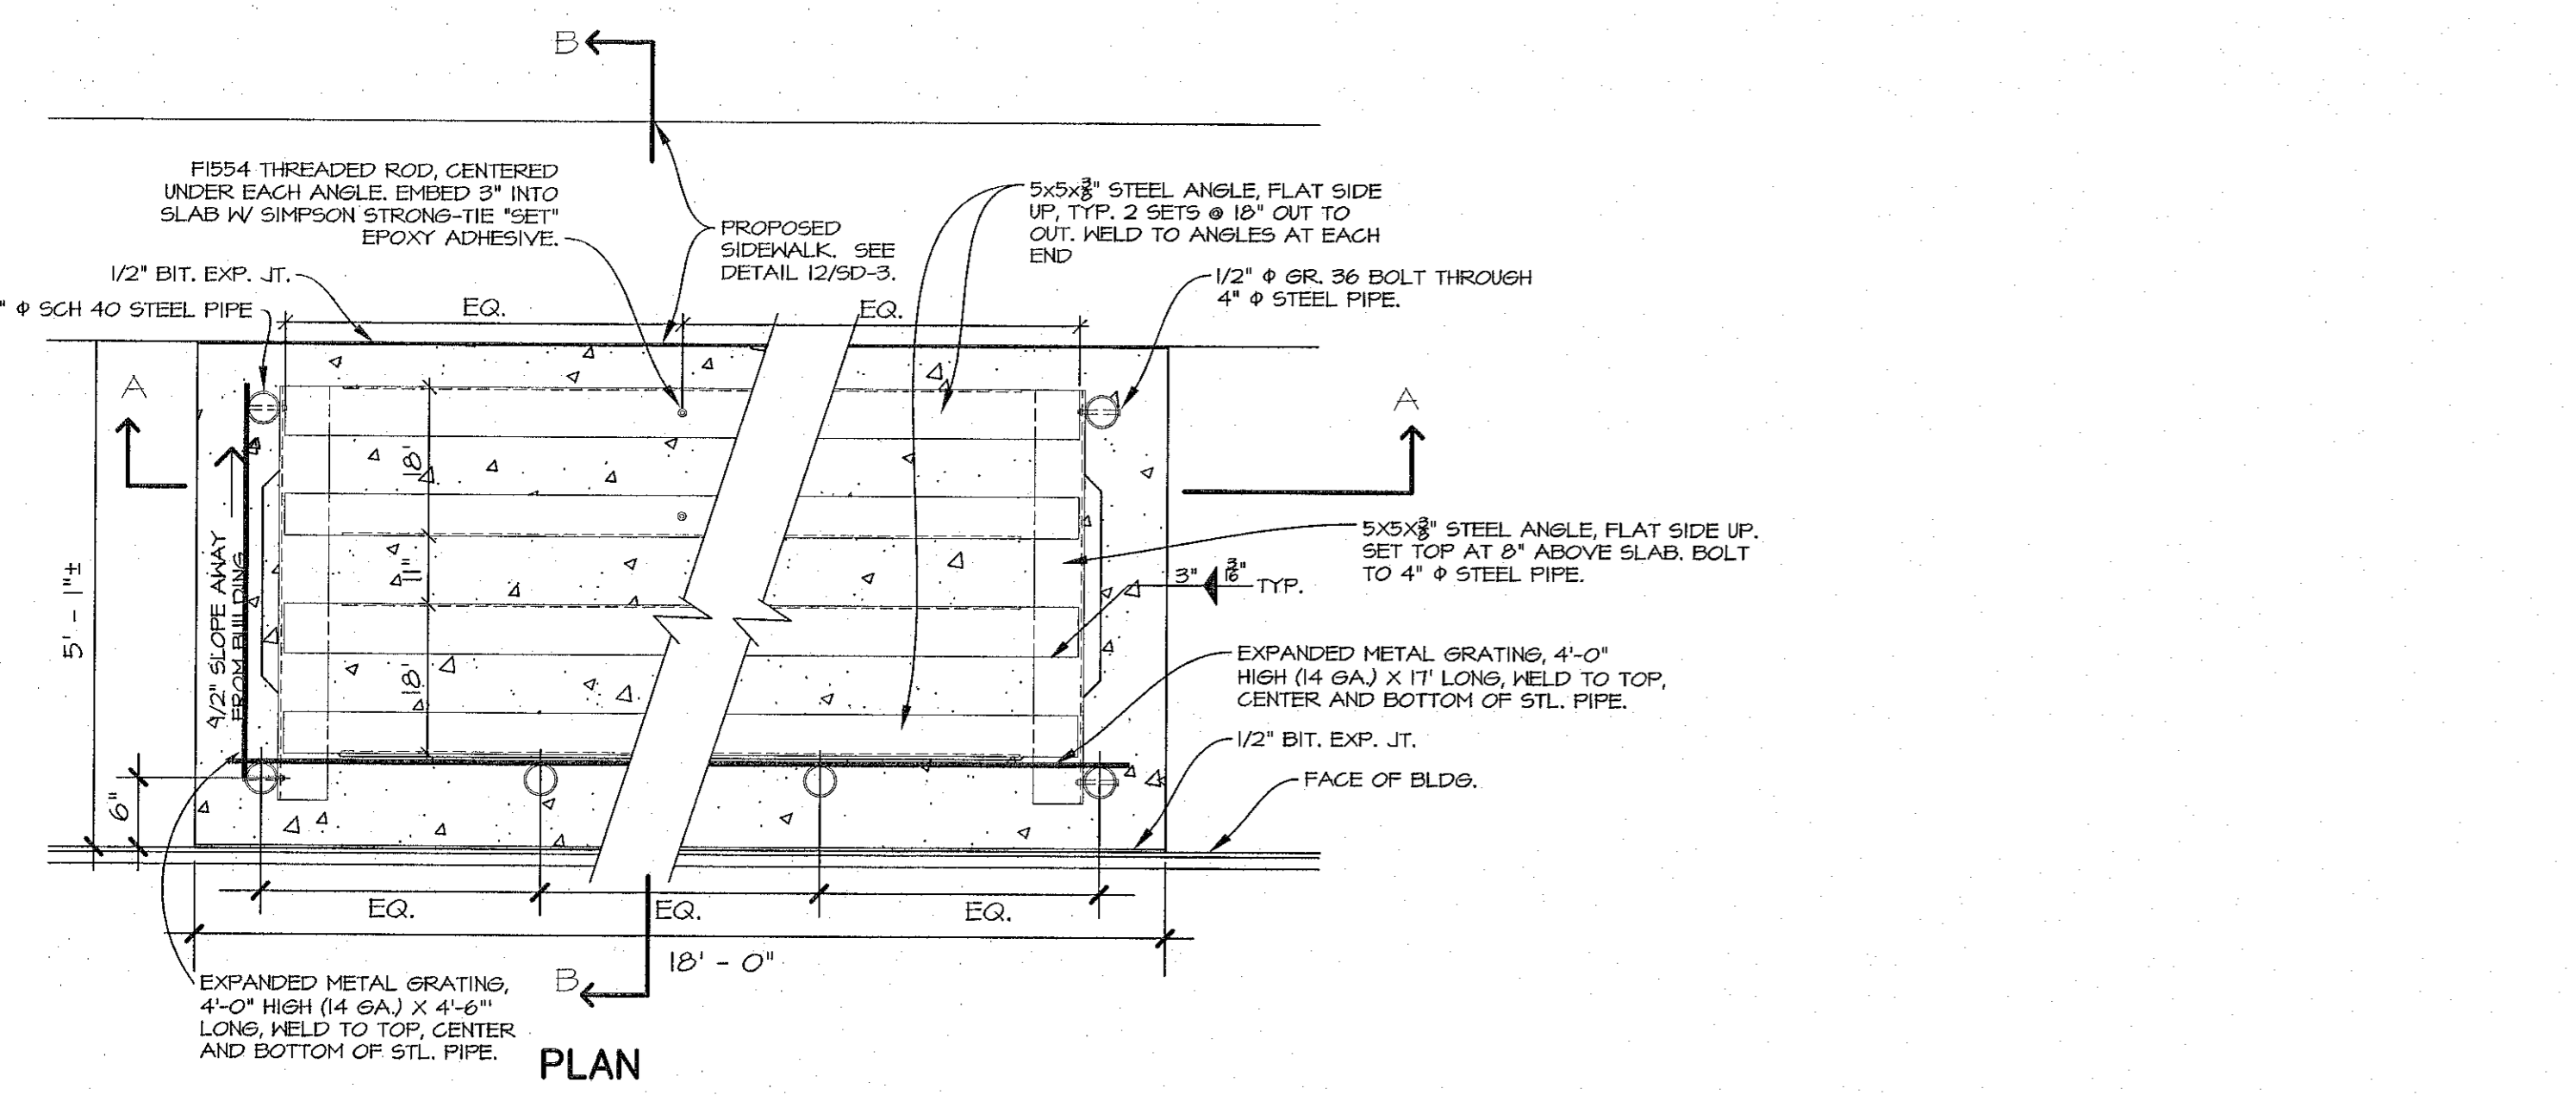


1 FIREWOOD PAD DETAIL WITH SIDEWALK Not to Scale

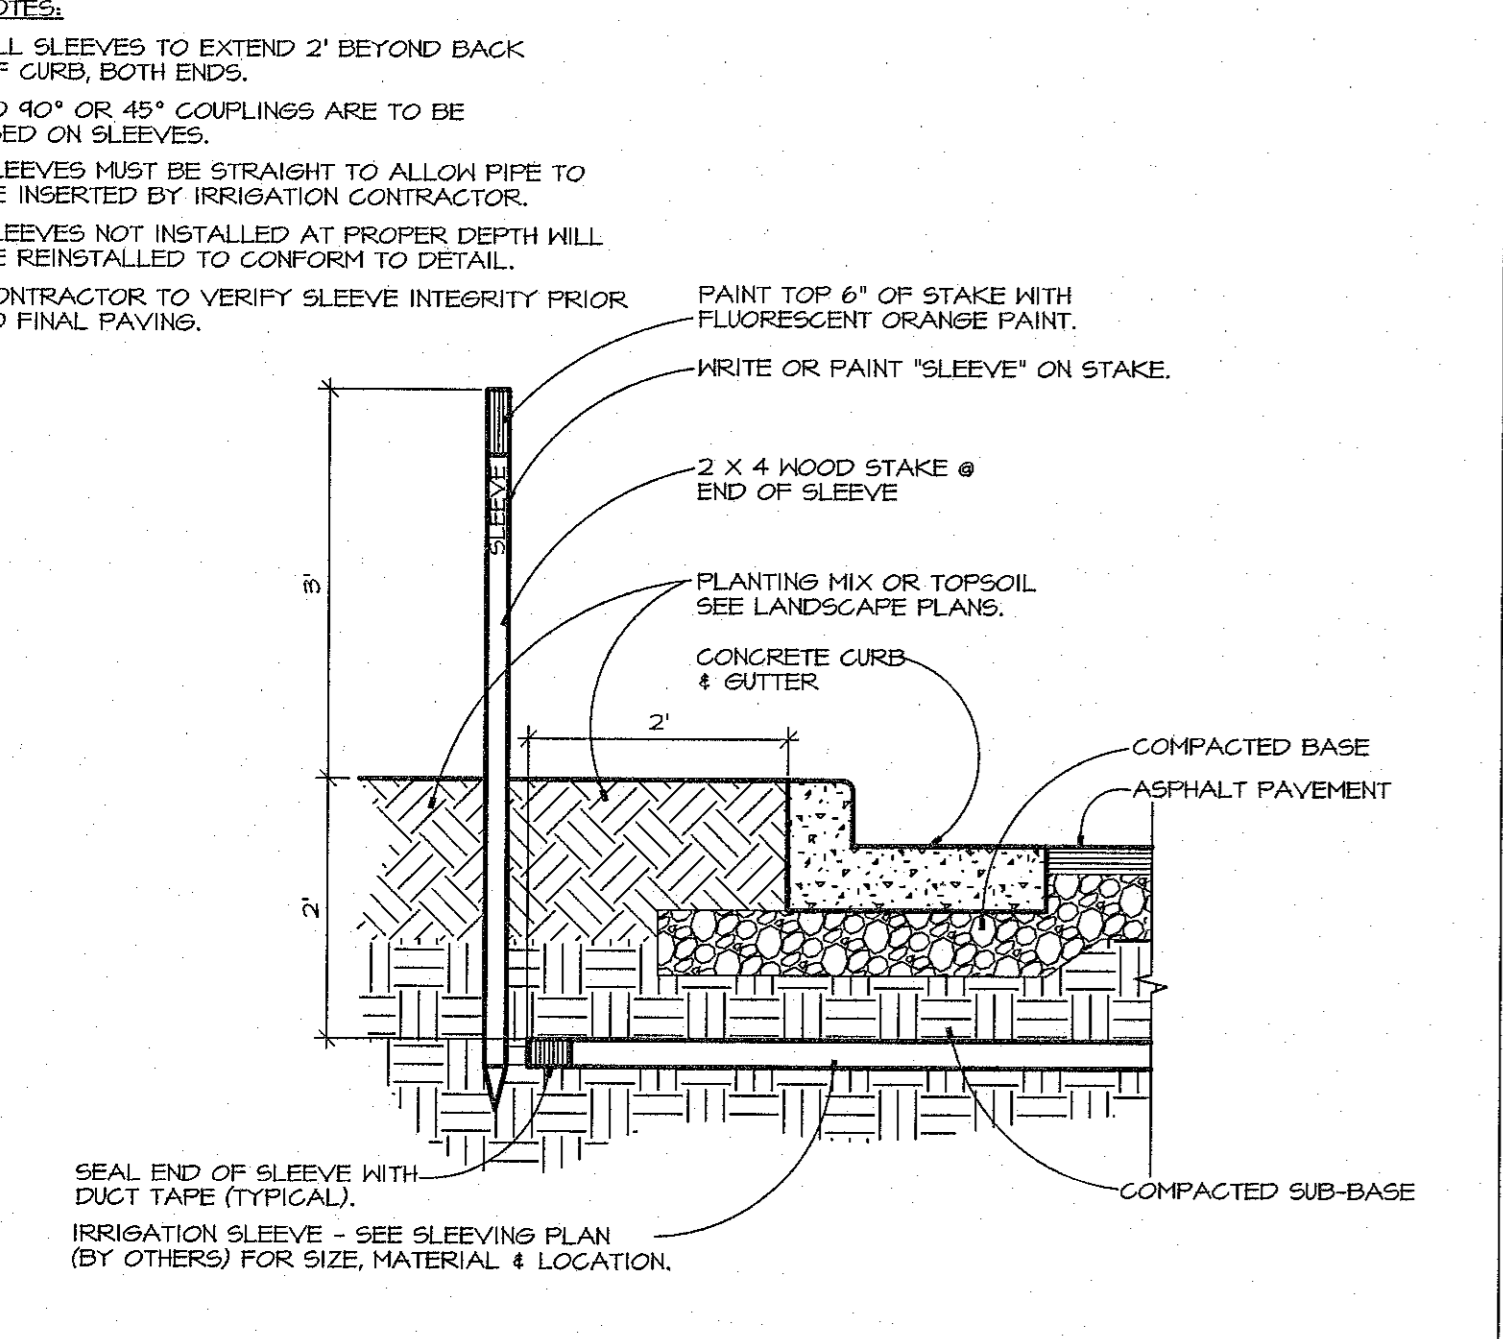


4 IRRIGATION SLEEVING DETAIL Not to Scale

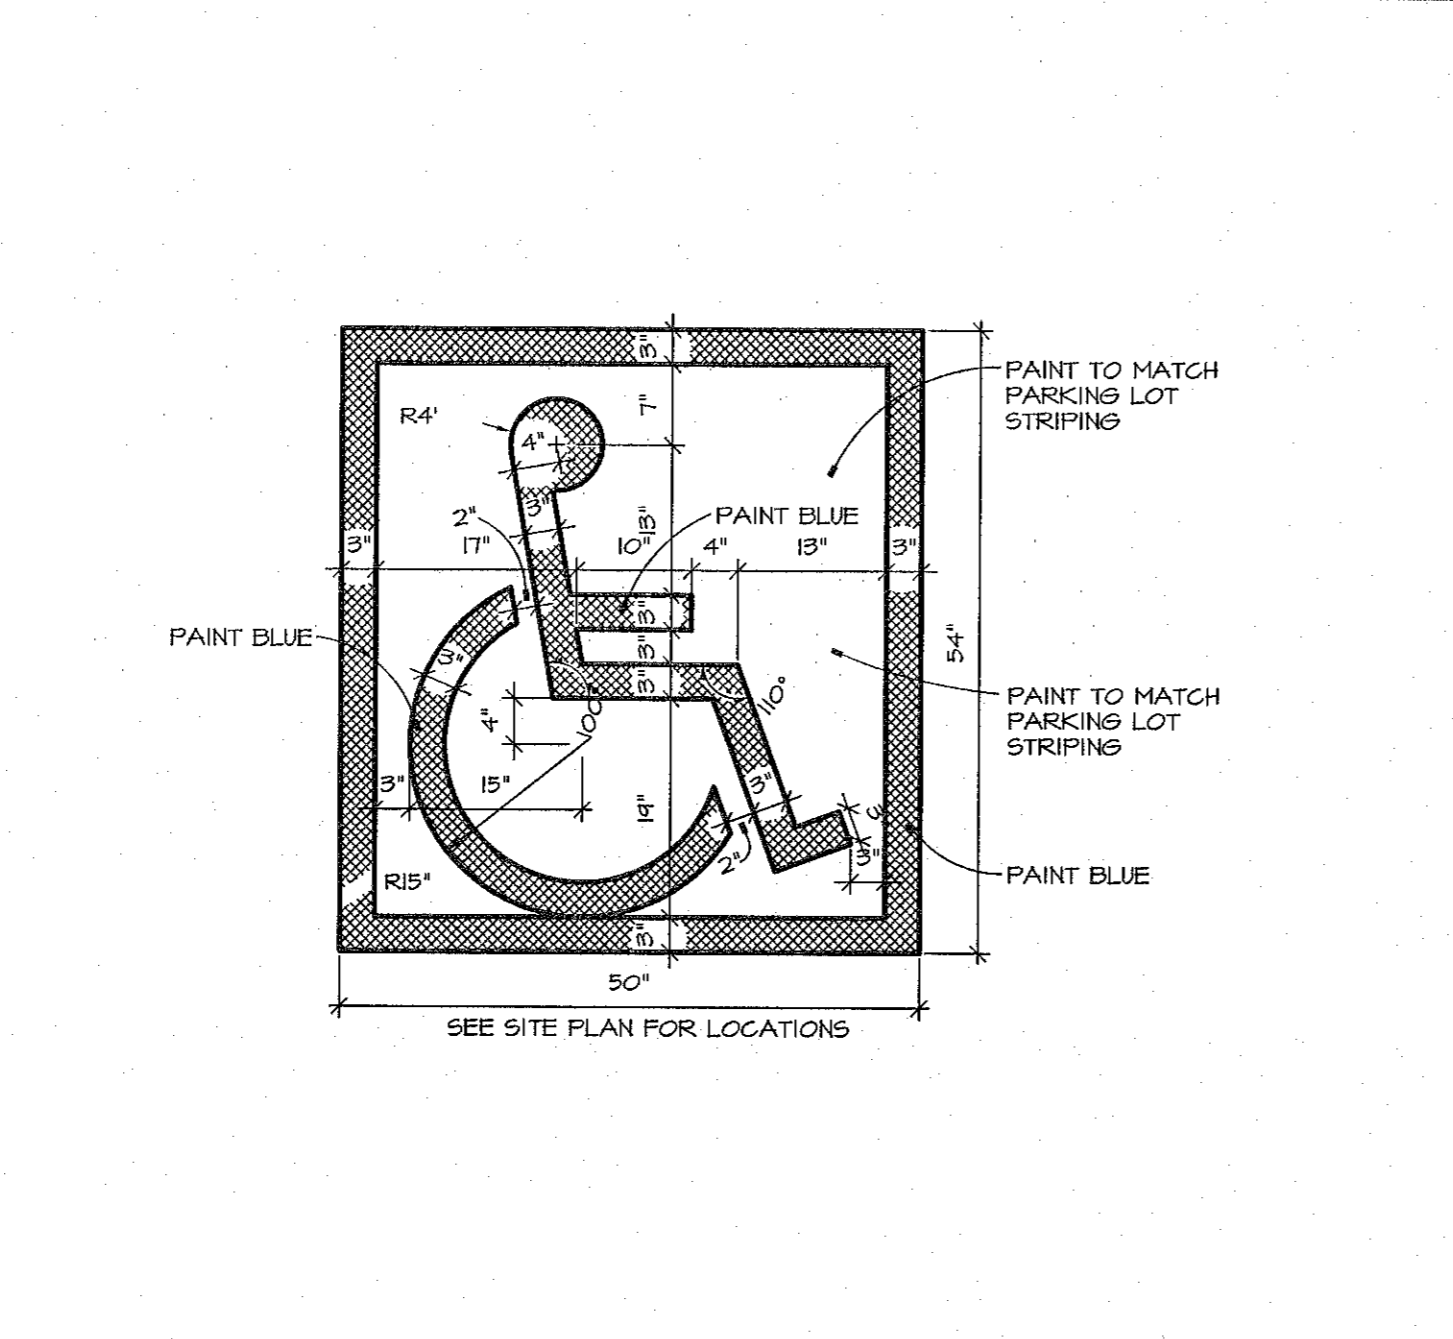


5 ACCESSIBLE SYMBOL DETAIL Not to Scale

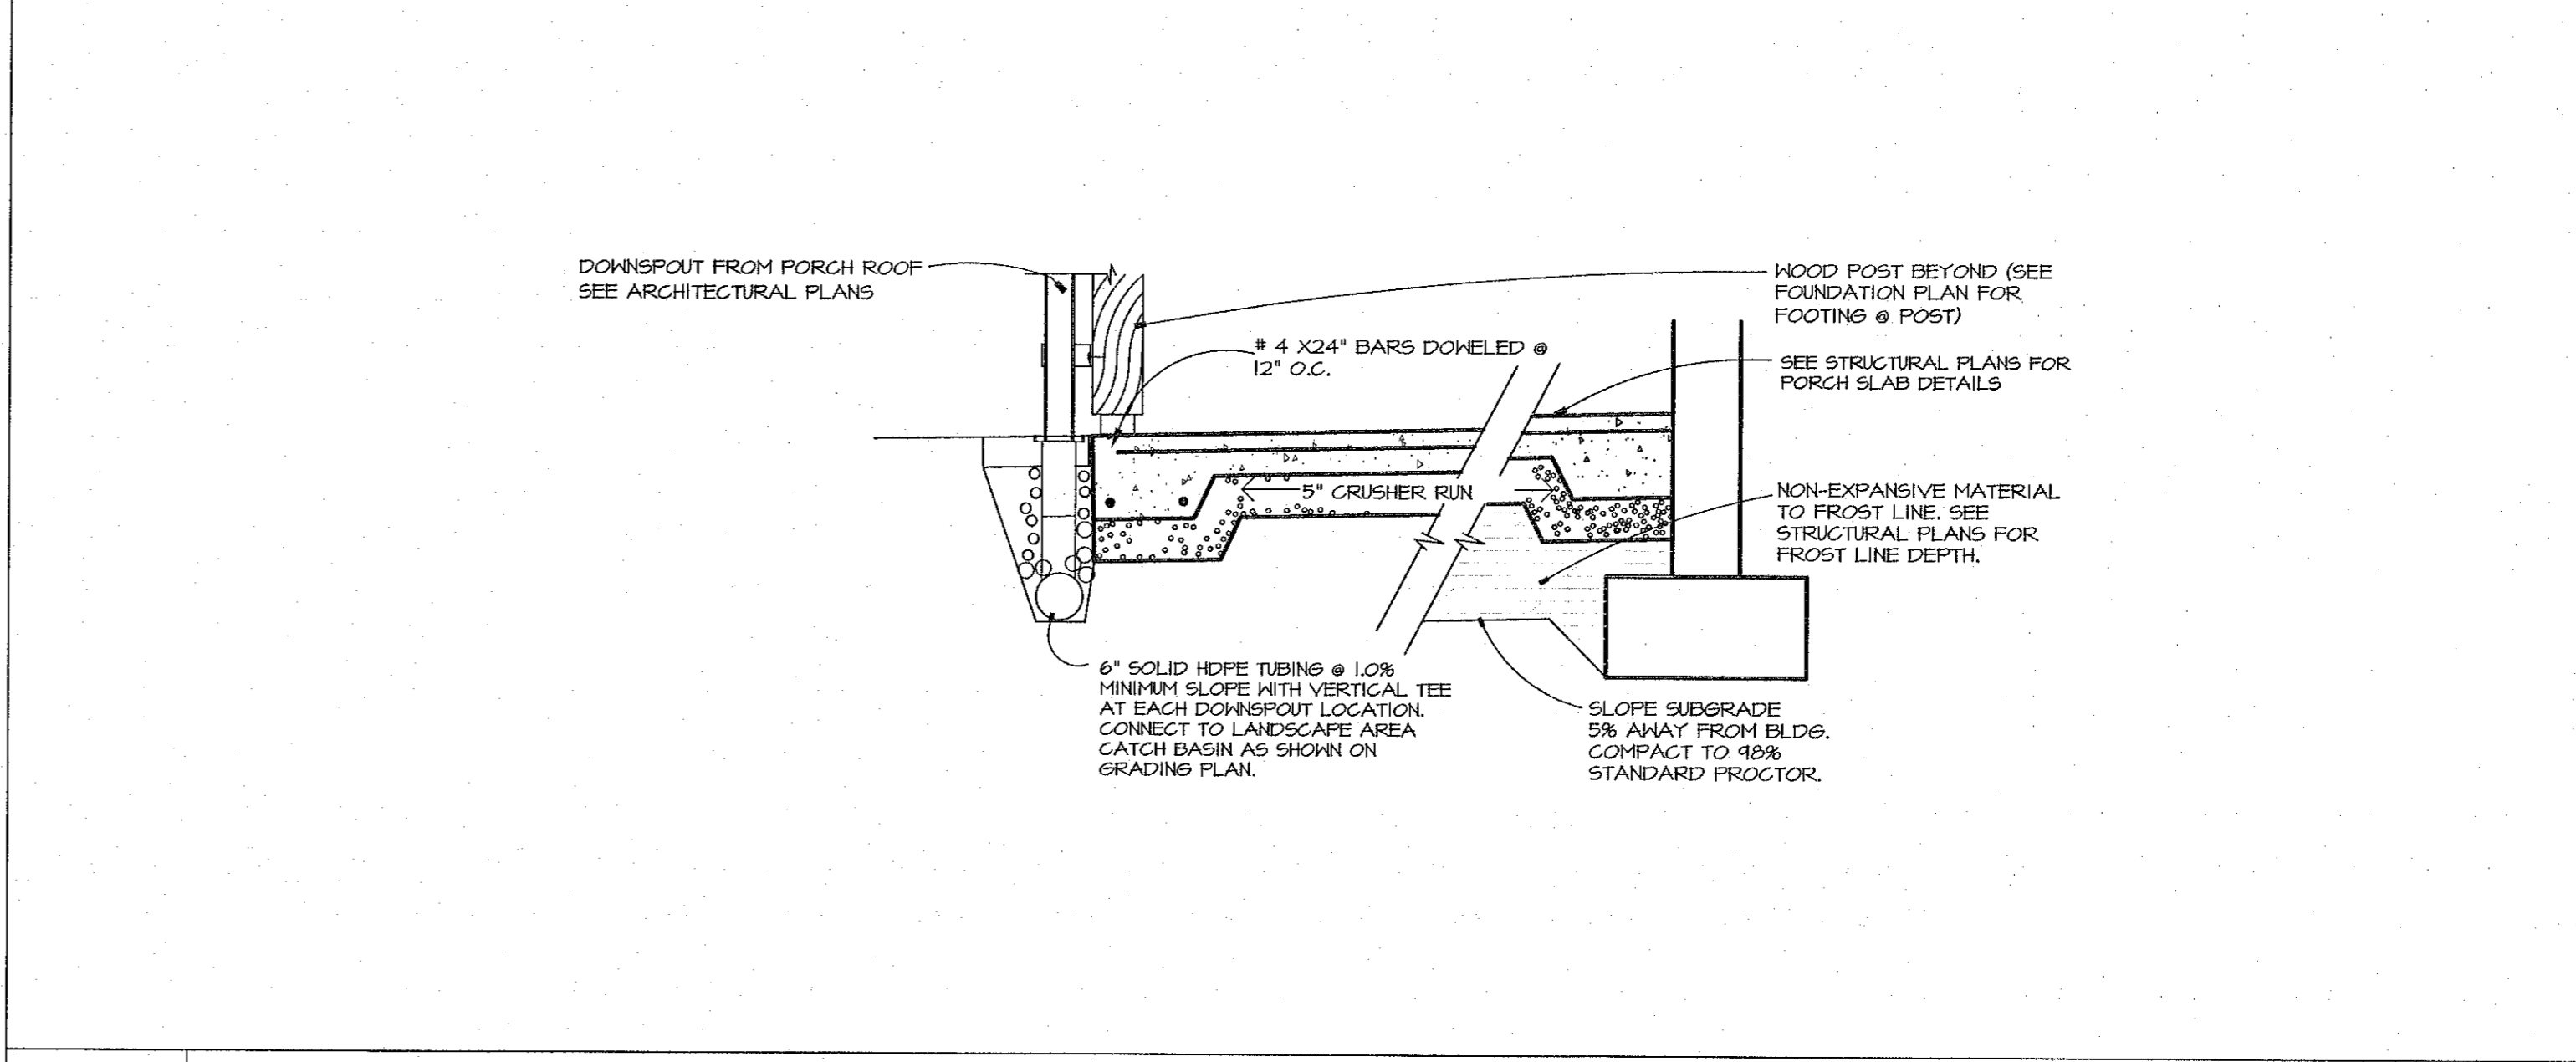

2 UNDERGROUND DRAINAGE SYSTEM DETAIL Not to Scale

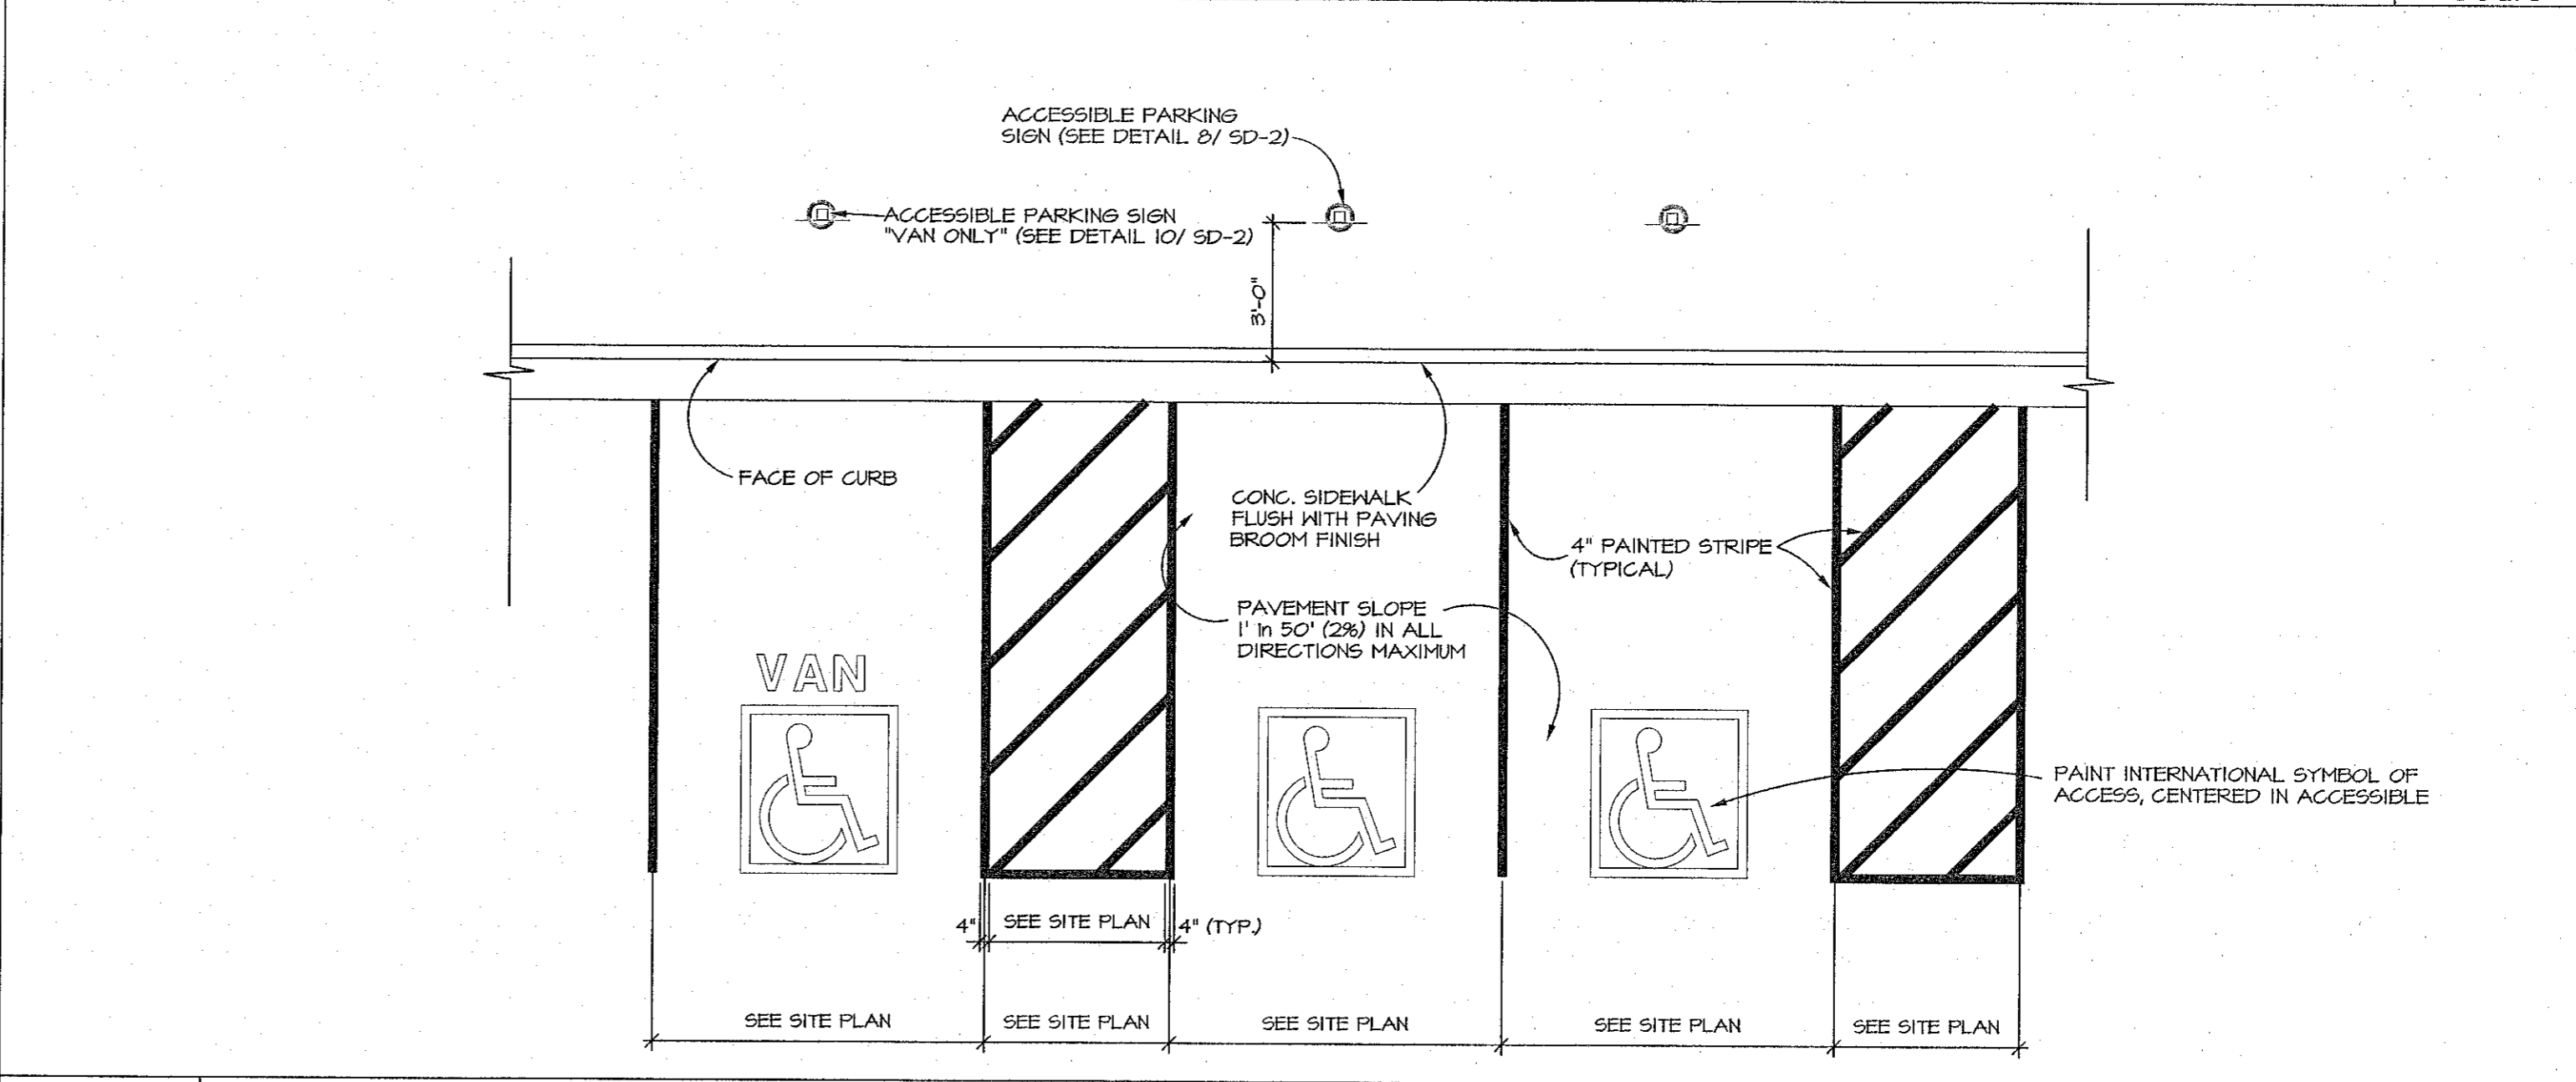

3 ACCESSIBLE PARKING STALL DETAIL Not to Scale

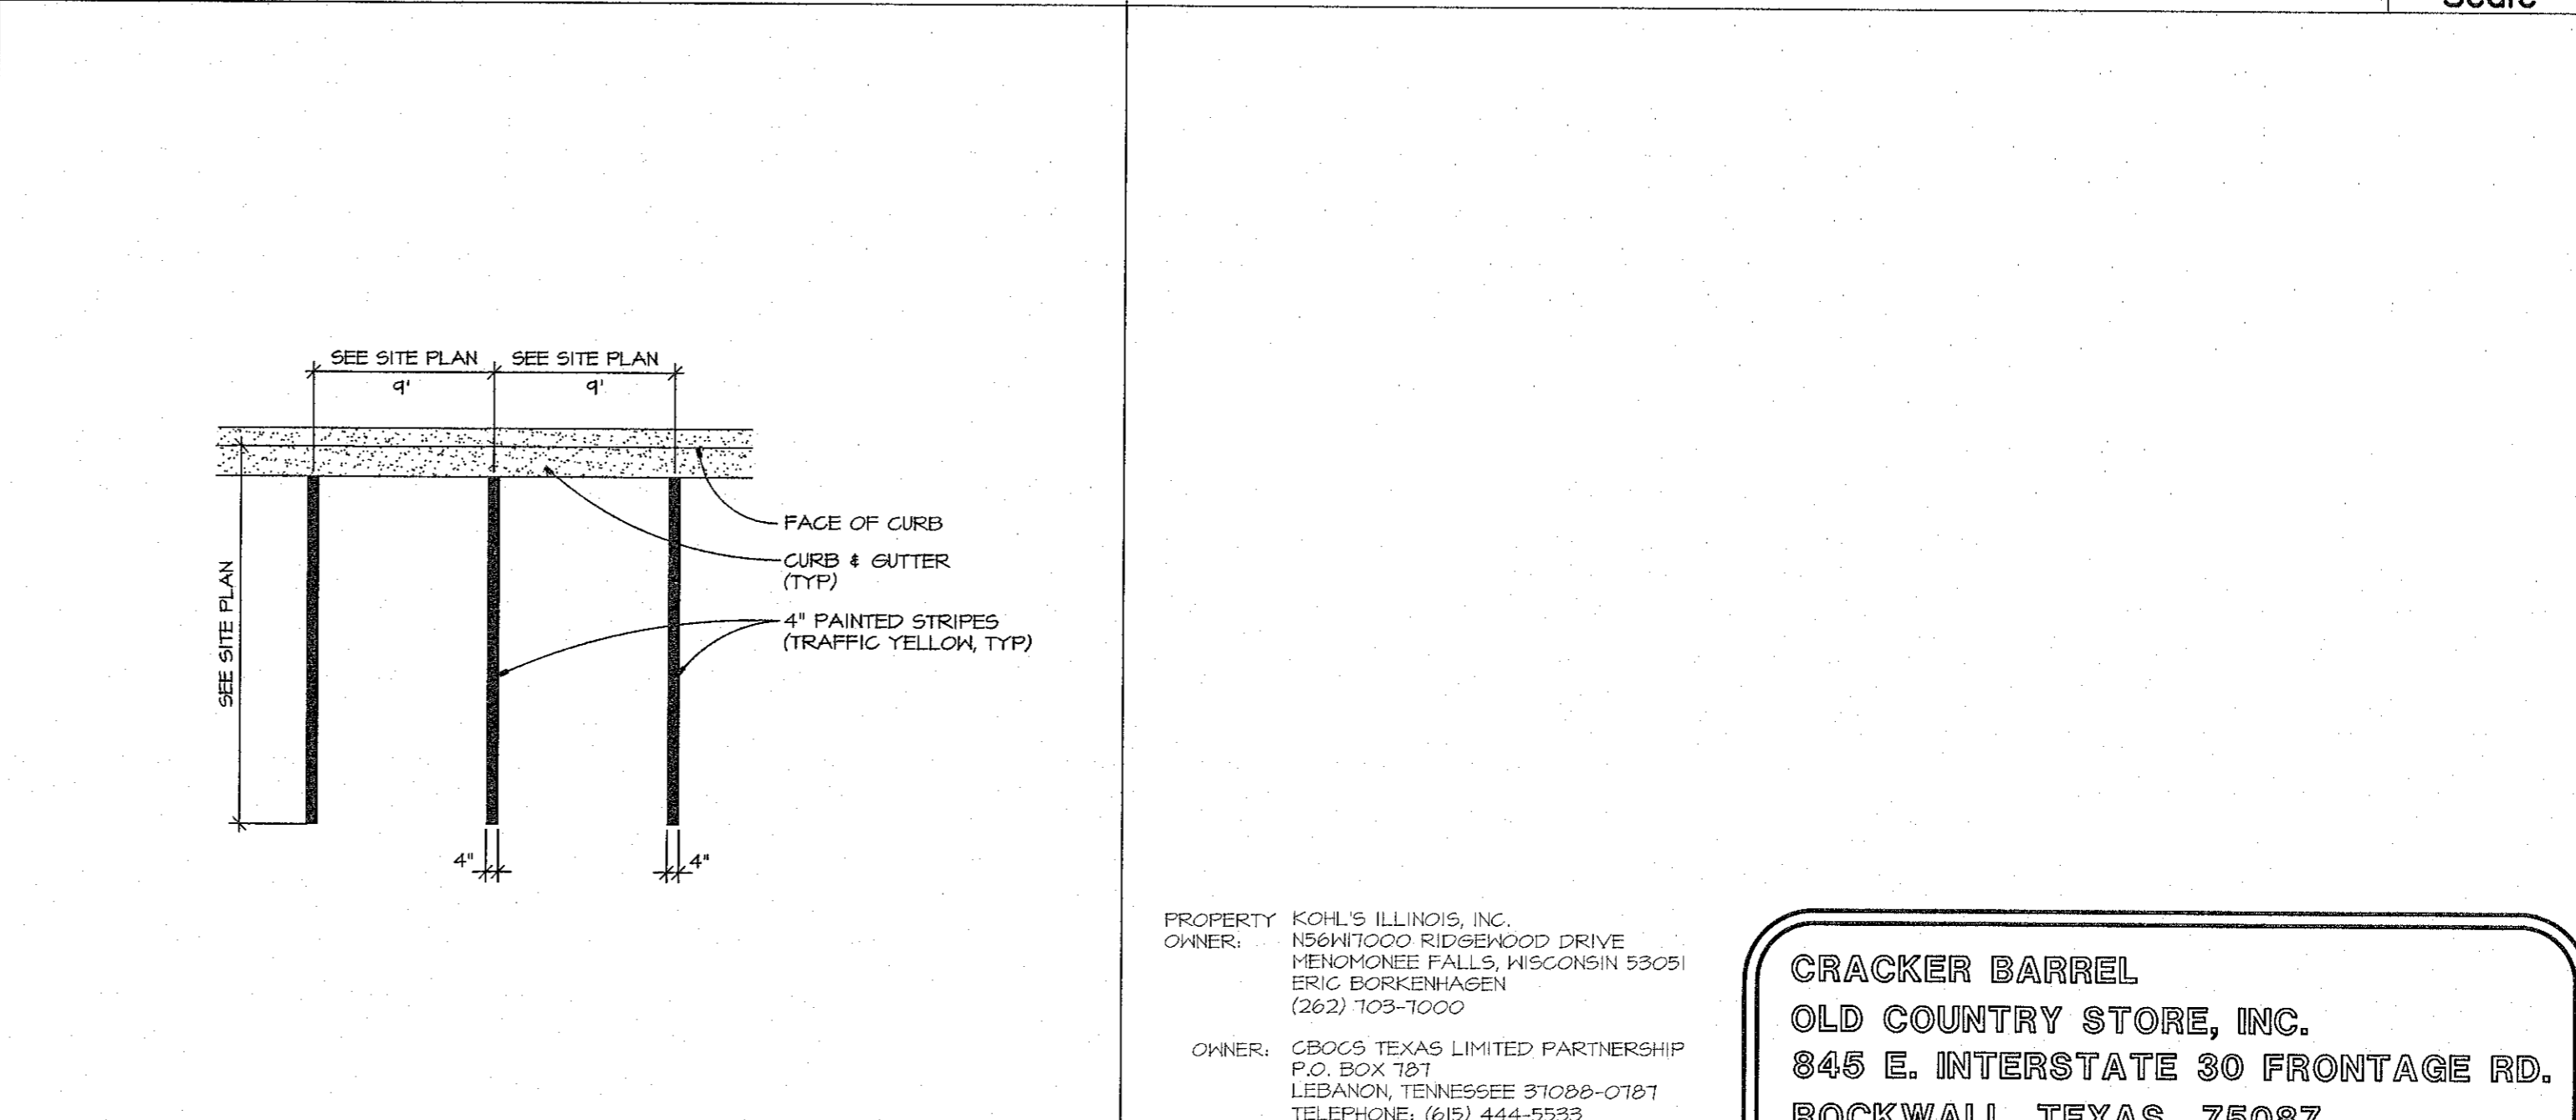


6 CAR STALL STRIPING DETAIL Not to Scale

PROPERTY: KOHL'S ILLINOIS, INC.
 OWNER: 15641000 RIDGEBROOK DRIVE
 MENOMONEE FALLS, WISCONSIN 53051
 ERIC BORKENHAGEN
 (262) 709-7000
 OWNER: CBOCS TEXAS LIMITED PARTNERSHIP
 P.O. BOX 781
 LEBANON, TENNESSEE 37088-0781
 TELEPHONE: (615) 444-5533
 PLANS PREPARED BY: JAMES A. CRAIG, P.E.
 DESIGN AND ENGINEERING, INC.
 1645 WESTGATE CIRCLE
 BRENTWOOD, TENNESSEE 37027
 (615) 370-1174

CRACKER BARREL
 OLD COUNTRY STORE, INC.
 845 E. INTERSTATE 30 FRONTAGE RD.
 ROCKWALL, TEXAS 75087
 BLOCK A, LOT 1
 CASE NUMBER: SP2018-028

CRACKER BARREL PROJECT NUMBER: CB 164 ROCKWALL, TX -08
CRACKER BARREL
 OLD COUNTRY STORE, INC.
 845 E. INTERSTATE 30
 ROCKWALL, TEXAS 75087
 These construction documents are the exclusive property of Cracker Barrel Old Country Store, Inc. and may not be used or reproduced without written permission of Cracker Barrel Old Country Store, Inc.

Cracker Barrel
 P.O. Box 787
 Hartmann Drive, Lebanon, TN. 37087

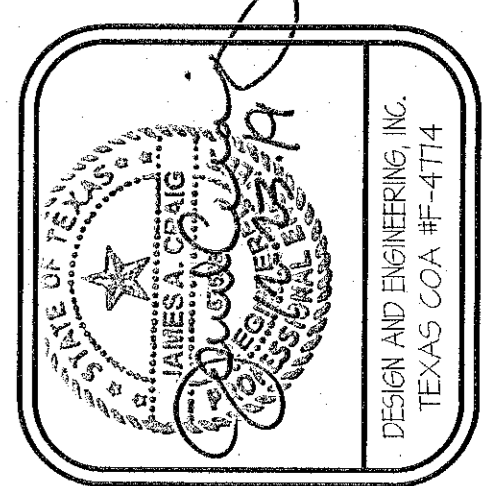

DESIGN AND ENGINEERING, INC.
 STRUCTURAL AND CIVIL ENGINEERS
 1645 Westgate Circle
 Brentwood, TN 37027
 615-370-1179
 Fax: 370-9108
 www.dandenginc.us

DATE: 12-18-18
 PROJECT NO: 11-16-18

REVISIONS	DATE	BY

Cracker Barrel
 Old Country Store
 RECORD STANDARD DETAILS
RSD-1
 PROTO 176-18F