


- NOTES:
1. 4000 P.S.I. CONC. @ 28 DAYS
 2. PROVIDE 1/8\"/>
 - 3. PROVIDE BROOM FINISH.



1 VALVE BOX DETAIL Not to Scale

2 CITY OF ROCKWALL FIRE HYDRANT DETAIL Not to Scale

3 CONCRETE FLUME DETAIL Not to Scale

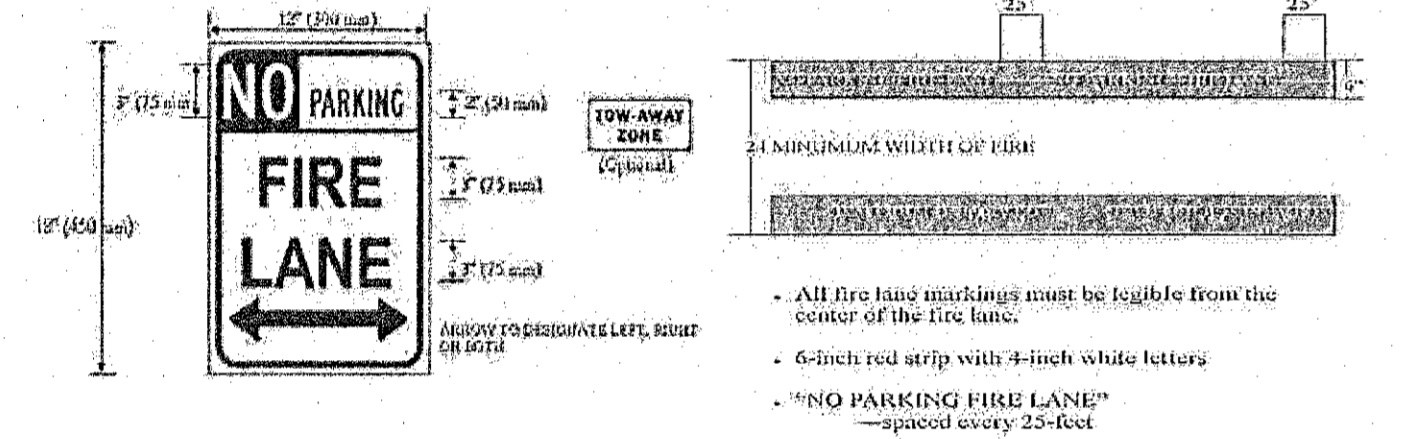

- All fire lane markings must be legible from the center of the fire lane.
- 6-inch red strip with 4-inch white letters "NO PARKING FIRE LANE" spaced every 25-feet


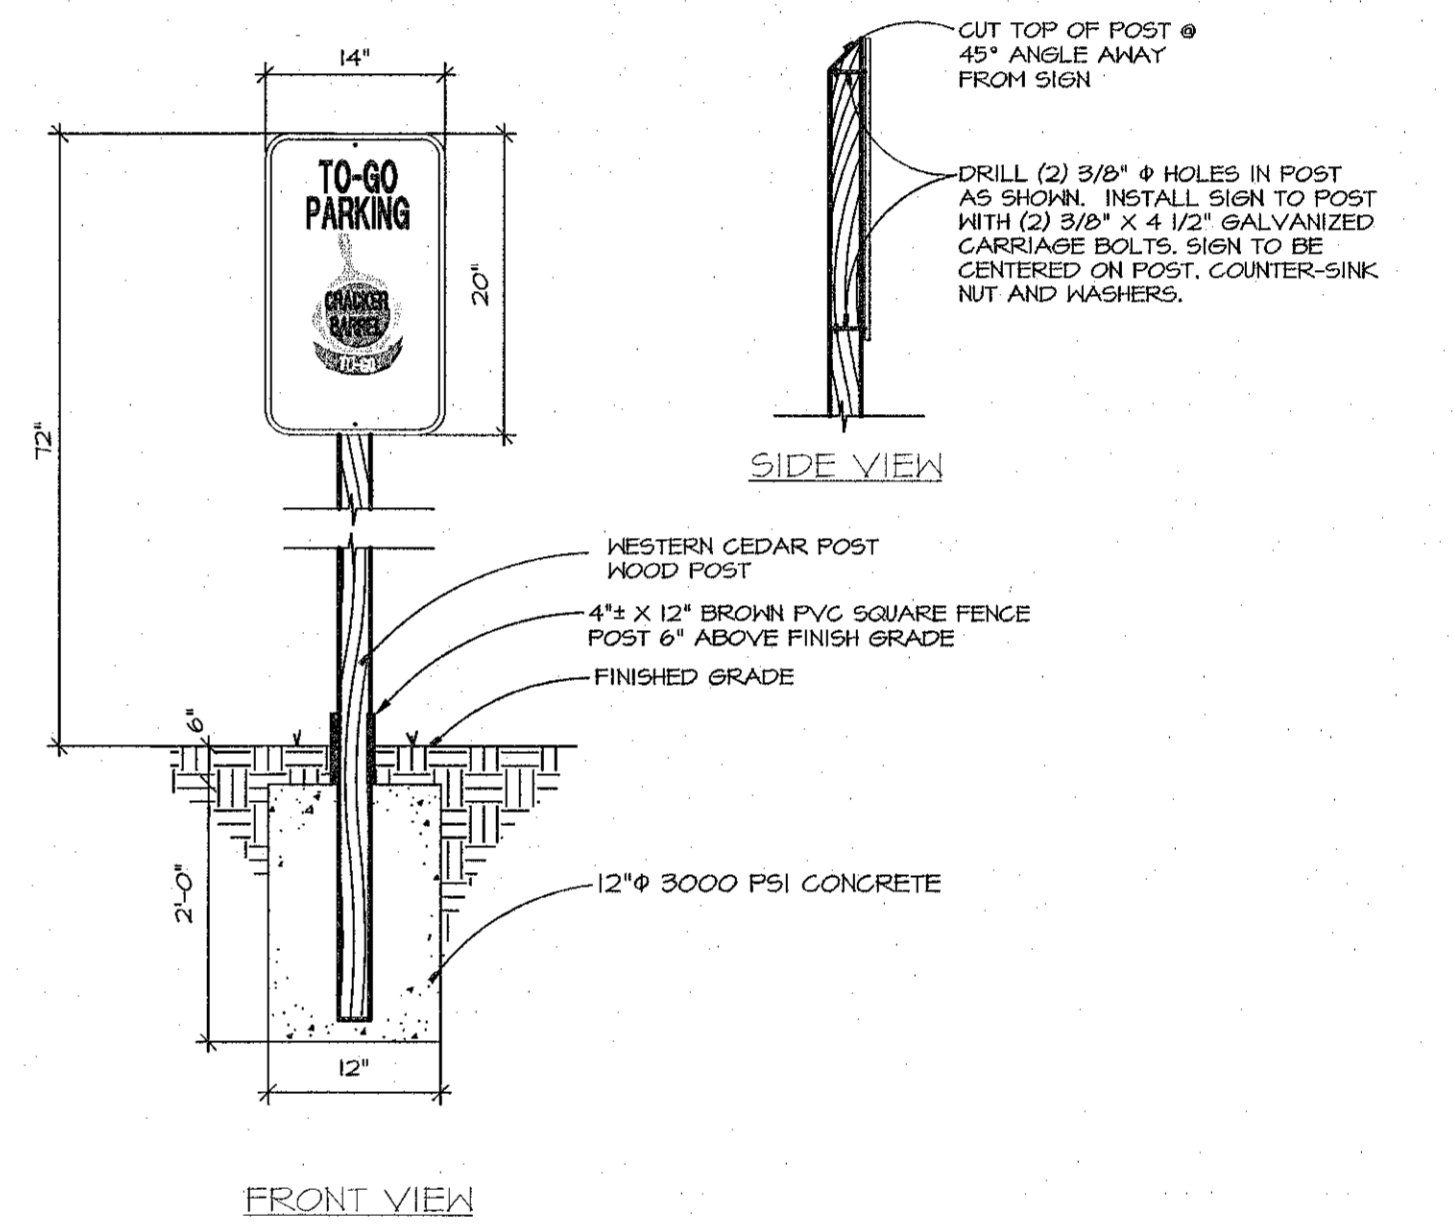
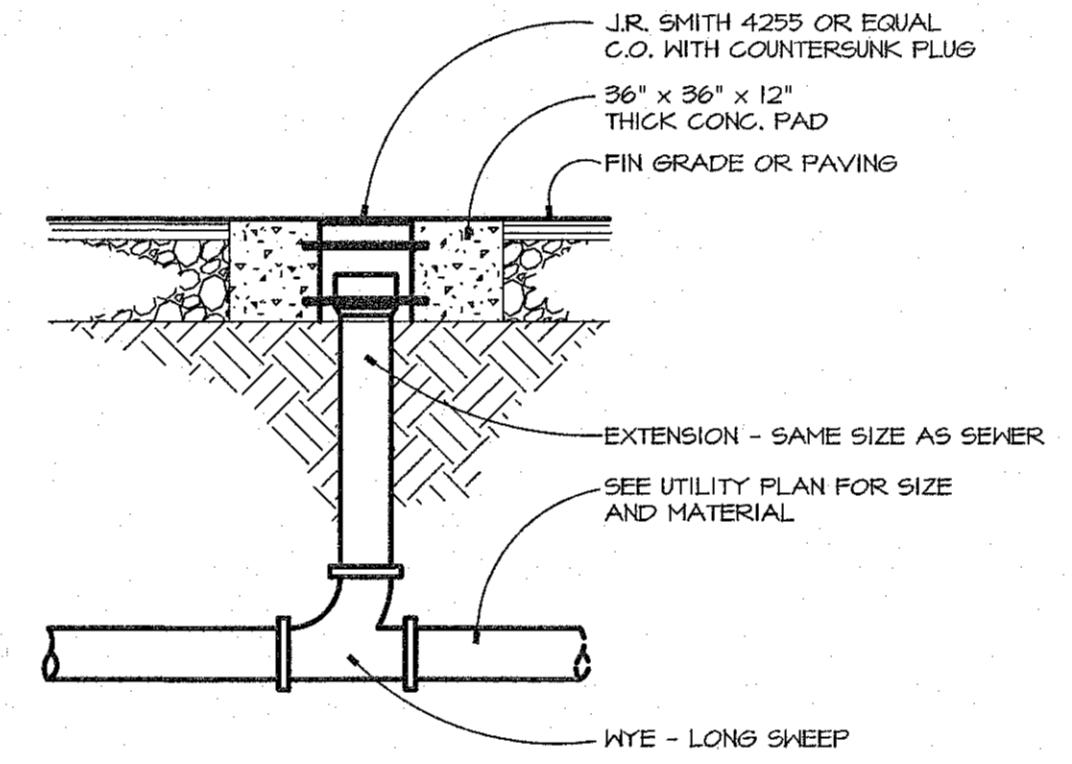


4 FIRE LANE MARKING DETAIL Not to Scale

5 NOT USED Not to Scale

6 EXTERIOR CLEANOUT DETAIL IN TRAFFIC AREAS Not to Scale

7 TO-GO PARKING SIGN DETAIL Not to Scale

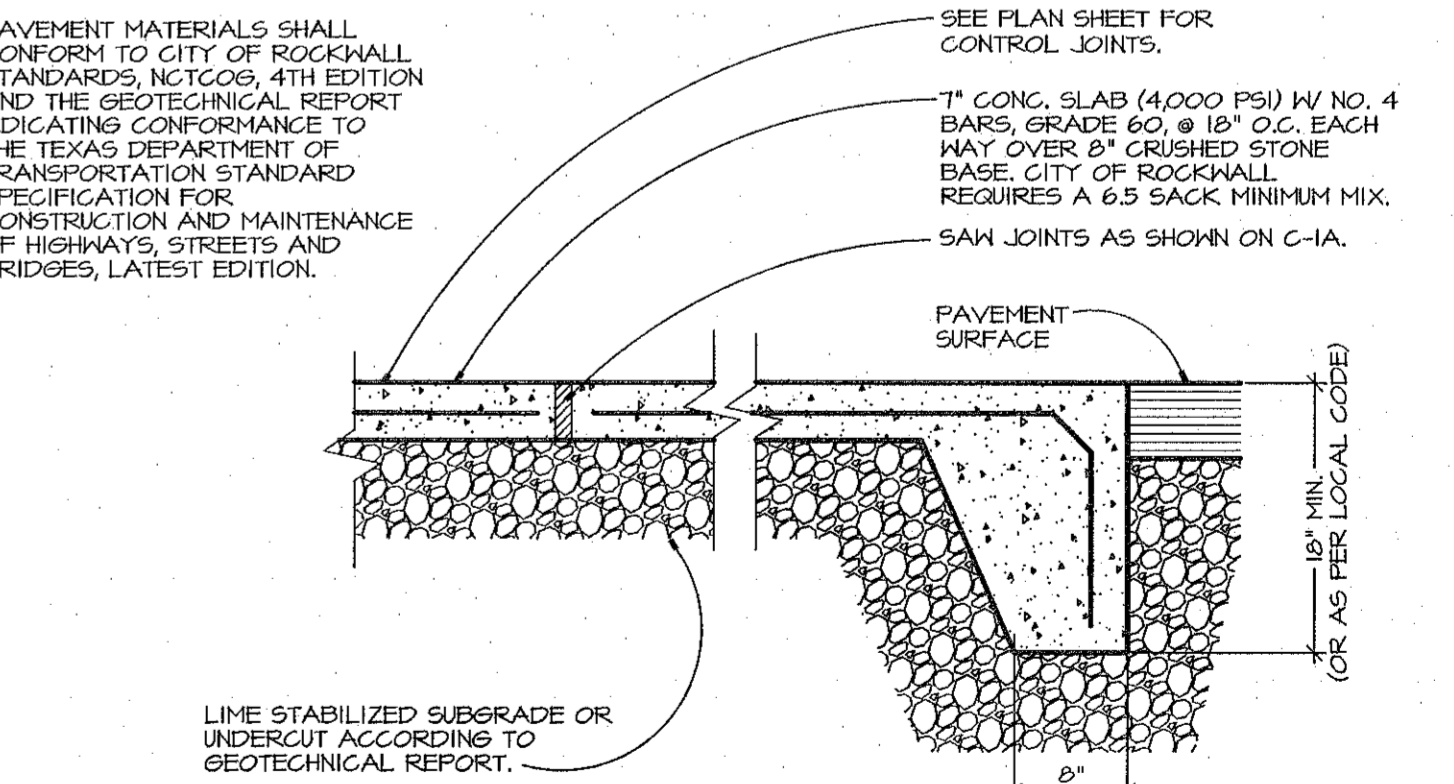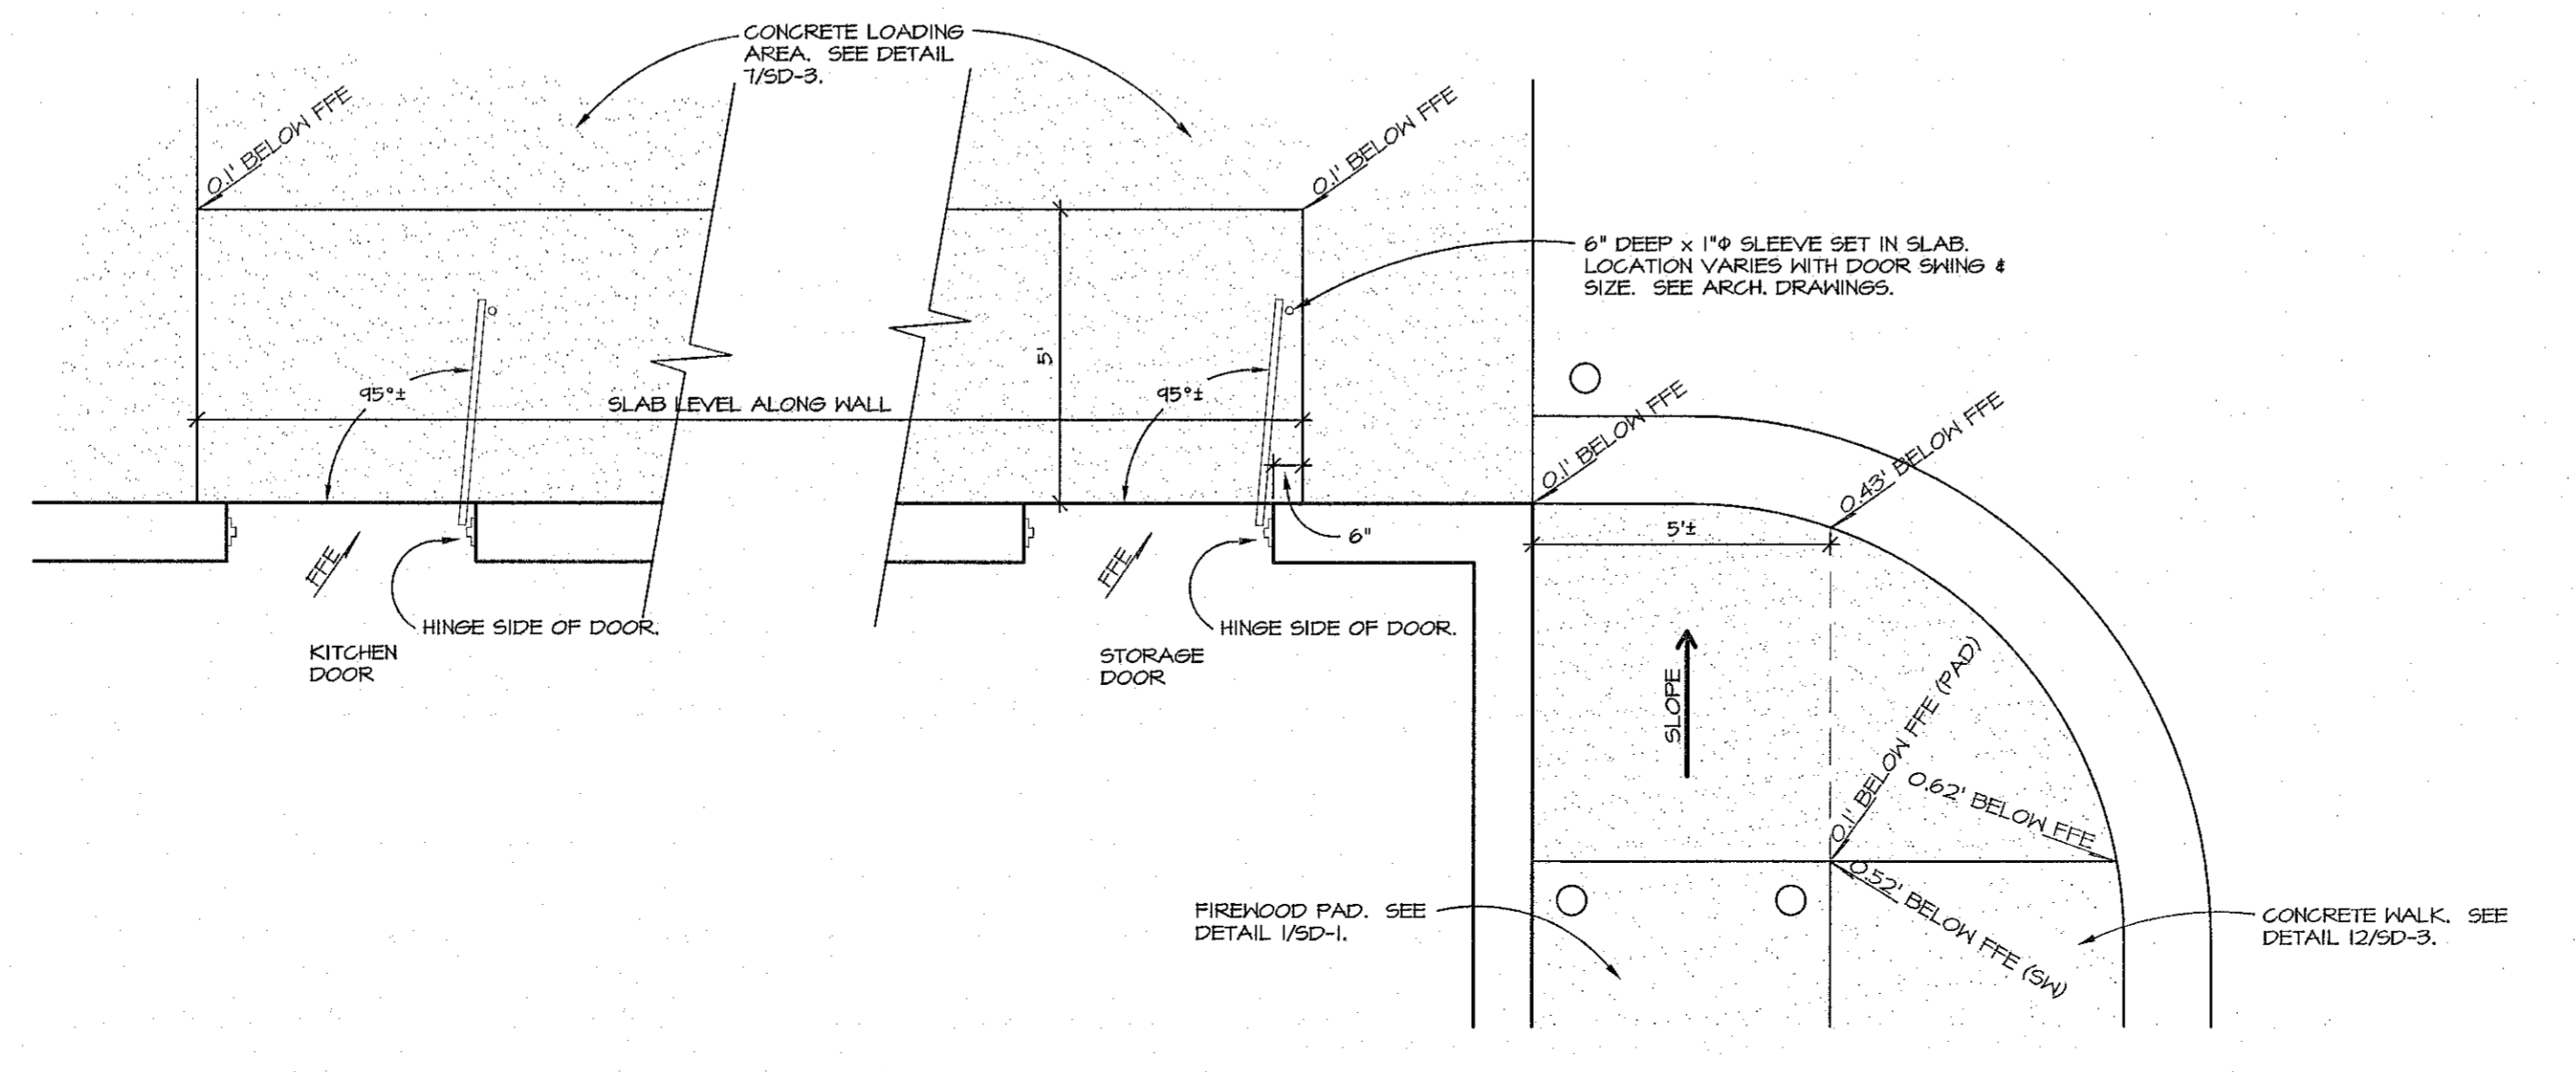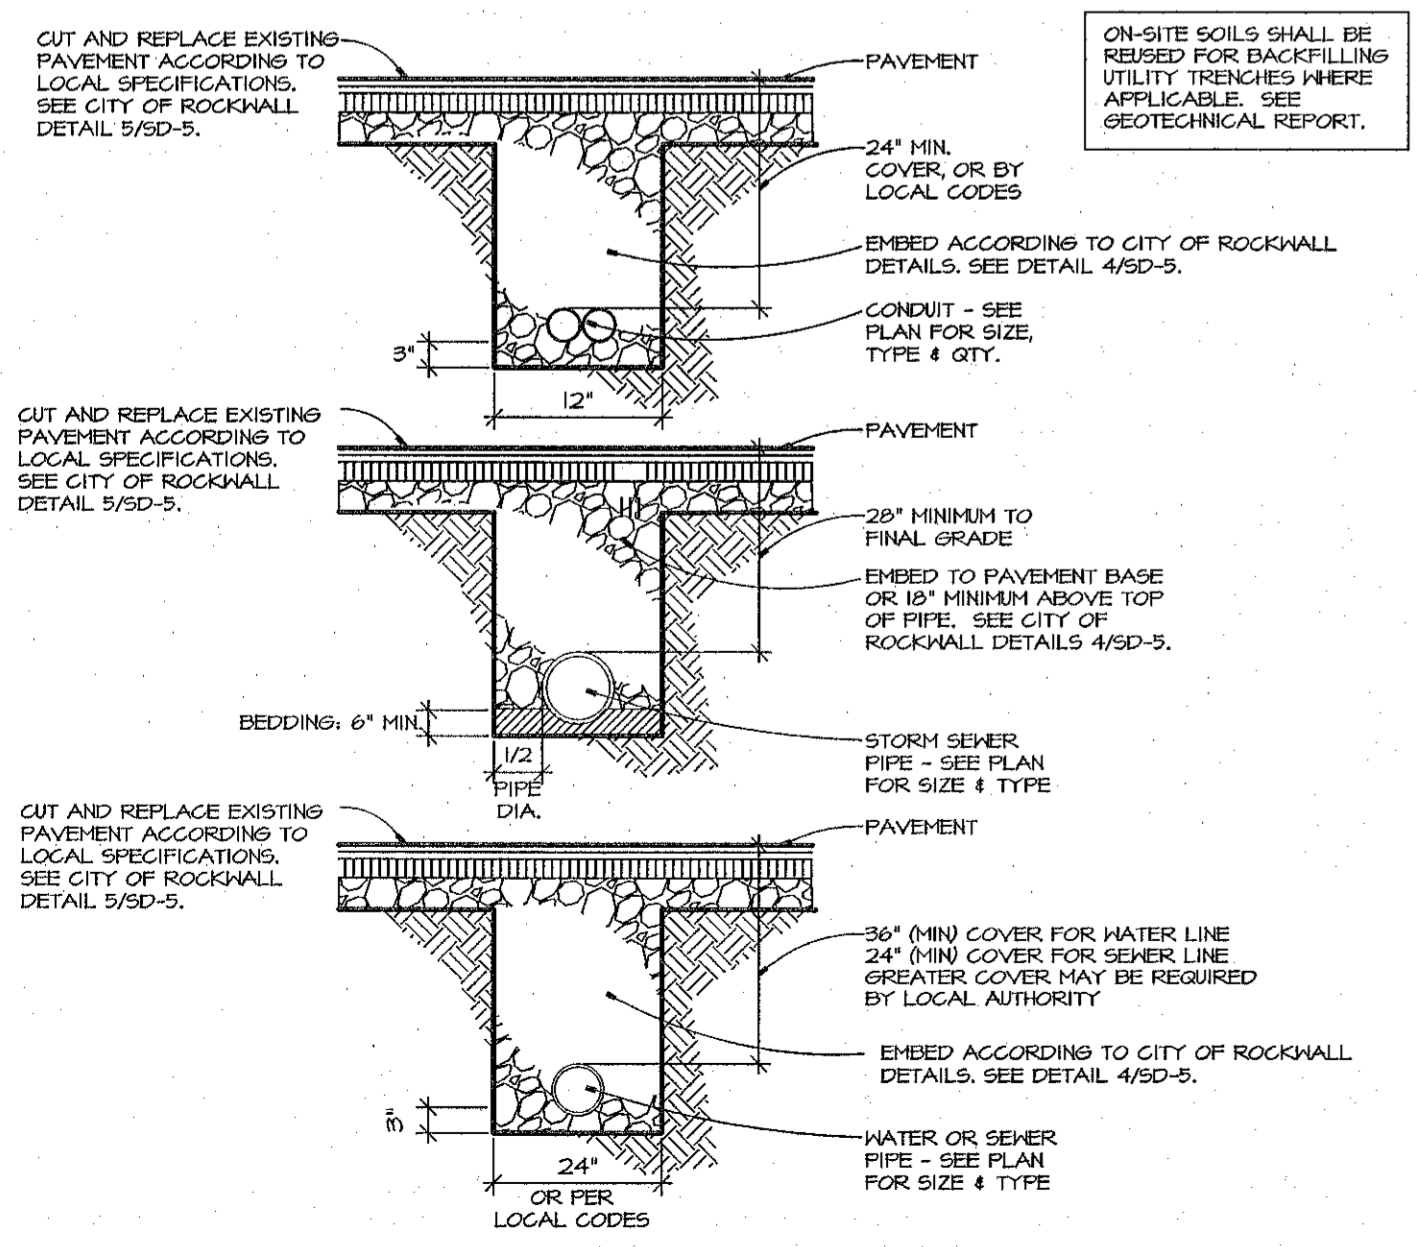

8 TRENCH DETAIL Not to Scale

9 SERVICE DOOR RAMP DETAIL Not to Scale

10 HEAVY DUTY CONCRETE PAVEMENT DETAIL Not to Scale

PROPERTY OWNER: KOHL'S ILLINOIS, INC. 156H1000 RIDGEBROOK DRIVE MENOMONEE FALLS, WISCONSIN 53051 ERIC BORKENWAGEN (262) 103-1000


OWNER: CBOCS TEXAS LIMITED PARTNERSHIP P.O. BOX 121 LEBANON, TENNESSEE 37088-0121 TELEPHONE: (615) 444-5593

PLANS PREPARED BY: JAMES A. CRAIG, P.E. DESIGN AND ENGINEERING, INC. 645 HESTGATE CIRCLE BRENTWOOD, TENNESSEE 37027 (615) 370-1714

CRACKER BARREL OLD COUNTRY STORE, INC.
845 E. INTERSTATE 30 FRONTAGE RD. ROCKWALL, TEXAS 75087
BLOCK A, LOT 1
CASE NUMBER: SP2018-028

CRACKER BARREL PROJECT NUMBER: CB 764 ROCKWALL, TX -03
CRACKER BARREL OLD COUNTRY STORE, INC.
845 EAST INTERSTATE 30
ROCKWALL, TEXAS 75087

Cracker Barrel
P.O. Box 787
Hartmann Drive, Lebanon, TN. 37087

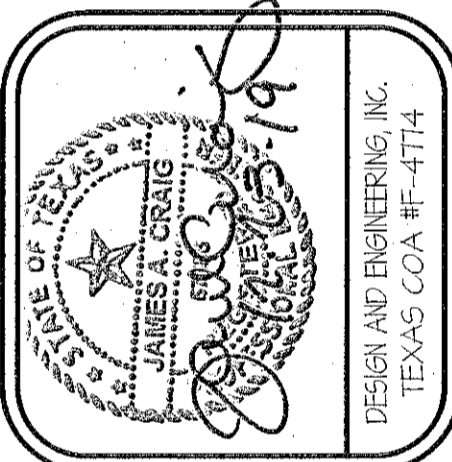

1645 Westgate Circle
Brentwood, TN 37027
615-370-1719
fax: 370-9108
www.dandenginc.us

DESIGN AND ENGINEERING
INC.
STRUCTURAL AND CIVIL ENGINEERS

DATE: 12-18-18
PROJECT NO.: 18-1645

NO.	REVISIONS

Cracker Barrel
Old Country Store

RECORD STANDARD DETAILS

RSD-4
PROTO 176-11F