

CRACKER BARREL PROJECT NUMBER: 03 164 ROCKWALL, TX -03

**CRACKER BARREL**

**OLD COUNTRY STORE, INC.**

845 EAST INTERSTATE 30

ROCKWALL, TEXAS 75087

These construction documents are the exclusive property of Cracker Barrel Old Country Store, Inc. The information contained herein may not be used or reproduced without the written permission of Cracker Barrel Old Country Store, Inc.

**Cracker Barrel**

P.O. Box 787

Hartmann Drive, Lebanon, TN. 37087






1 NOT USED

Not to Scale

2

**CITY OF ROCKWALL MANHOLE AND LID DETAILS**

Not to Scale

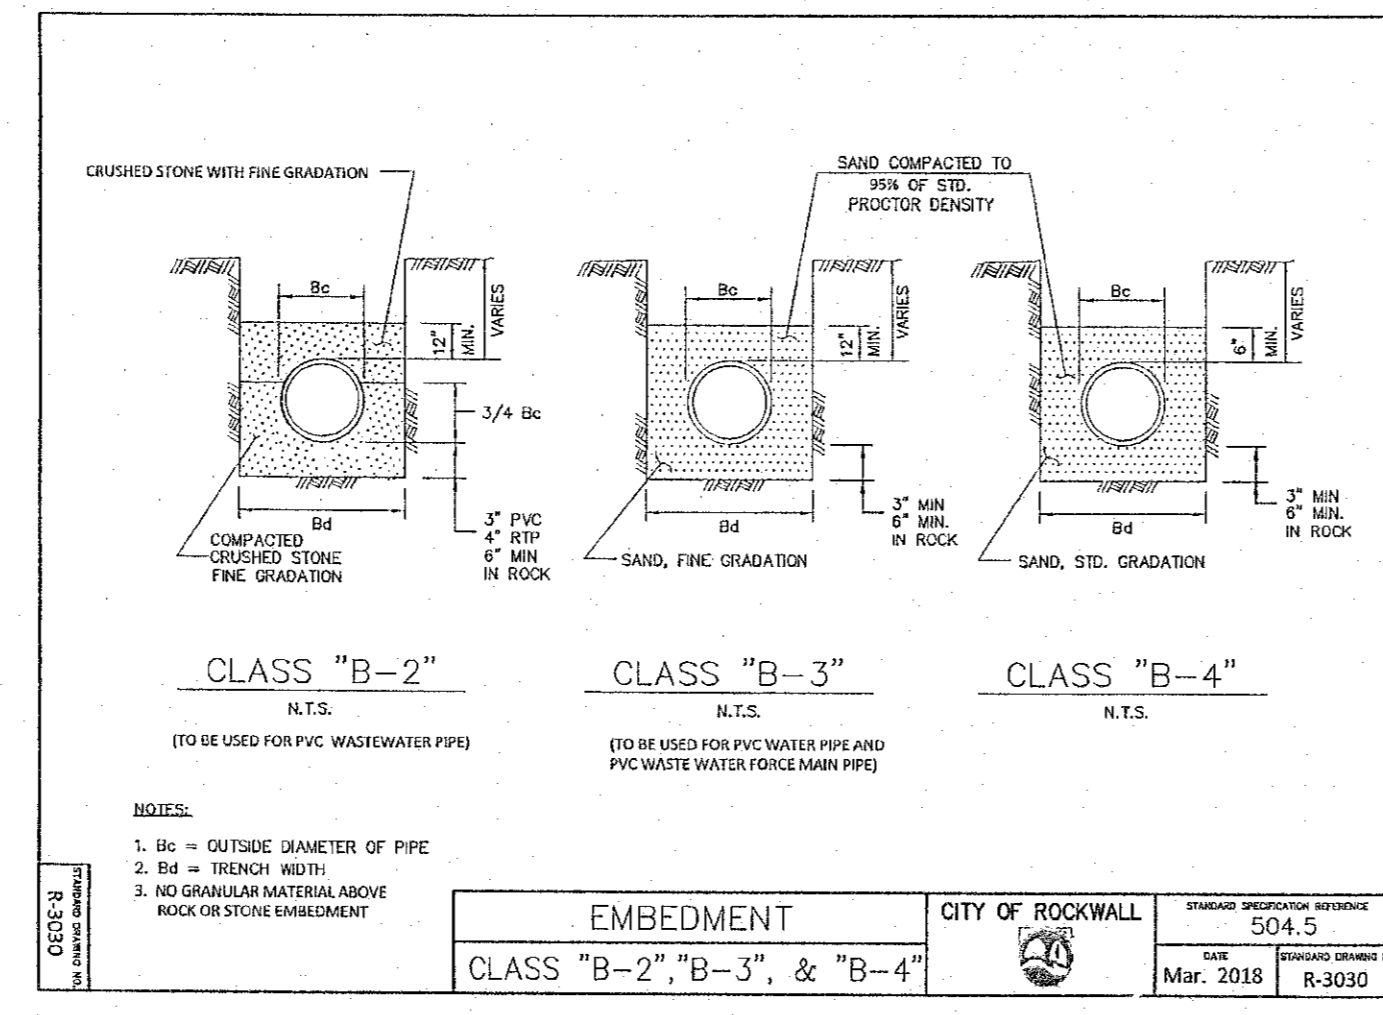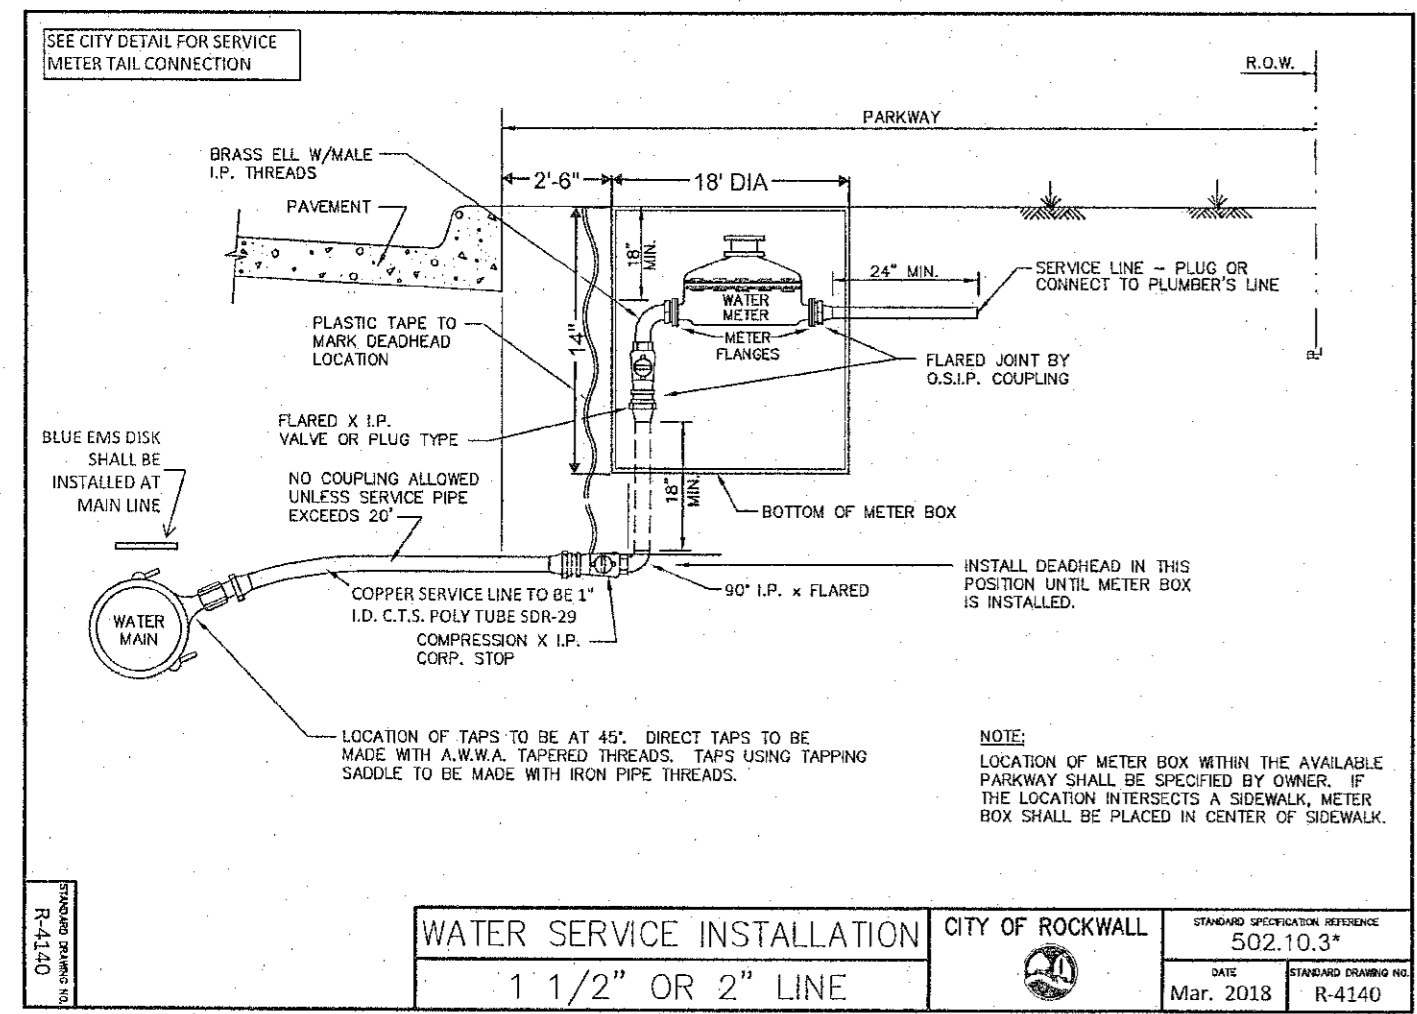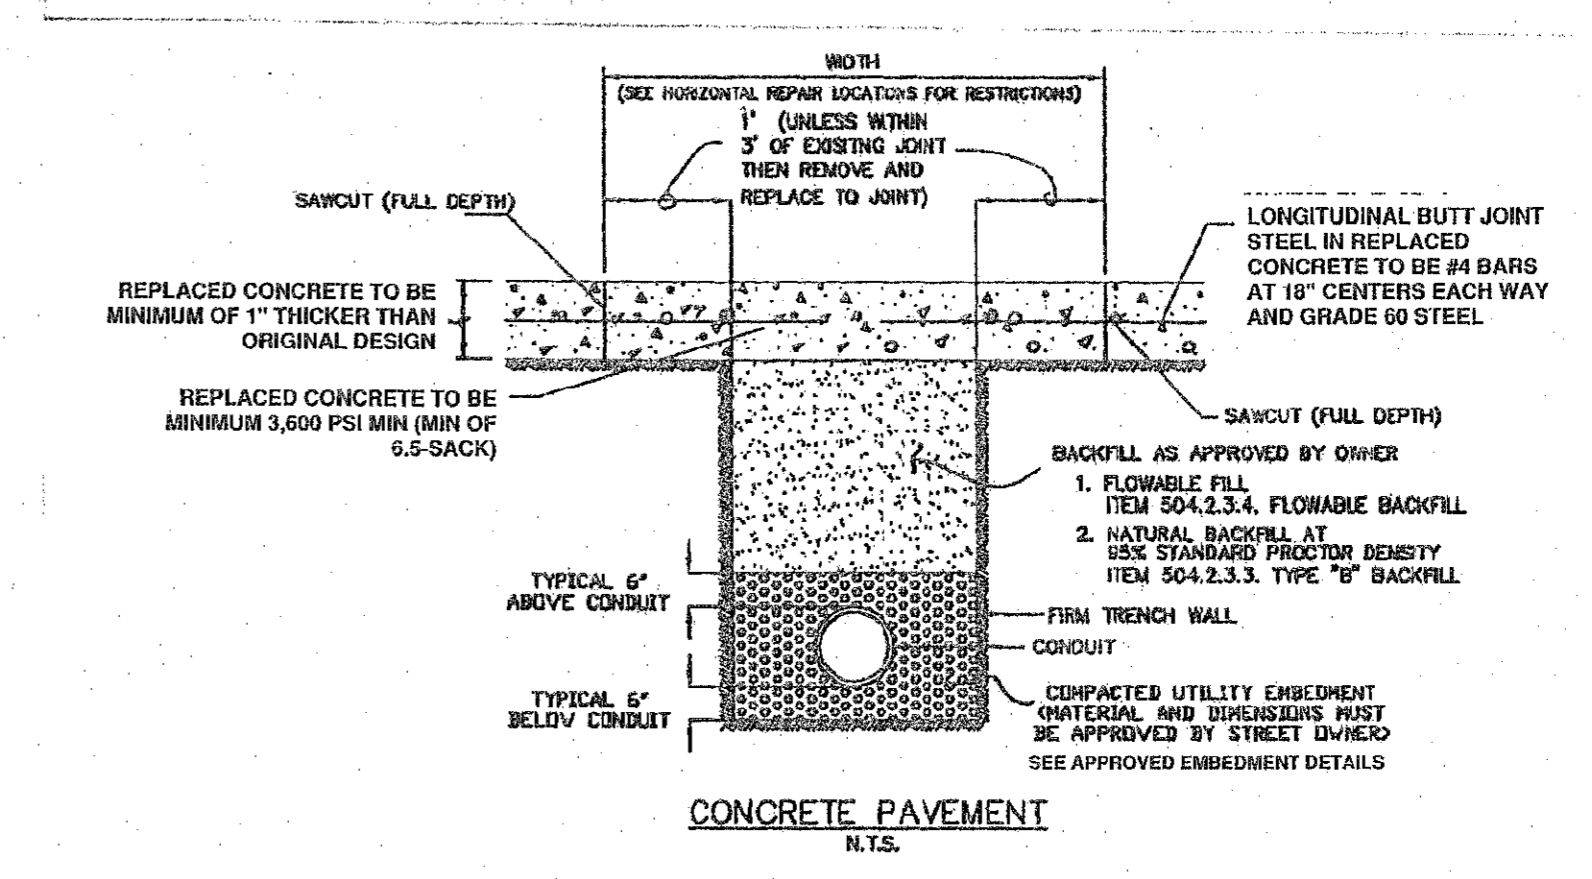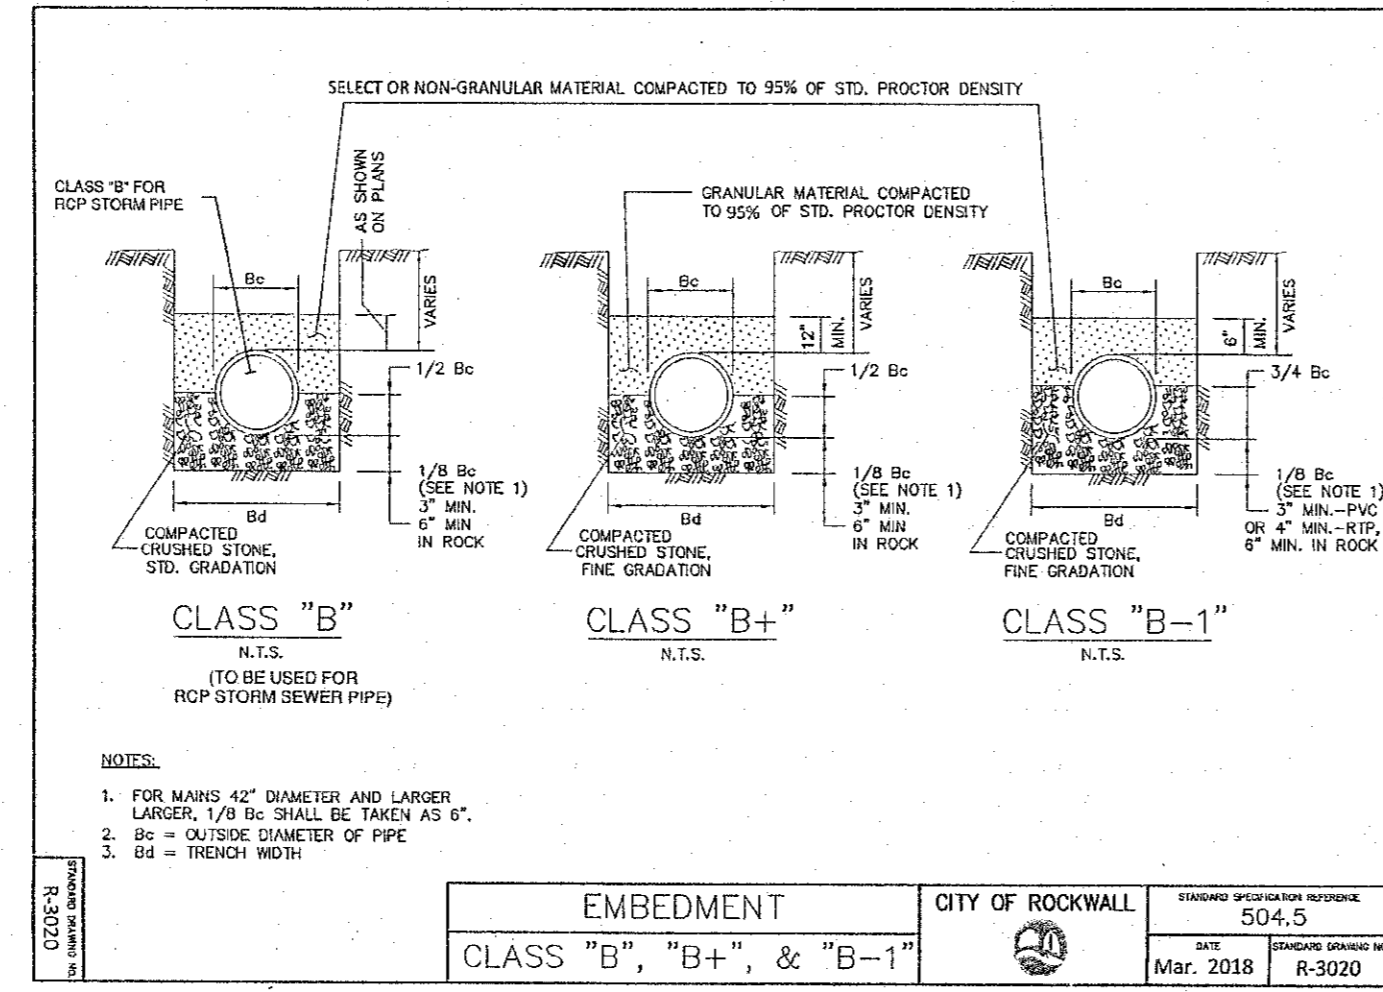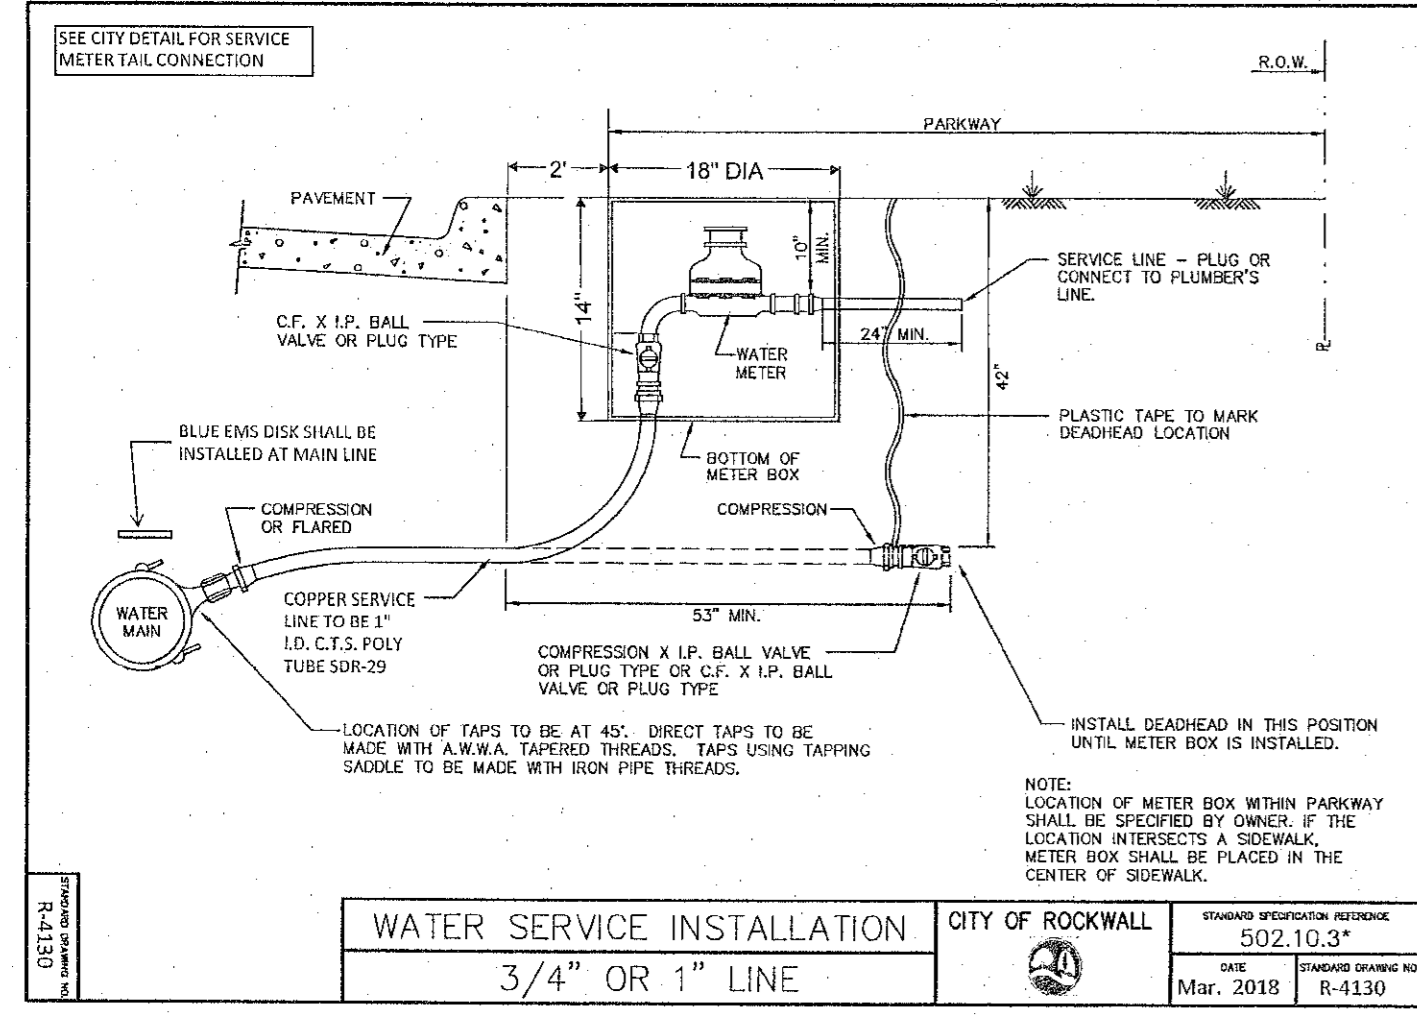

**5 CITY OF ROCKWALL CONCRETE REPLACEMENT DETAIL**

Not to Scale

PROPERTY OWNER: KOHL'S ILLINOIS, INC. 18611000 RIDGEMOOD DRIVE MEMPHIS FALLS, WISCONSIN 53051 ERIC BORKENHAGEN (262) 703-7000

OWNER: CBOC'S TEXAS LIMITED PARTNERSHIP P.O. BOX 787 LEBANON, TENNESSEE 37088-0787 TELEPHONE: (615) 444-5533

PLANS PREPARED BY: JAMES A. CRAIG, P.E. DESIGN AND ENGINEERING, INC. 1645 WESTGATE CIRCLE BRENTWOOD, TENNESSEE 37027 (615) 370-1714

**CRACKER BARREL**

**OLD COUNTRY STORE, INC.**

845 E. INTERSTATE 30

FRONTAGE RD.

ROCKWALL, TEXAS 75087

BLOCK A, LOT 1


CASE NUMBER: SP2018-028

3 CITY OF ROCKWALL DOMESTIC SERVICE LINE AND IRRIGATION LINE INSTALLATION DETAILS

Not to Scale

4 CITY OF ROCKWALL EMBEDMENT DETAILS

Not to Scale

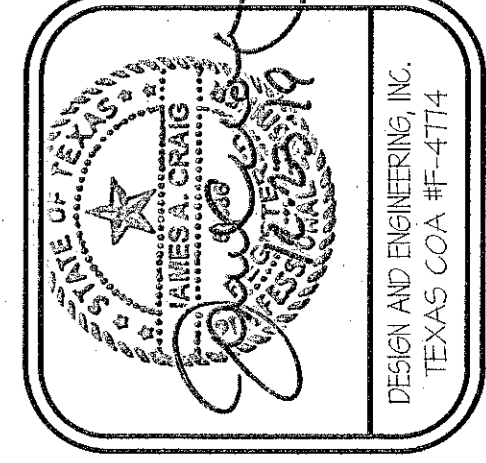

1645 Westgate Circle Brentwood, TN 37027 615-370-1779 615-370-1714 www.dandainc.us

**DESIGN and ENGINEERING**

STRUCTURAL AND CIVIL ENGINEERS

DATE: 12-18-19 PROJECT NO.: 11-16-19

REVISIONS	DATE	BY

**Cracker Barrel**

Old Country Store

RECORD STANDARD DETAILS

**RSD-5**

PROTO 176-19F