


BENCHMARKS:

BRASS DISK IN CONG. MONUMENT, 50' ± NORTH OF BACK OF CURB ON THE NORTH SIDE OF RIDGE ROAD WEST 500' ± EAST OF MURFIELD DRIVE (CITY OF ROCKWALL MONUMENT #9)
ELEV. 502.67

BRASS DISK IN CONG. MONUMENT, IN MEDIAN OF NORTH LAKESHORE DRIVE 150' ± NORTH OF ALAMO DRIVE (CITY OF ROCKWALL MONUMENT #10)
ELEV. 524.62

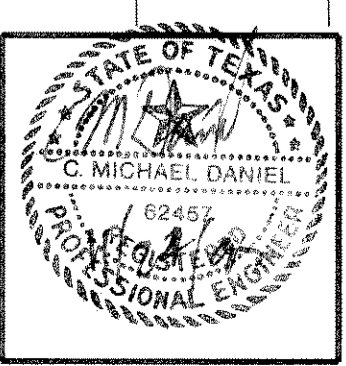

revisions	date
REVISED PER CITY REVIEW	3-20-97
REVISED	8-21-97
REVISED PER CITY REVIEW	NOV. 1997

NDM NATHAN D. MAIER
CONSULTING ENGINEERS, INC.

Three Northpark / 8800 N. Central Expy. / Suite 300
Dallas, Texas 75231 / (214) 739-4741

RECORD DRAWING
DATE: 1/26/00

THIS RECORD DRAWING HEREIN REFLECTS TO THE BEST OF THE DESIGN ENGINEER'S KNOWLEDGE THE APPROXIMATE LOCATION OF THE CONSTRUCTED WORK USING INFORMATION AS PROVIDED BY THE CONTRACTOR(S).

SANITARY SEWER PROFILES				sheet no.
CREEKSIDE THE SHORES				9
CITY OF ROCKWALL, ROCKWALL COUNTY, TEXAS				17
design	drawn	scale	date	notes
TWA	TWA	H = 100' V = 5'	2-10-97	L-SSPROF
				job number
				95-05-036L

E:\PROJECTS\95-05-036L\SSPROF.FR3 NOV 21 16:02:36 1997 RRF