


TRAFFIC CONTROL PLAN
SCALE: 1"=60'

BENCHMARKS:
BRASS DISK IN CONC. MONUMENT, 50'± NORTH OF BACK OF CURB ON THE NORTH SIDE OF RIDGE ROAD WEST 300'± EAST OF MURFIELD DRIVE (CITY OF ROCKWALL MONUMENT #8)
ELEV. 502.67
BRASS DISK IN CONC. MONUMENT, IN MEDIAN OF NORTH LAKESHORE DRIVE 150'± NORTH OF ALAMO DRIVE (CITY OF ROCKWALL MONUMENT #10)
ELEV. 524.62

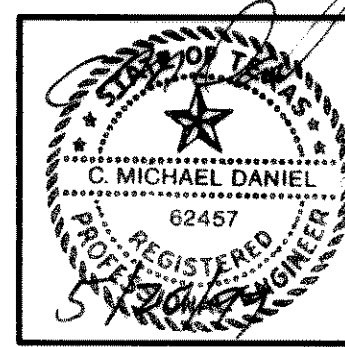

revisions	date
REVISED PER CITY REVIEW	APR. 1997
REVISED	8-21-97
ADDED TRAFFIC CONTROL & REVISED CUL DE SAC	APRIL 1999

NDM
NATHAN D. MAIER
CONSULTING ENGINEERS, INC.
Three Northpark / 8800 N. Central Expy. / Suite 300
Dallas, Texas 75231 / (214) 739-4741

RECORD DRAWING
cm
DATE: 1/26/00
THIS RECORD DRAWING HEREIN REFLECTS TO THE BEST OF THE DESIGN ENGINEER'S KNOWLEDGE THE APPROXIMATE LOCATION OF THE CONSTRUCTED WORK USING INFORMATION AS PROVIDED BY THE CONTRACTOR(S).

PAVING PLAN
RIDGE ROAD WEST
CREEKSIDE
THE SHORES
CITY OF ROCKWALL, ROCKWALL COUNTY, TEXAS

design	drawn	scale	date	notes
TWA	TWA/LJM	1" = 40'	1-20-97	L-PAV-2

sheet no.	job number
5 / 17	95-05-036.L

E:\9505036\1\shhs\1-pav-2.dwg Thu May 20 15:26:07 1999 MM