
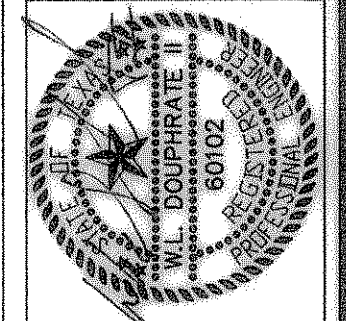


CURVE TABLE						
CURVE	LENGTH	RADIUS	TANGENT	CH BRG	CH DIST	DELTA
C2	157.95	200.00	83.35	S20°21'03"E	153.98	45°14'56"
C4	732.11	575.45	424.95	S78°55'11"E	683.72	72°33'37"
C5	176.20	296.00	90.80	N47°34'50"E	173.61	34°06'21"

**RECORD DRAWINGS:**  
 THE INTENT OF THE OWNER AND ENGINEER IS TO PROVIDE THE MOST ACCURATE RECORD PLANS AS APPROVED BY THE CITY OF ROCKWALL. THE LINES AND POINTS WERE SET ON THE GROUND FOR CONSTRUCTION ACCORDING TO SAID PLANS. THE CITY OF ROCKWALL INSPECTED THE CONSTRUCTION. THE OWNER NOR ENGINEER DID NOT VERIFY LINES OR GRADES AFTER CONSTRUCTION. WE ARE NOT AWARE OF ANY CHANGES OR REVISIONS TO THESE PLANS DURING CONSTRUCTION EXCEPT AS NOTED.

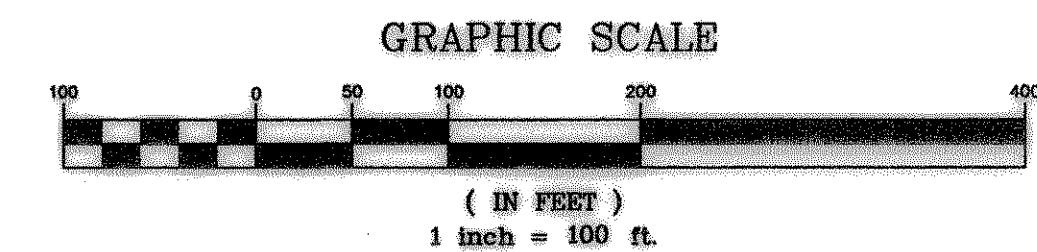

THE SEAL APPEARING ON THIS DOCUMENT WAS AUTHORIZED BY THE BOARD OF ENGINEERING EXAMINERS, STATE OF TEXAS, NO. 80102 ON 7/1/92

**DOUPHRATE & ASSOCIATES, INC.**  
 ENGINEERING - PROJECT MANAGEMENT - SURVEYING  
 2231 RIDGE RD., # 200 ROCKWALL, TEXAS 75087  
 PHONE: (972)771-8004 FAX: (972)771-9005

**SANITARY SEWER & WATER PLAN  
 CREEKSIDE VILLAGE-PHASE II  
 CITY OF ROCKWALL  
 ROCKWALL COUNTY, TEXAS**

REVISION
W.L.D. CHECKED
KEB DRAWN
3/14/00 DATE
9960WSS PROJECT
12 OF 21