


GRAPHIC SCALE




(IN FEET)
1 inch = 40 ft.
1"=4' VERT

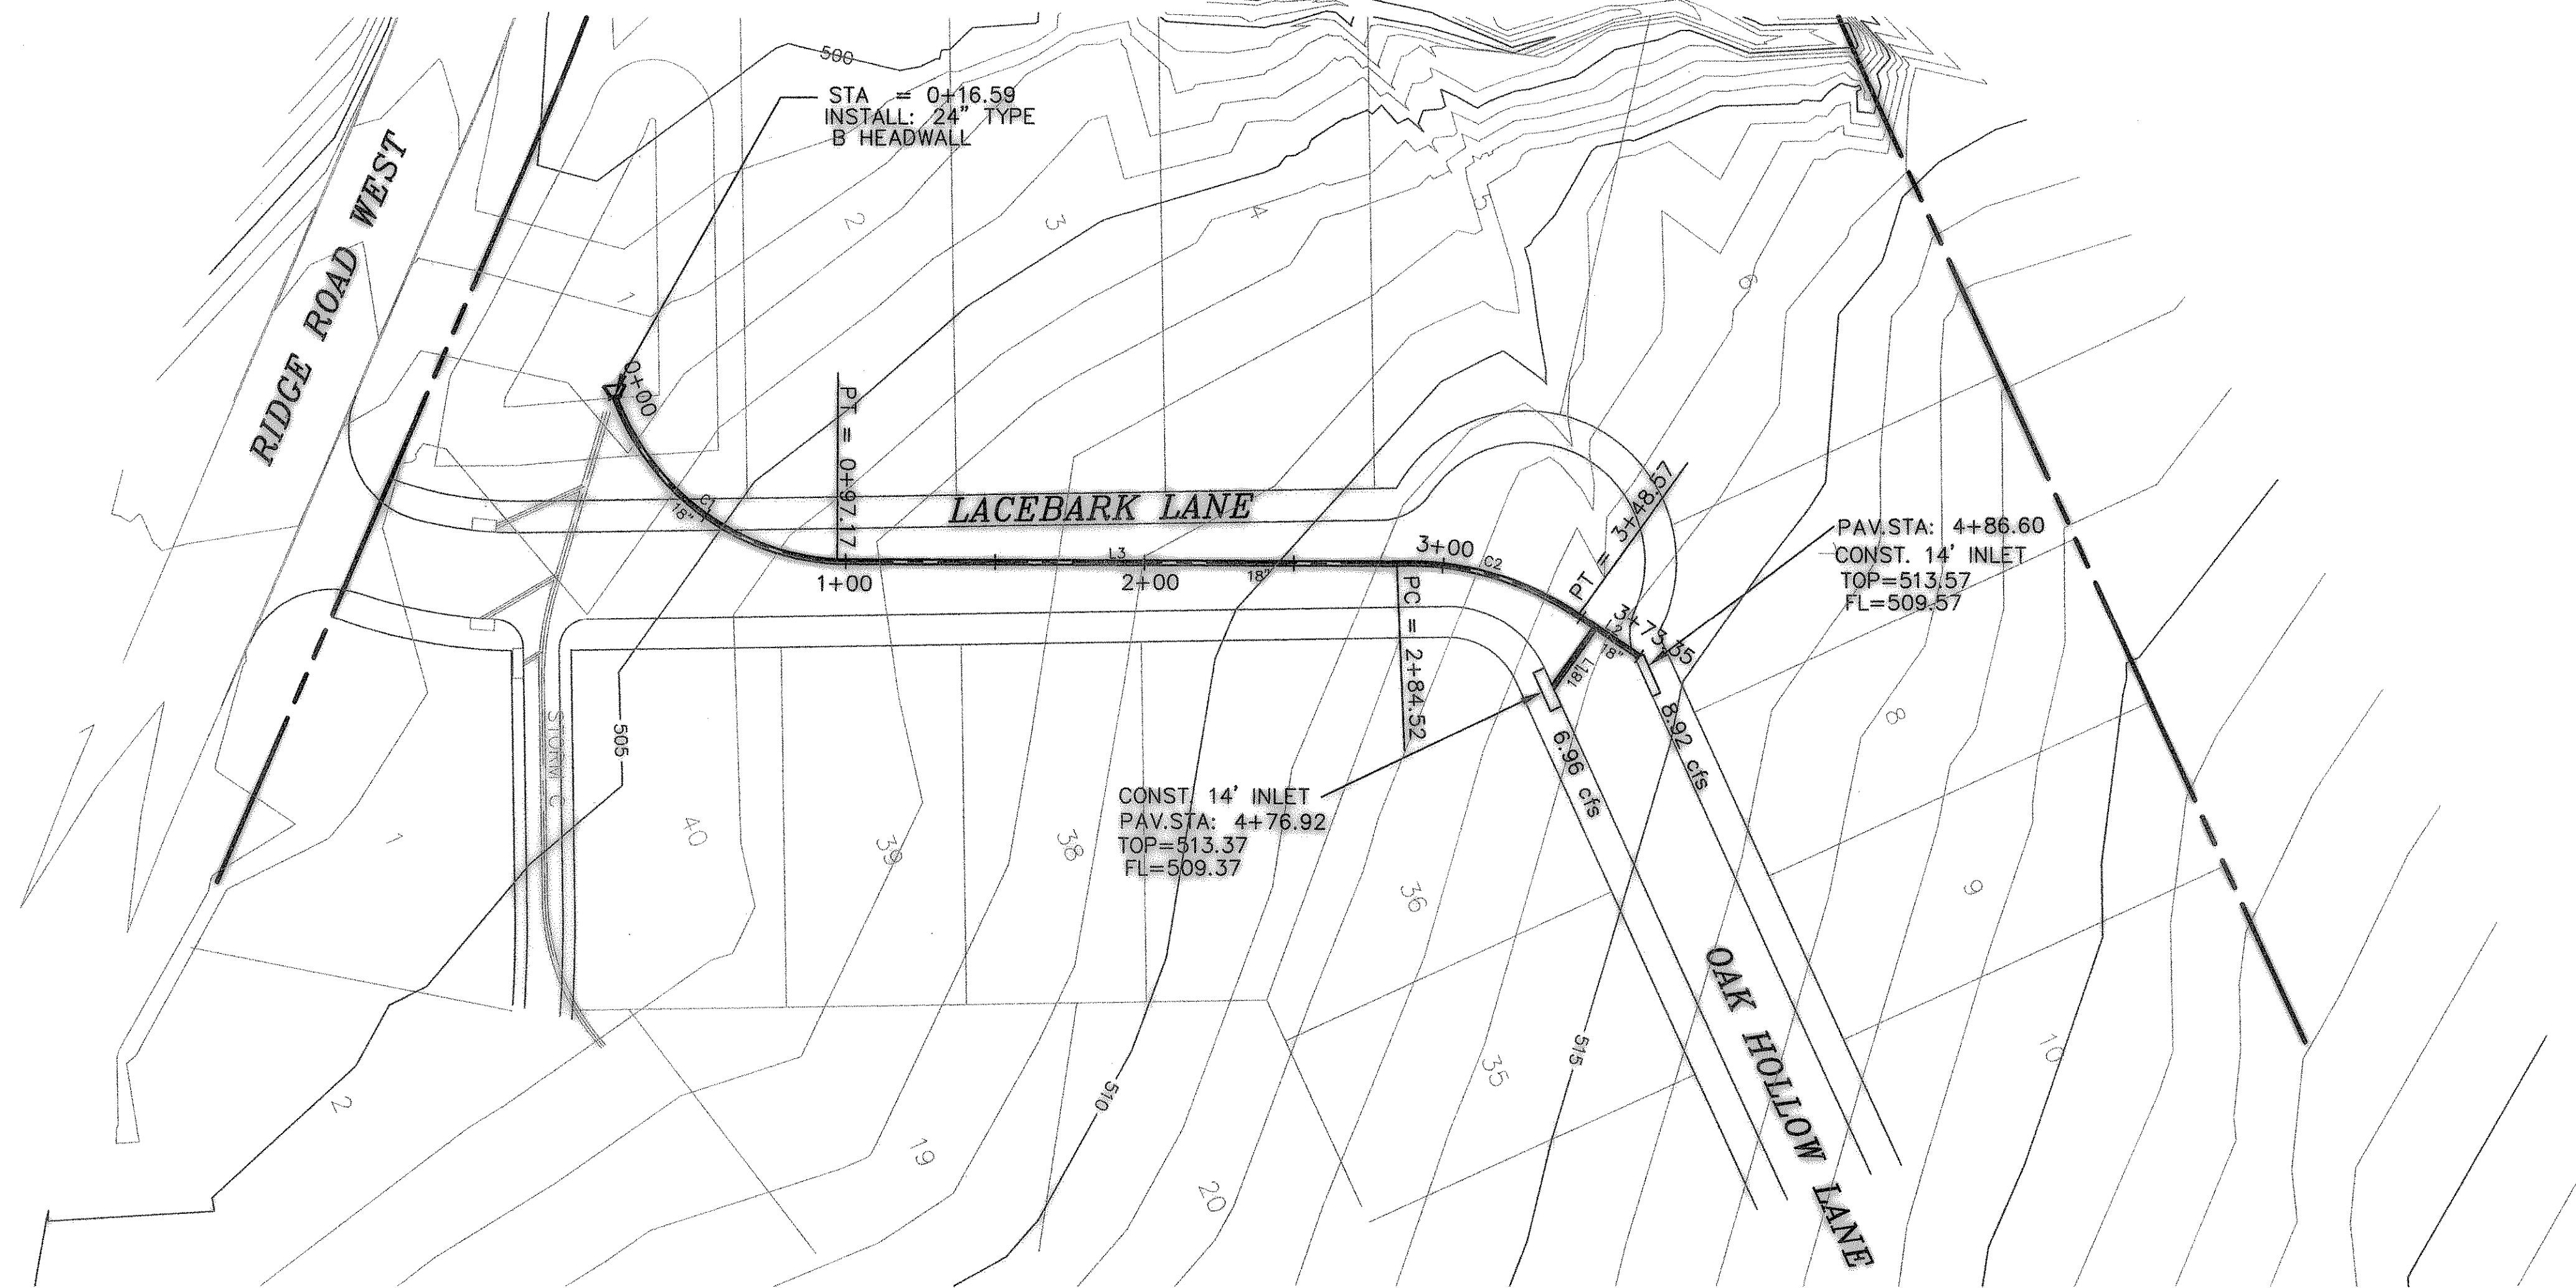


CURVE TABLE						
CURVE	LENGTH	RADIUS	TANGENT	CH BRG	CH DIST	DELTA
C1	97.17	84.36	54.78	N60°13'26"E	91.89	68°00'02"
C2	64.06	101.13	33.14	S40°02'19"W	62.99	36°17'32"

LINE TABLE		
LINE	LENGTH	BEARING
L1	24.71	N30°22'55"W
L2	24.78	S58°16'48"W
L3	187.35	N24°24'54"E

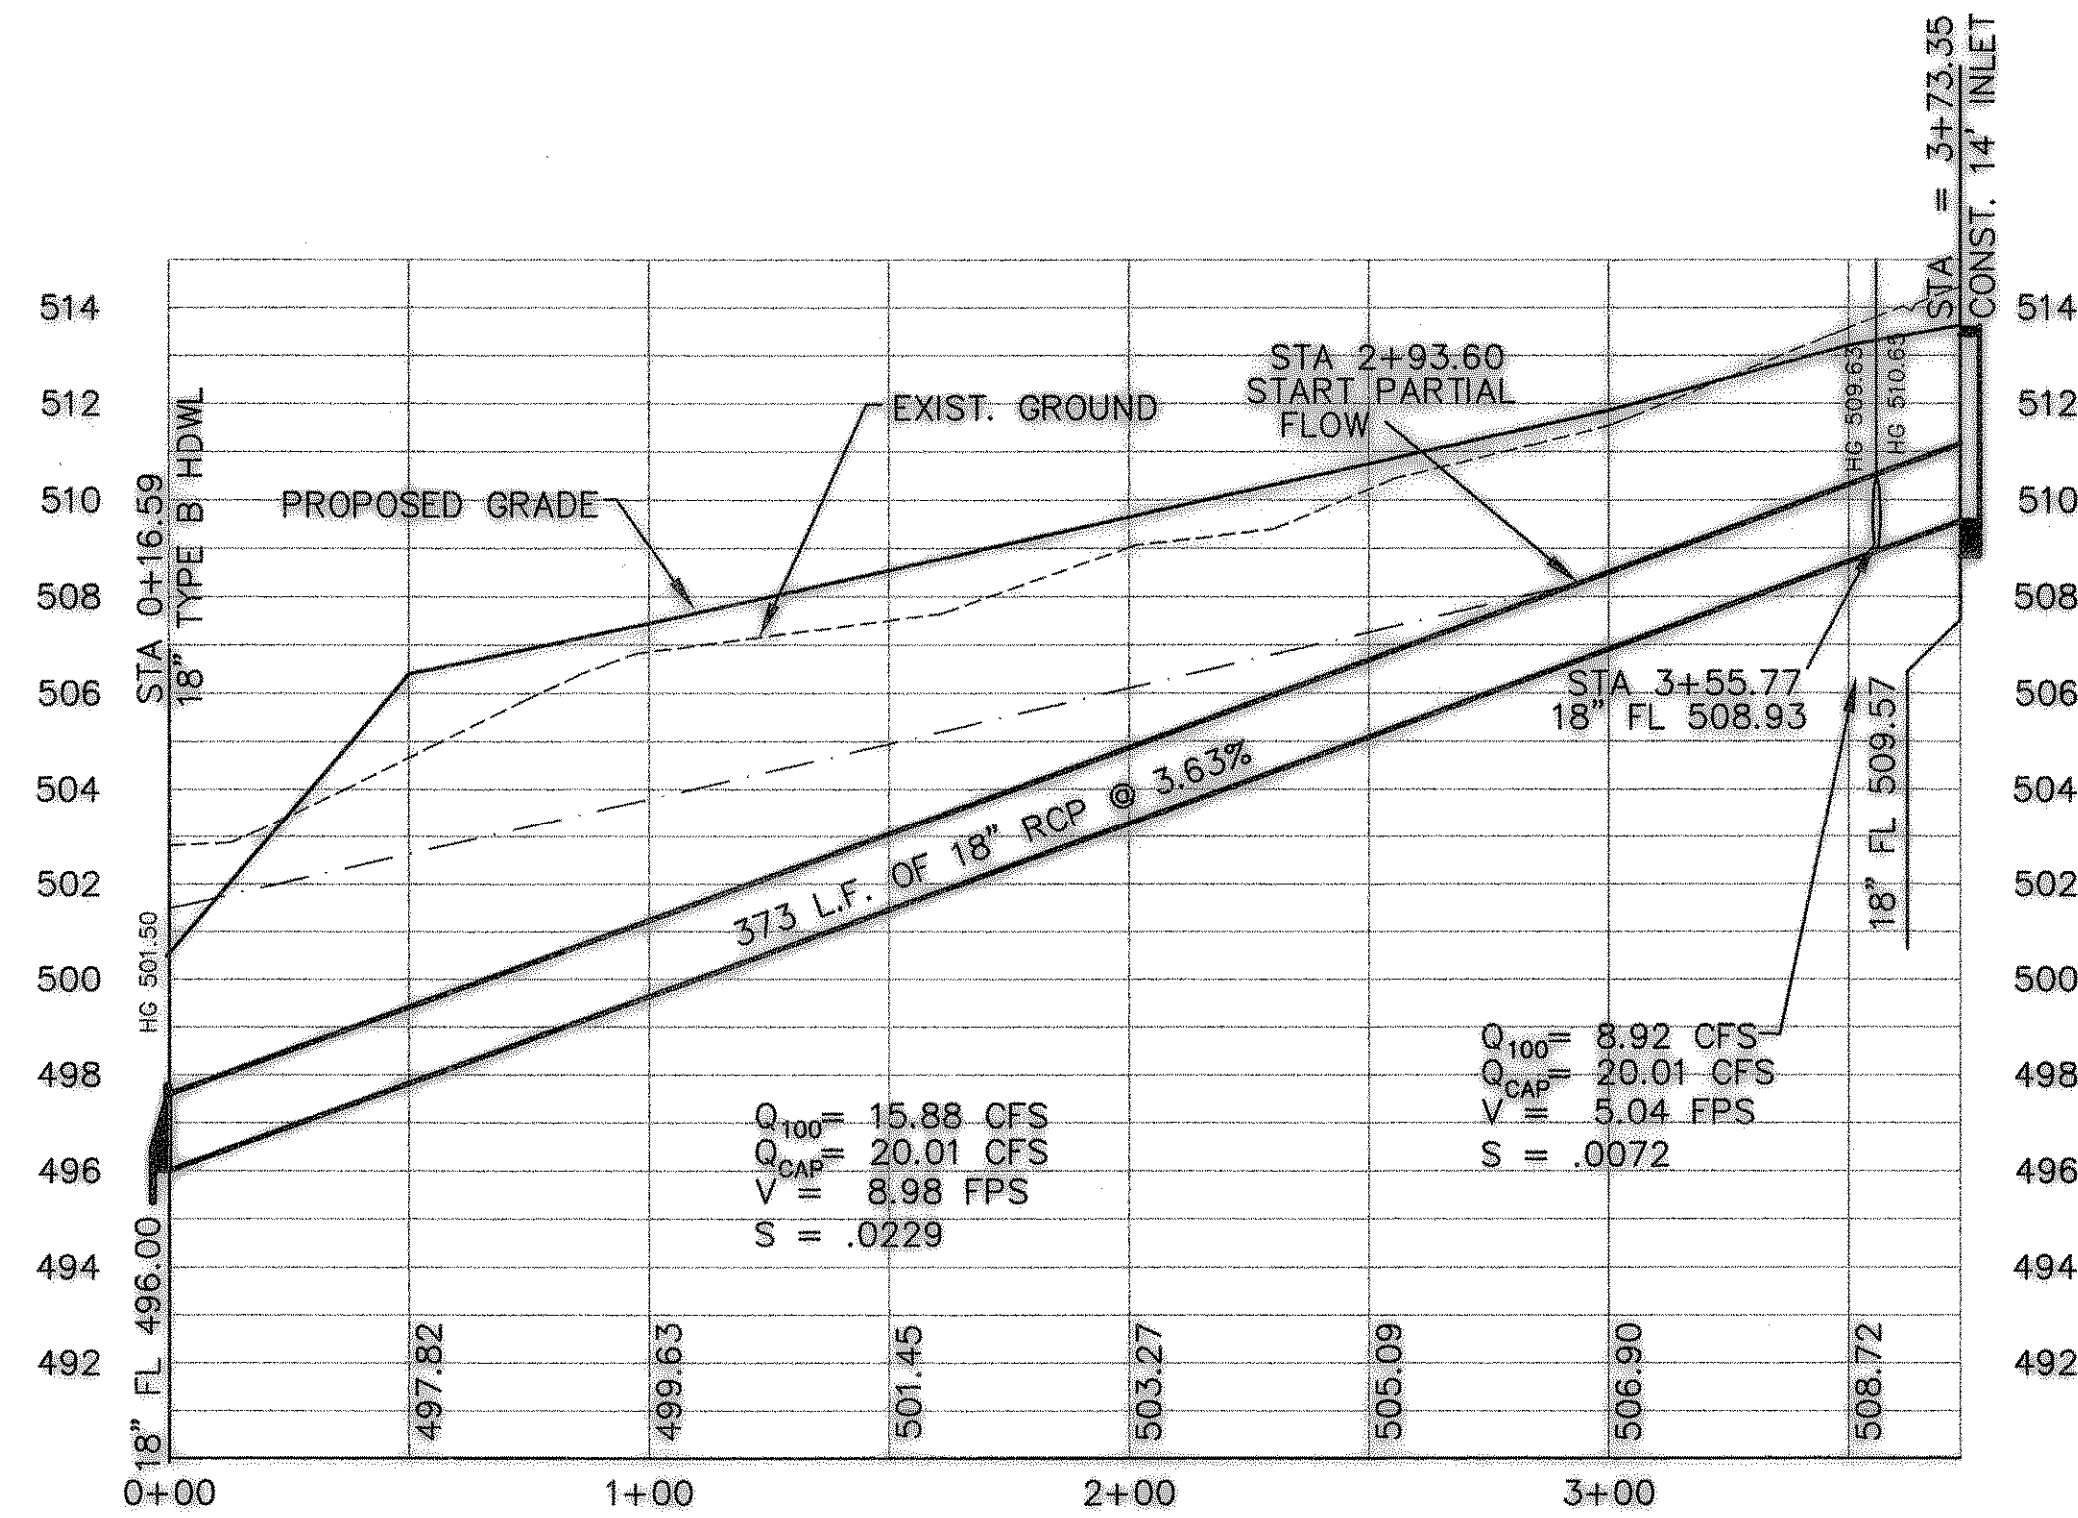

RECORD DRAWINGS:

THE INTENT OF THE OWNER AND ENGINEER WAS TO CONSTRUCT THESE FACILITIES ACCORDING TO THESE PLANS AS APPROVED BY THE CITY OF _____ . THE LINES AND GRADES WERE SET ON THE GROUND FOR CONSTRUCTION ACCORDING TO SAID PLANS. THE CITY OF _____ INSPECTED THE CONSTRUCTION. THE OWNER NOR ENGINEER DID NOT VERIFY LINES OR GRADES AFTER CONSTRUCTION. WE ARE NOT AWARE OF ANY CHANGES OR REVISIONS TO THESE PLANS DURING CONSTRUCTION EXCEPT AS NOTED

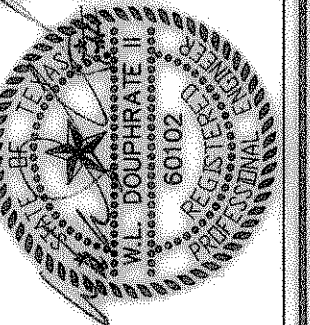

THE SEAL APPEARING ON THIS DRAWING IS THE PROPERTY OF W.L. DOUPHRATE II, TEXAS P.E. NO. 60102 ON 1/19/00

DOUPHRATE & ASSOCIATES, INC.
ENGINEERING - PROJECT MANAGEMENT - SURVEYING
2231 RIDGE RD., # 200 ROCKWALL, TEXAS 75087
PHONE: (972)771-9004 FAX: (972)771-9005

STORM SEWER PLAN & PROFILE
LINE D
CREEKSIDE VILLAGE, PHASE II
CITY OF ROCKWALL, ROCKWALL COUNTY, TEXAS

REVISION
W.L.D. CHECKED
K.E.B. DRAWN
4/7/00 DATE
9960 STMS PROJECT