


CONSTRUCTION PLANS FOR
SITE DEVELOPMENT
 FOR
CULVER'S RESTAURANT
ROCKWALL, ROCKWALL COUNTY, TEXAS

Culver's

(REVISED NOVEMBER 2002)
 (REVISED OCTOBER 2002)
 AUGUST 2002

JOHN E. HAWKINS & ASSOCIATES, INC.
 CONSULTING ENGINEERS SINCE 1957
 MCKINNEY, TEXAS


RECORD DRAWINGS
 THESE RECORD DRAWINGS HAVE BEEN PREPARED BASED ON INFORMATION PROVIDED BY OTHERS. THE ENGINEER HAS NOT VERIFIED THE ACCURACY OF THIS INFORMATION AND SHALL NOT BE RESPONSIBLE FOR ANY ERRORS OR OMISSIONS WHICH MAY BE INCORPORATED HEREIN AS A RESULT OF WHICH MAY BE ASSOCIATED WITH THE INFORMATION PROVIDED.
 JOHN E. HAWKINS & ASSOCIATES, INC.
 By:  Date: 9/19/02

INDEX

SHEET NO.	TITLE
776.2 C10	COVER SHEET & INDEX
776.2 C11	EXISTING TOPOGRAPHY SURVEY
776.2 C12	PLAT & SITE LAYOUT
776.2 C12A	PLAT (LEGAL DESCRIPTION)
776.2 C13	CIVIL SITE PLAN
776.2 C14	PAVING & UTILITY PLAN
776.2 C15	GRADING & DRAINAGE PLAN
776.2 C15A	GRADING CALCS.
776.2 C16	PAVING DETAILS
776.2 C17	UTILITY DETAILS
776.2 C18	EROSION CONTROL
776.2 C19	LANDSCAPE PLAN
776.2 C20	IRRIGATION PLAN
776.2 C21	COORDINATE CONTROL PLAN
776.2 C22	GENERAL CONSTRUCTION NOTES



PROJECT LOCATION

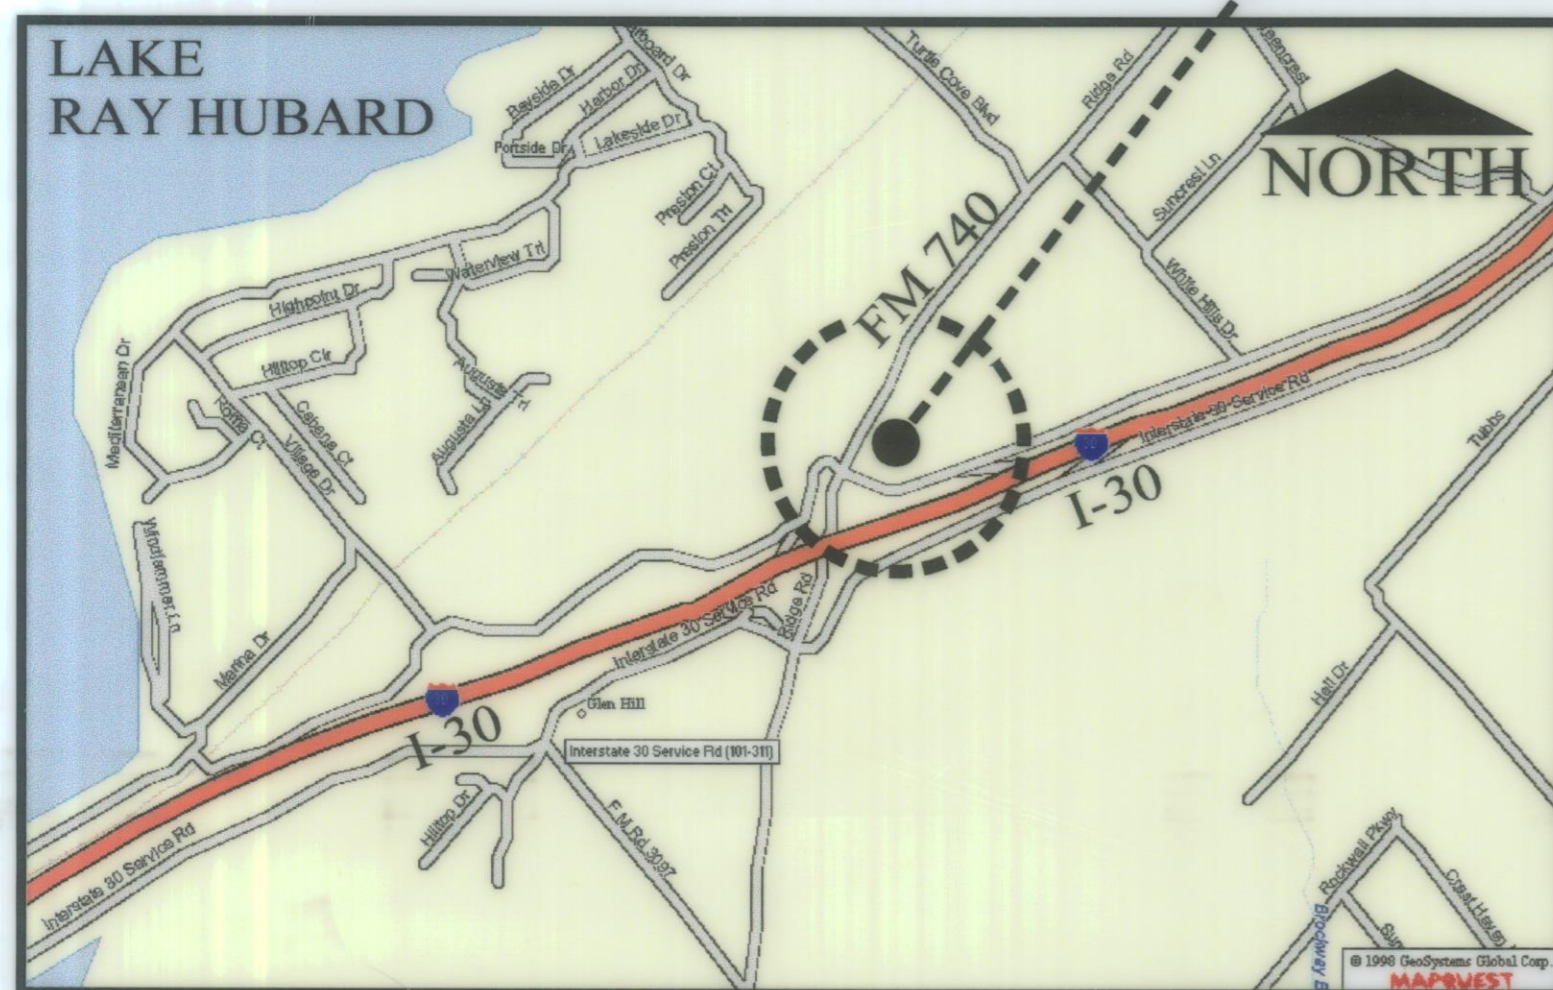

VICINITY MAP