
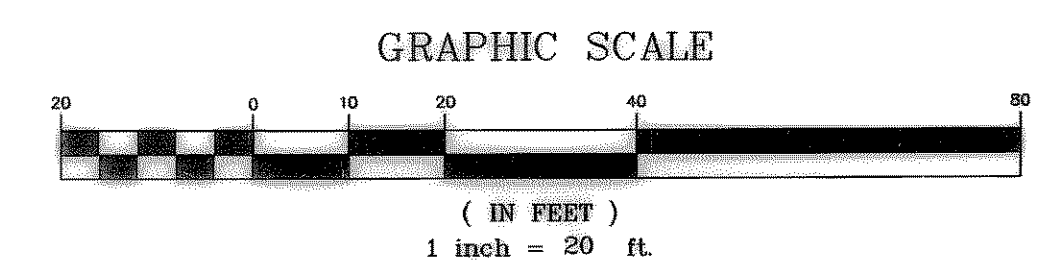


F. M. HIGHWAY 740 (RIDGE ROAD)


**LOT 1  
ROCKWALL TOWNE CENTRE PH. 4  
1.197 ACRES  
(NO TREES)**

**EXISTING TOPOGRAPHY**  
SCALE: 1" = 20'

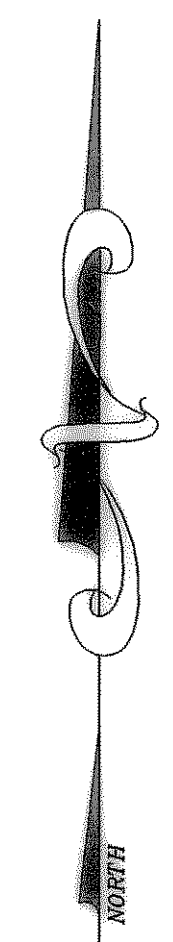

**RECORD DRAWINGS**  
THESE RECORD DRAWINGS HAVE BEEN PREPARED BASED ON INFORMATION PROVIDED BY OTHERS. THE ENGINEER HAS NOT VERIFIED THE ACCURACY OF THIS INFORMATION AND SHALL NOT BE RESPONSIBLE FOR ANY ERRORS OR OMISSIONS WHICH MAY BE INCORPORATED HEREIN AS A RESULT OF WHICH MAY BE ASSOCIATED WITH THE INFORMATION PROVIDED.  
JOHN E. HAWKINS & ASSOCIATES, INC.  
By: *[Signature]* Date: *[Date]*

**NOTE:**  
EXISTING TOPOGRAPHIC DATA PROVIDED BY ROCKWALL SURVEYING

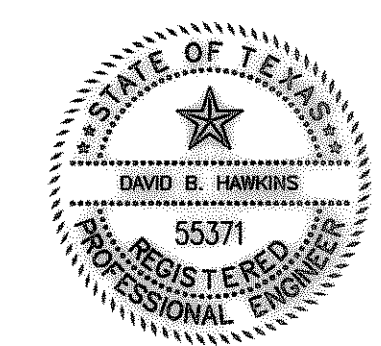

REVISION			DATE	DESCRIPTION	BY	SHEET NO.
						C11
<b>JOHN E. HAWKINS &amp; ASSOCIATES, INC.</b> CONSULTING ENGINEERS SINCE 1957 103 E. VIRGINIA ST. SUITE 206 MCKINNEY, TEXAS 75069, 972-548-2678				<b>JAMES LITTLEPAGE CULVER'S RESTAURANT EXISTING TOPOGRAPHY SURVEY</b> Scale: AS SHOWN Date: AUG '02 Job No. 776.2 Dsn. By: DBH Dwn. By: AEP Ckd. By: DBH		