
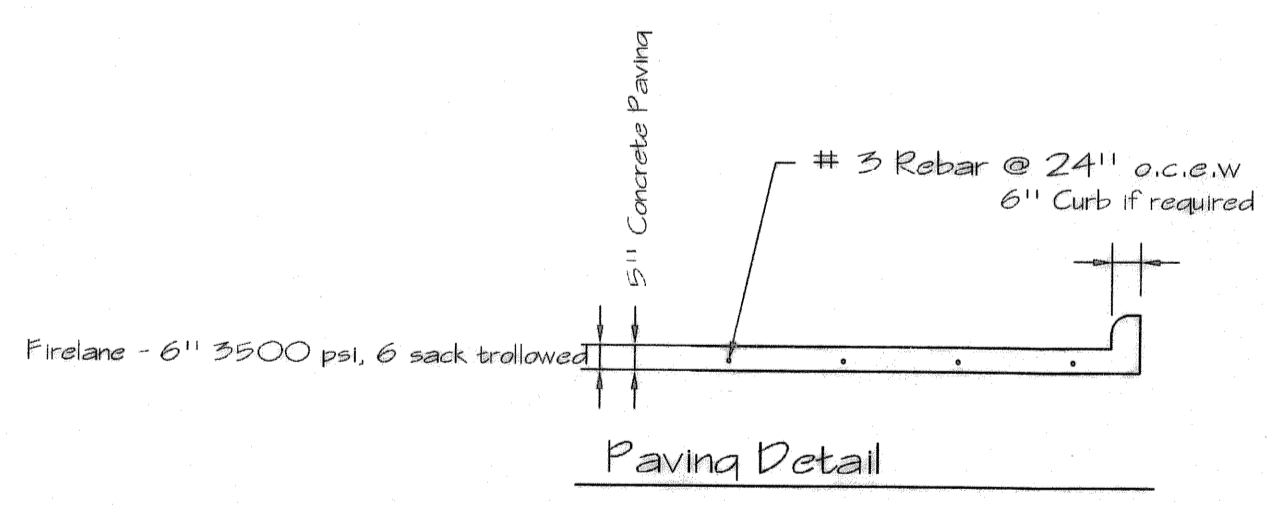
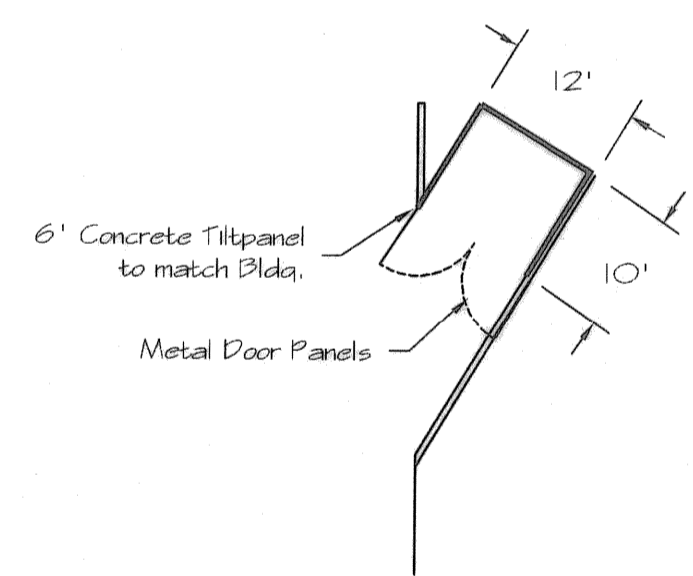


18" Cylinders with rubber stop to be approved by TSPOT

Client Calculation  
 Q=3A  
 C=3  
 W=9.5 w/ 1/2" dia  
 Q=9.5\*3\*3  
 Q=2.209

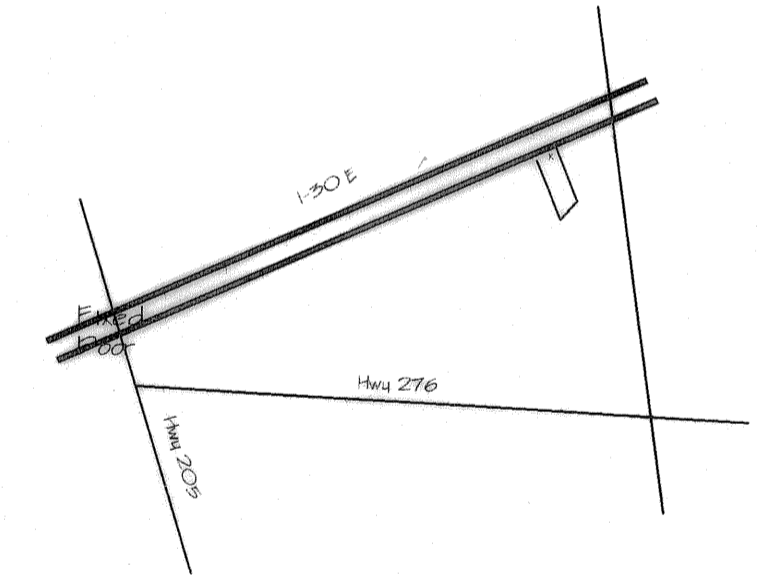

Note:  
 1. Firelane to be 3500 psi concrete, 6 sack machine trowel, with #3 rebar, 24" on center.  
 2. Subgrade compacted to 95% proctor.

Address: 1850 I-30  
 Lot 1  
 DBK Addition  
 Rockwall, Texas

Owner: DBK Technologies  
 972-771-1653

Contractor: Dallas D.B., Inc.  
 P.O. Box 1990  
 Rockwall, Texas 75087  
 972-276-9998

Area: Lot = 1.40 acres = 60,984 sq.ft  
 Building = 6,325 sq.ft.

Zoning: L1  
 Parking: Required Parking  
 Office = 4,200 sq.ft. / 300 = 14 spaces  
 W/H = 2000 sq.ft. / 1000 = 2 spaces  
 Total Required Parking = 16 spaces

Provided Parking  
 Standard Parking = 14 spaces  
 Handicap Parking = 2 spaces  
 Total Provided = 16 spaces

Title: DBK Technologies			
Description: Office / Warehouse			
1	Firelane	10/10	1"=30'
2	1st City review	11/6	
3	As Built	4/20/08	
4			9059-SP

Dallas D.B., Inc.  
 P.O. Box 1990, Rockwall, Texas 75087 972-276-9998 Fax 972-771-3872