


Connect to new 16" Water Main w/ Tap, Sleeve & Valve to City standards

Note:
Water and Sewer shall be installed per City Standards.

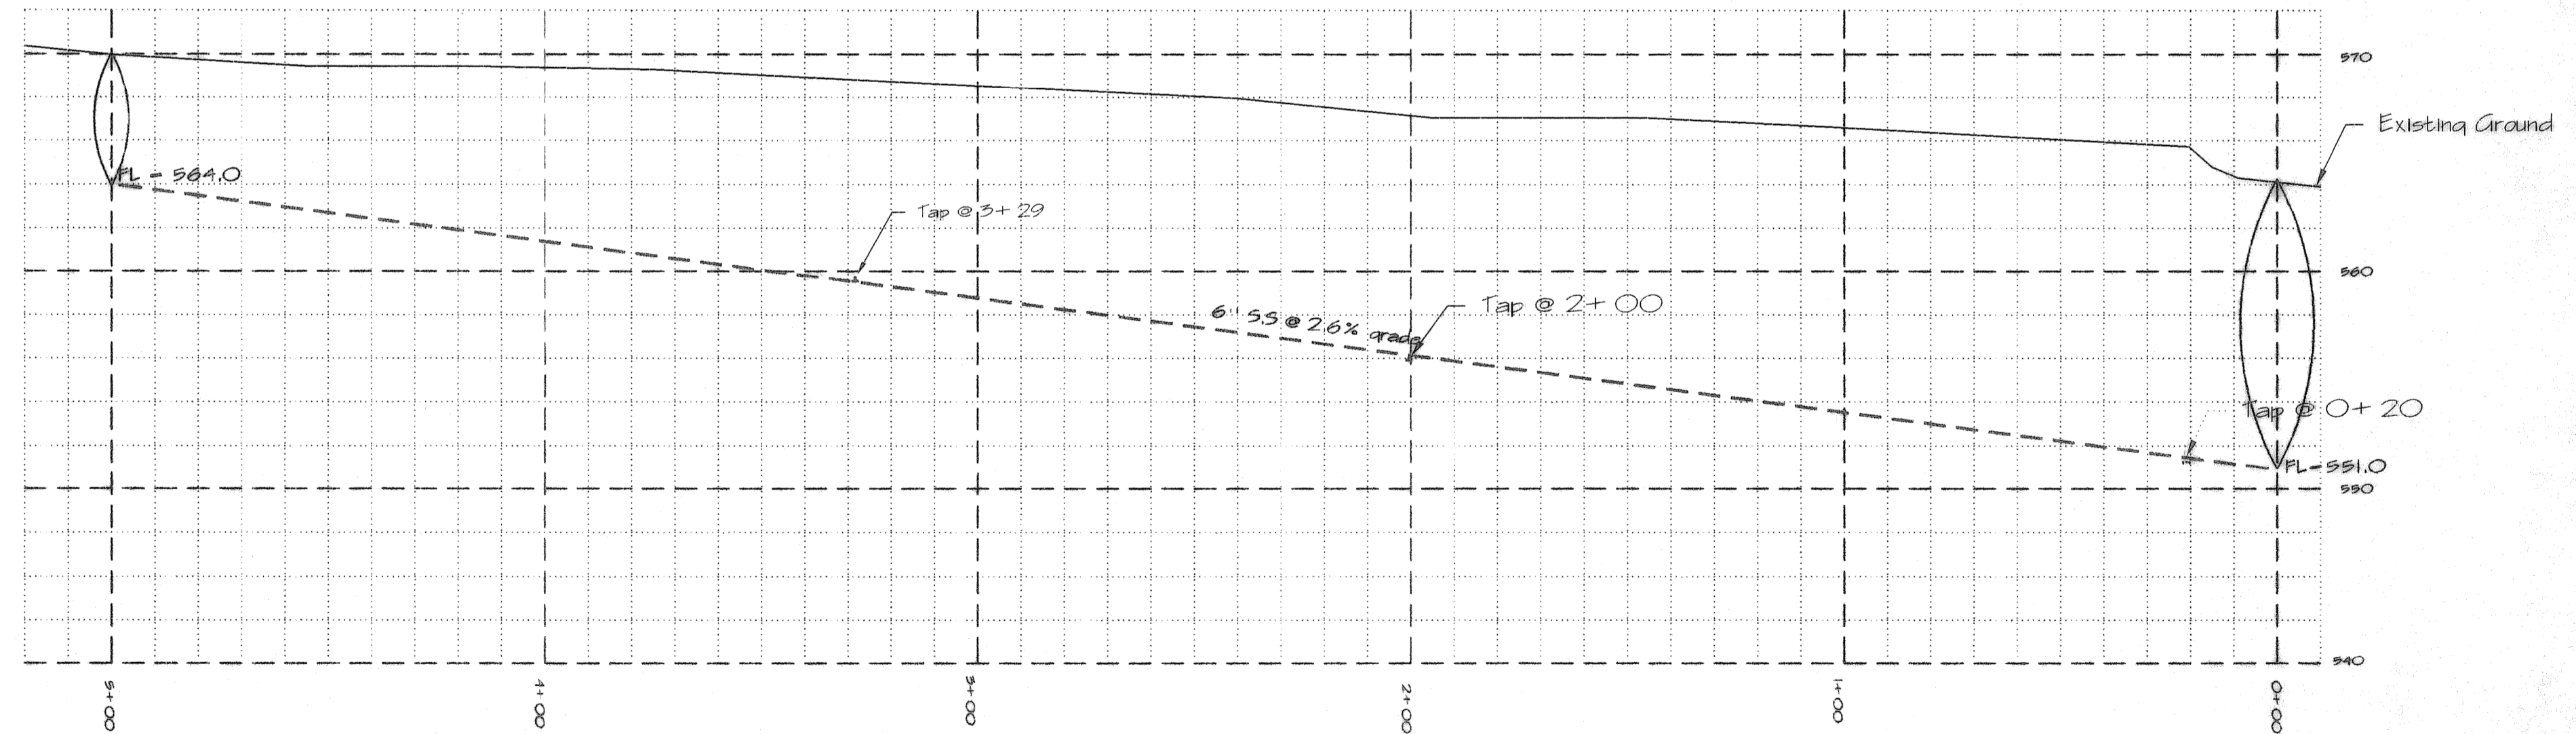

Sewer Line

Title: DBK Technologies			
Description: Office / Warehouse			
1	Firelane	10/10	11'-30"
2	1st City review	11/6	
3	As Built	7/22/99	
4			9059-U1

Dallas D.B., Inc.
P.O. Box 1990, Rockwall, Texas 75087 972-216-9998 Fax 972-711-5872