

SEE SHEET C5.0


P. O. Box 5300  
 TYLER TX 75712  
 T 903.877.4128  
 F 903.877.4449  
 www.layconstruct.com



ALL DRAWINGS AND WRITTEN MATERIAL APPEARING HEREIN CONSTITUTE ORIGINAL AND UNPUBLISHED WORK OF THE ENGINEER. NO PART OF THIS DRAWING OR SPECIFICATIONS SHALL BE REPRODUCED OR TRANSMITTED IN ANY FORM OR BY ANY MEANS, ELECTRONIC OR MECHANICAL, WITHOUT THE WRITTEN CONSENT OF THE ENGINEER.

© 2014 LAY CONSTRUCTION, LLC. ALL RIGHTS RESERVED.

**TE**  
**TOTAL ENGINEERING SERVICES, LLC**  
 103 COMMUNITY BLVD.  
 LONGVIEW, TX 75605  
 903.212.2856  
 te-services.com  
 TPE FIRM 13038

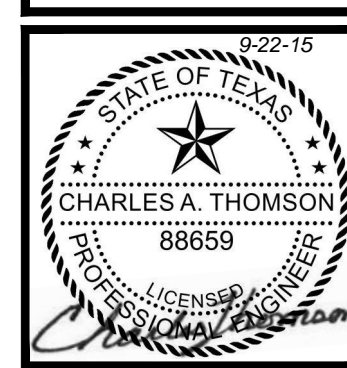

**DQ**  
**Restaurant**  
 AMERICAN DAIRY QUEEN  
 MINNEAPOLIS, MN U.S.A.  
 \*REGISTERED U.S. PATENT OFFICE.  
 AMERICAN DAIRY QUEEN CORPORATION. THIS DRAWING, ITS DESIGN DETAIL AND INVENTION ARE THE PROPERTY OF AMERICAN DAIRY QUEEN INC. (ADQ) AND SHALL NOT BE COPIED IN ANY MANNER NOR DISCLOSED TO ANY OUTSIDE PARTY WITHOUT ADQ CONSENT.  
 BUILDING TYPE:  
 DAIRY QUEEN  
 TEXAS

**NEW BUILDING DAIRY QUEEN**  
 1801 SOUTH GOLIAD STREET  
 ROCKWALL, TEXAS 75087

REVISIONS	
NO.	DATE
1	10-15-2014
2	01-07-2015
3	01-23-2015
4	02-10-2015
5	09-22-2015

DATE:  
 08/27/2014

PROJECT NO.  
 LAY 14 002

SHEET NO.  
**C4.0**

ISSUED FOR CITY REVIEW  
 GRADING PLAN

**1 GRADING PLAN**  
 SCALE: 1"=20'

**RECORD DRAWING** SP 2014-018

Filename: P:\LAY 14 002 - LAY Construction - DD Rockwall\TCD\LAY 14 002 - GRADING PLAN.dwg    Printed: 10/22/2015 11:46:33 AM  
 Copyright © 2011, TOTAL ENGINEERING SERVICES, LLC