



CURVE	LENGTH	RADIUS	DELTA	TANGENT	CHORD	BEARING
SSC23	203.24'	798.00'	14°35'33"	102.17'	202.69'	N84°20'48"W
SSC24	121.97'	519.50'	13°27'08"	61.27'	121.69'	S83°46'35"E
SSC34	64.81'	580.50'	6°23'48"	32.44'	64.77'	S71°35'33"W
SSC35	112.88'	480.50'	13°27'37"	56.70'	112.62'	N06°33'14"W

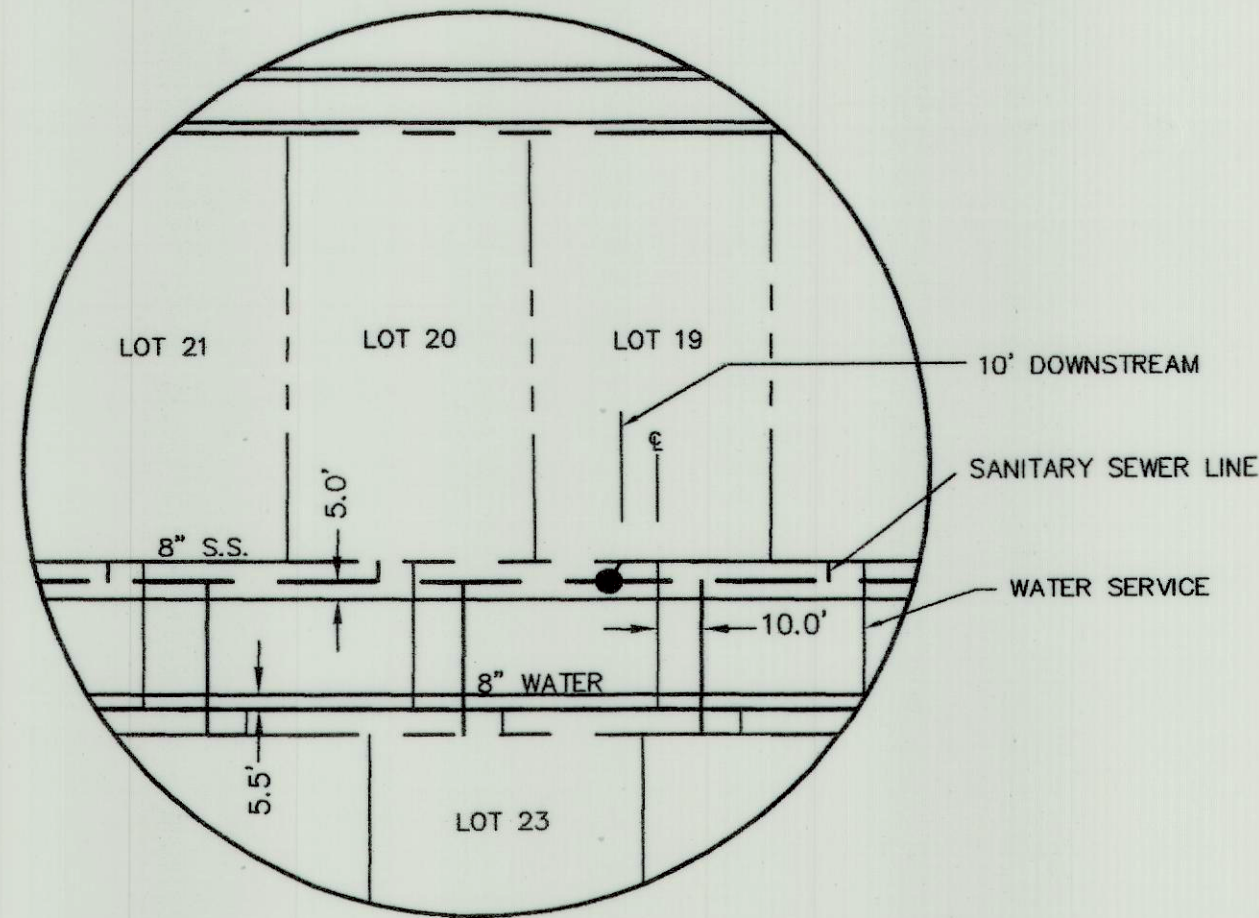


LOT SERVICES DETAIL
N.T.S.

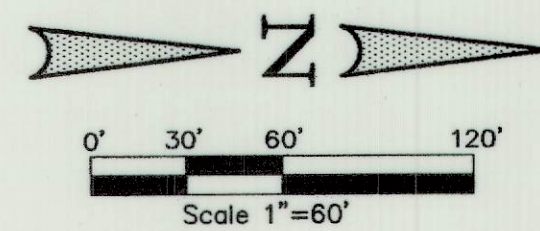


AS BUILT
To the best of our knowledge "Winkelman and Associates, Inc." hereby states that this plan is "As-Built". The information is based on surveying conducted at the site and modification information provided by "the Contractor".

M. Naeemuddin Khan 9/25/07
WINKELMANN & ASSOCIATES, INC. DATE

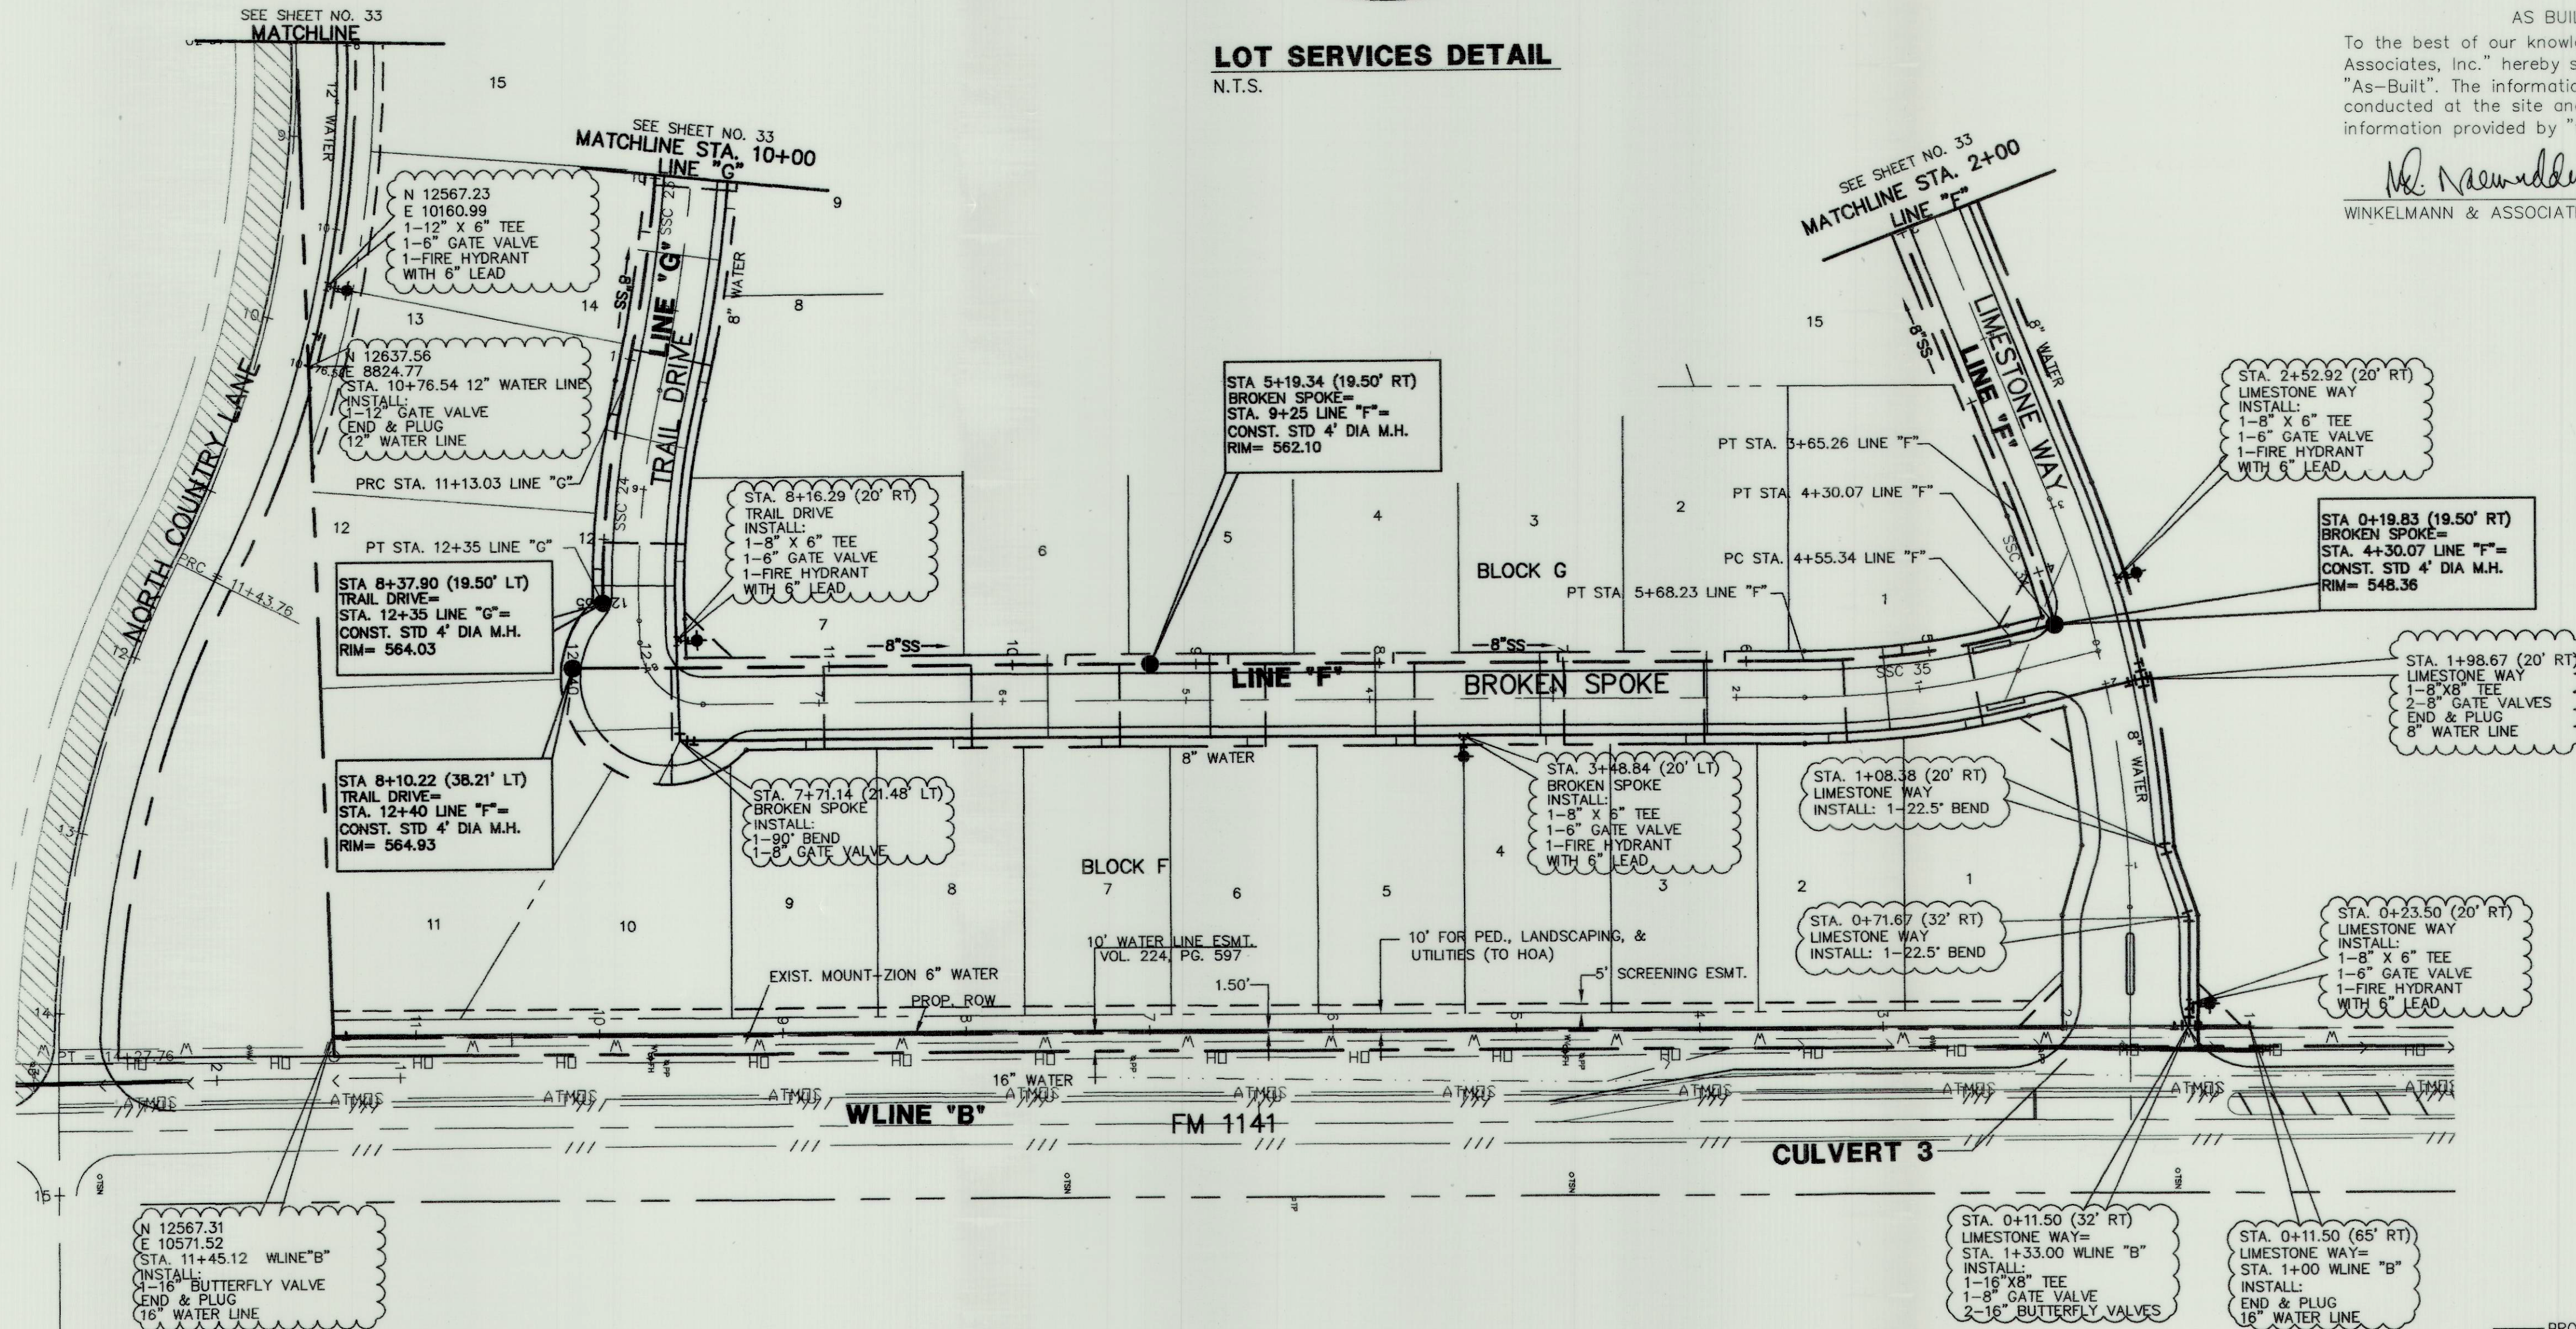

CAUTION !!!
UNDERGROUND UTILITIES

EXISTING UTILITIES AND UNDERGROUND FACILITIES INDICATED ON THESE PLANS HAVE BEEN LOCATED FROM REFERENCE INFORMATION SUPPLIED BY VARIOUS OWNERS OF THE FACILITIES. THE ENGINEER DOES NOT ACCEPT THE RESPONSIBILITY FOR THE UTILITY LOCATIONS SHOWN. IT SHALL BE THE RESPONSIBILITY OF THE CONTRACTOR TO VERIFY BOTH HORIZONTALLY AND VERTICALLY THE LOCATION OF ALL EXISTING UTILITIES AND UNDERGROUND FACILITIES PRIOR TO CONSTRUCTION, TO TAKE NECESSARY PRECAUTIONS IN ORDER TO PROTECT ALL FACILITIES ENCOUNTERED, AND TO NOTIFY THE ENGINEER PROMPTLY OF ALL CONFLICTS OF THE WORK WITH EXISTING FACILITIES. THE CONTRACTOR SHALL PRESERVE AND PROTECT ALL EXISTING UTILITIES FROM DAMAGE DURING CONSTRUCTION. ANY DAMAGE BY THE CONTRACTOR TO EXISTING UTILITIES SHALL BE REPAIRED BY THE CONTRACTOR AT HIS EXPENSE. CONTACT ALL POSSIBLE UTILITY AND

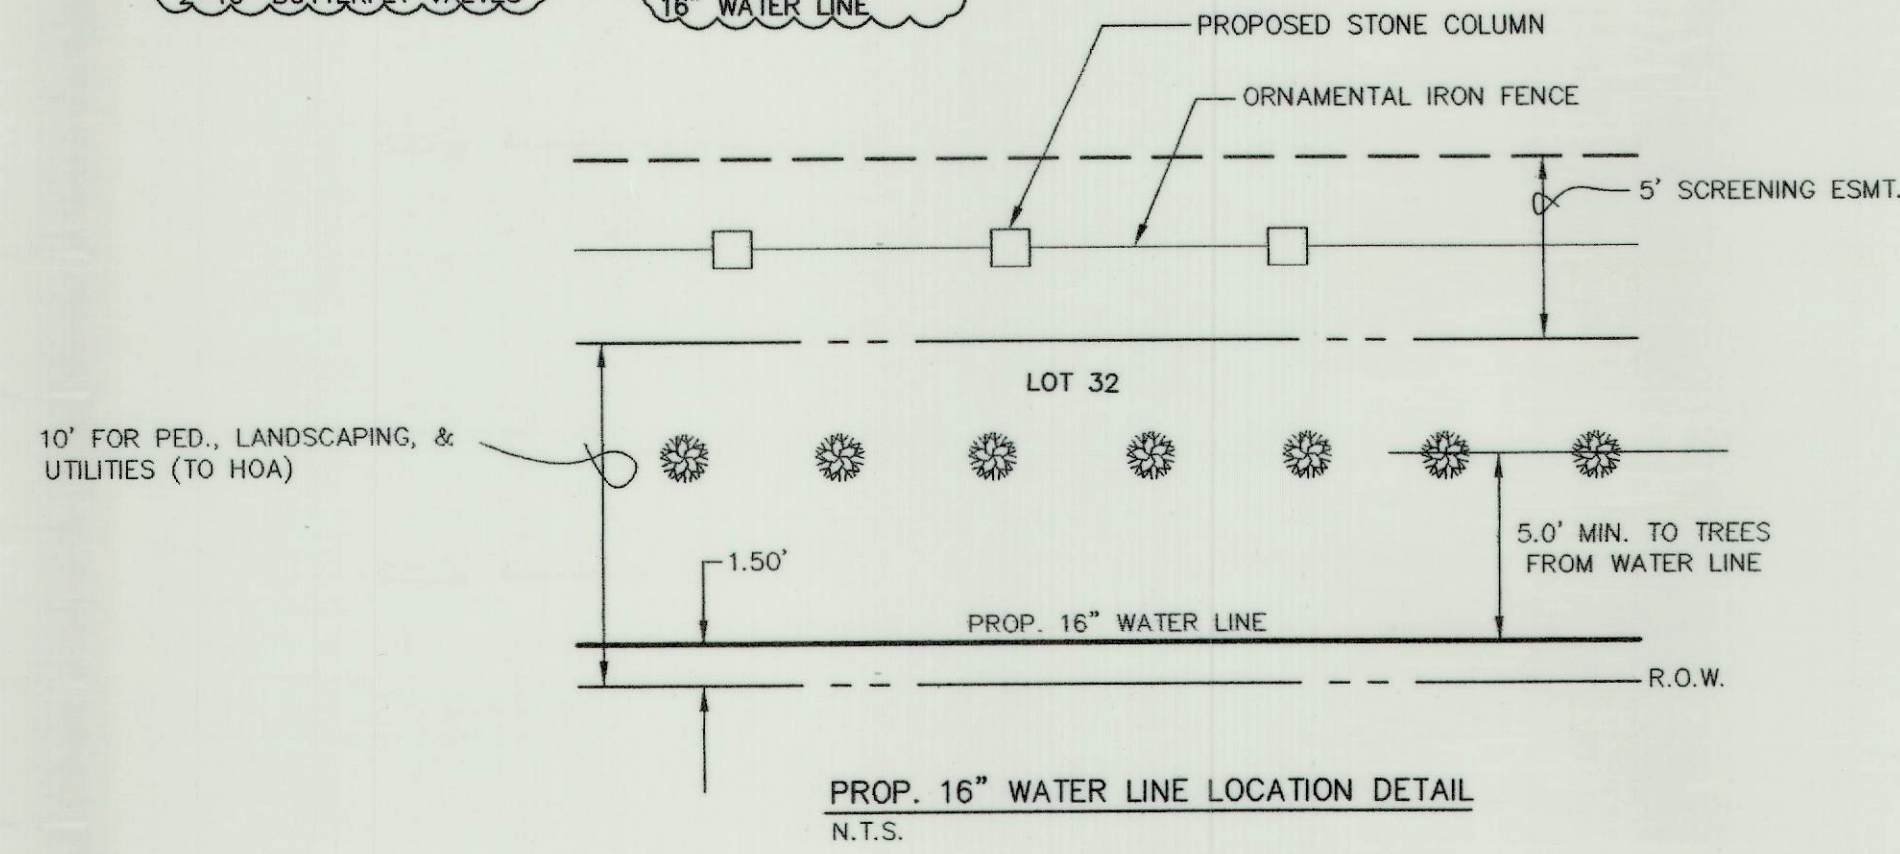

BENCHMARK 1 USGS Monument-stamped Boreen 1986
Located approximately 1.25 miles east of Rockwall at the Rockwall Municipal Airport, in the north end of a circular grass area at the end of a taxiway.
ELEVATION = 574.17

BENCHMARK 2 USGS Monument-5" cap stamped N 1495/1986
Located 24.6 feet west of the center of a paved road leading to the Rockwall Municipal Airport, 16.4 feet south of a utility pole with a transformer and light, 2 feet west of the north leg of a sign. Access to datum point is through a 5 inch logo cap.
ELEVATION = 574.44

APPROV.		Winkelman & Associates, Inc.	
REVISION		CONSULTING CIVIL ENGINEERS & SURVEYORS 8750 HILGERT PLAZA DRIVE, SUITE 100 DALLAS, TEXAS 75230 (972) 480-7998 FAX (972) 480-7998	
DATE		9/25/07	
NO.		918106	
THESE CONSTRUCTION PLANS WERE PREPARED UNDER THE RESPONSIBLE SUPERVISION OF MD. NAIM UDDIN KHAN, REGISTERED PROFESSIONAL ENGINEER NO. 87776.			
THE SEAL APPEARING ON THIS DOCUMENT WAS AUTHORIZED BY MD. NAIM UDDIN KHAN, P.E. #87776			
JOHN M. GLASS SURVEY ABSTRACT No. 88		ROCKWALL COUNTY, TEXAS	
D R HORTON		4306 MILLER ROAD, SUITE A ROWLETT, TEXAS 75088 214-607-4244	
WATER & SANITARY SEWER PLAN			
Scale: 1"=60'	Date: 09/08/06	Designed By: IT	SHEET 34 OF 45
Drawn By: IT	Checked By: NK	File: 40709WS.DWG	
View: WS3	Project No.: 40709.00		