
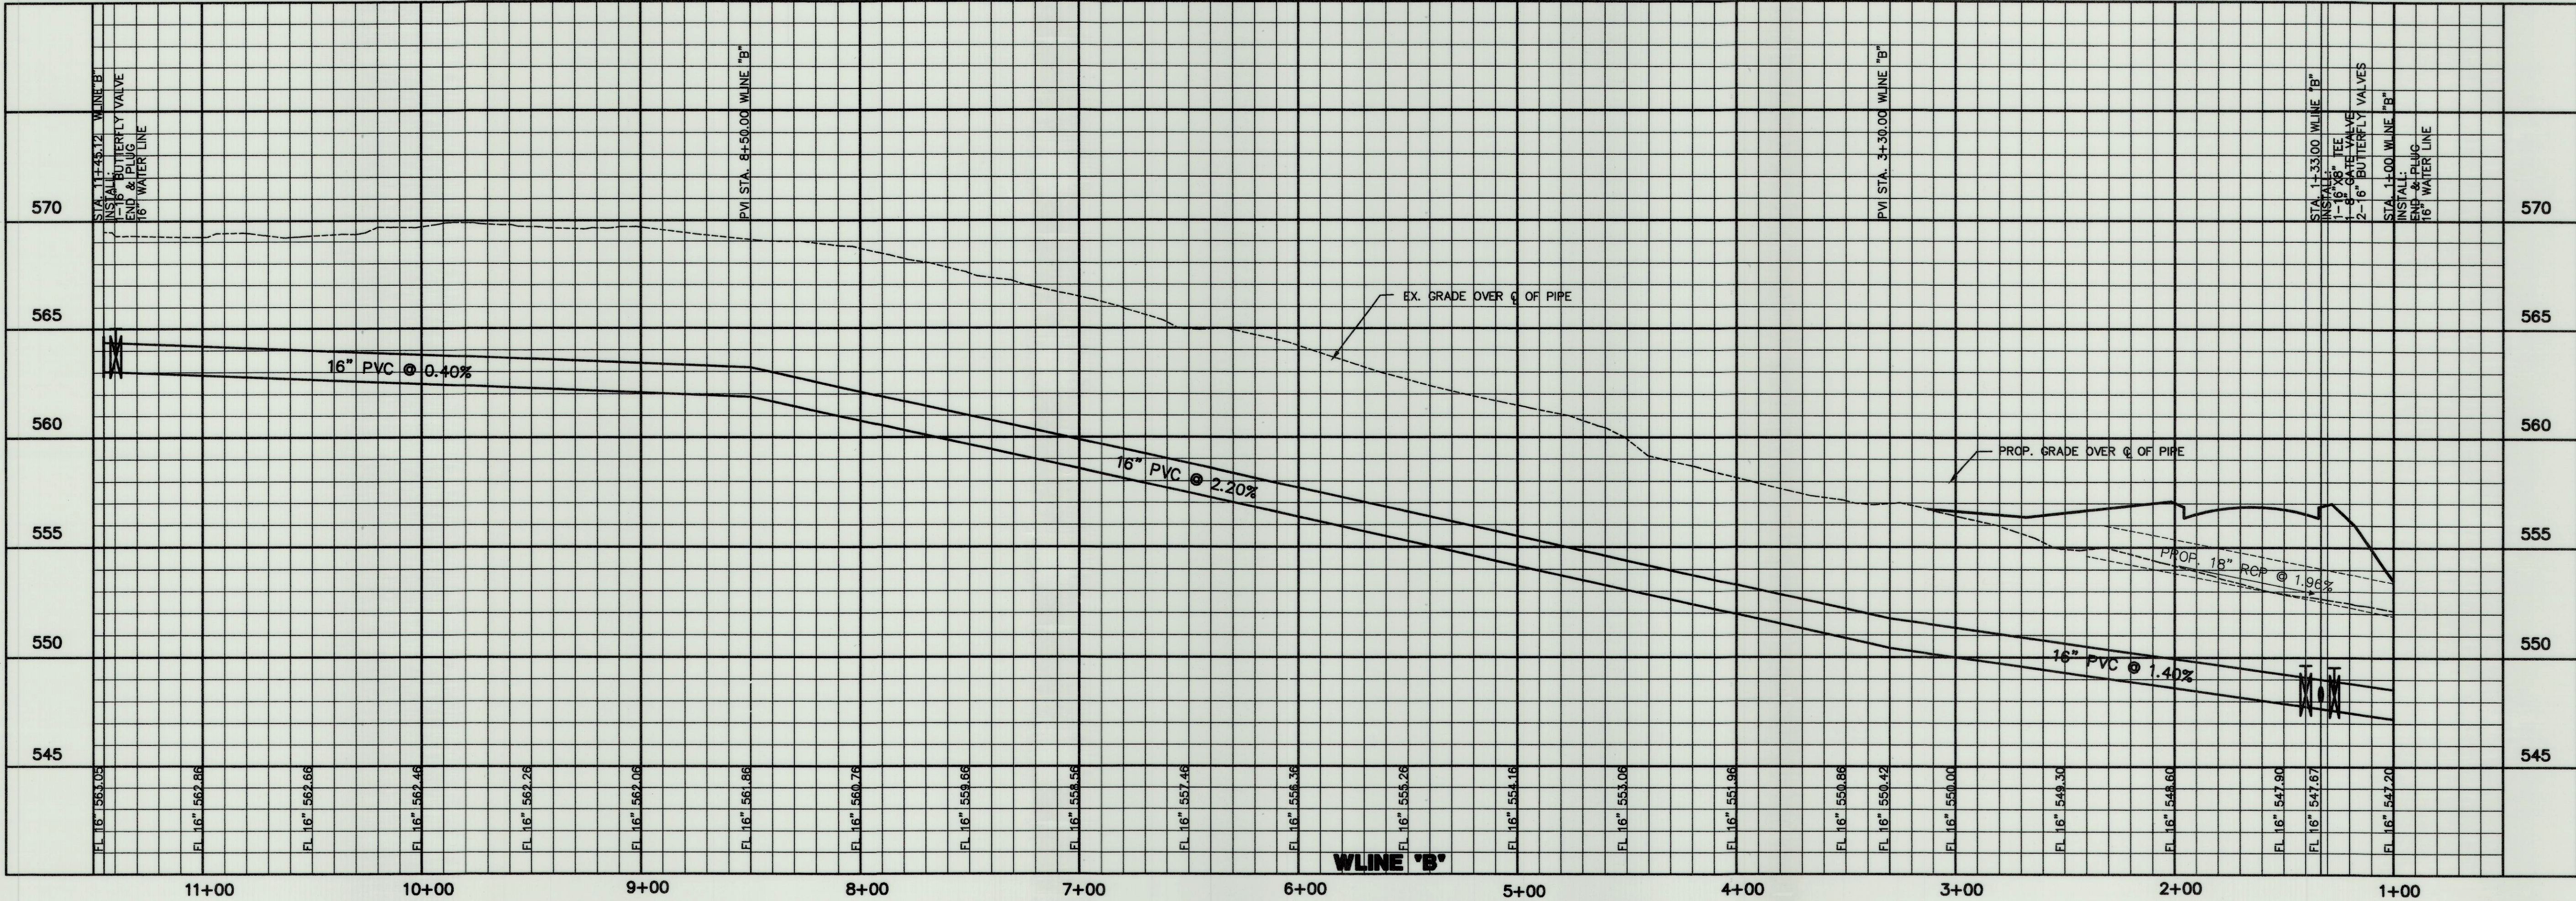


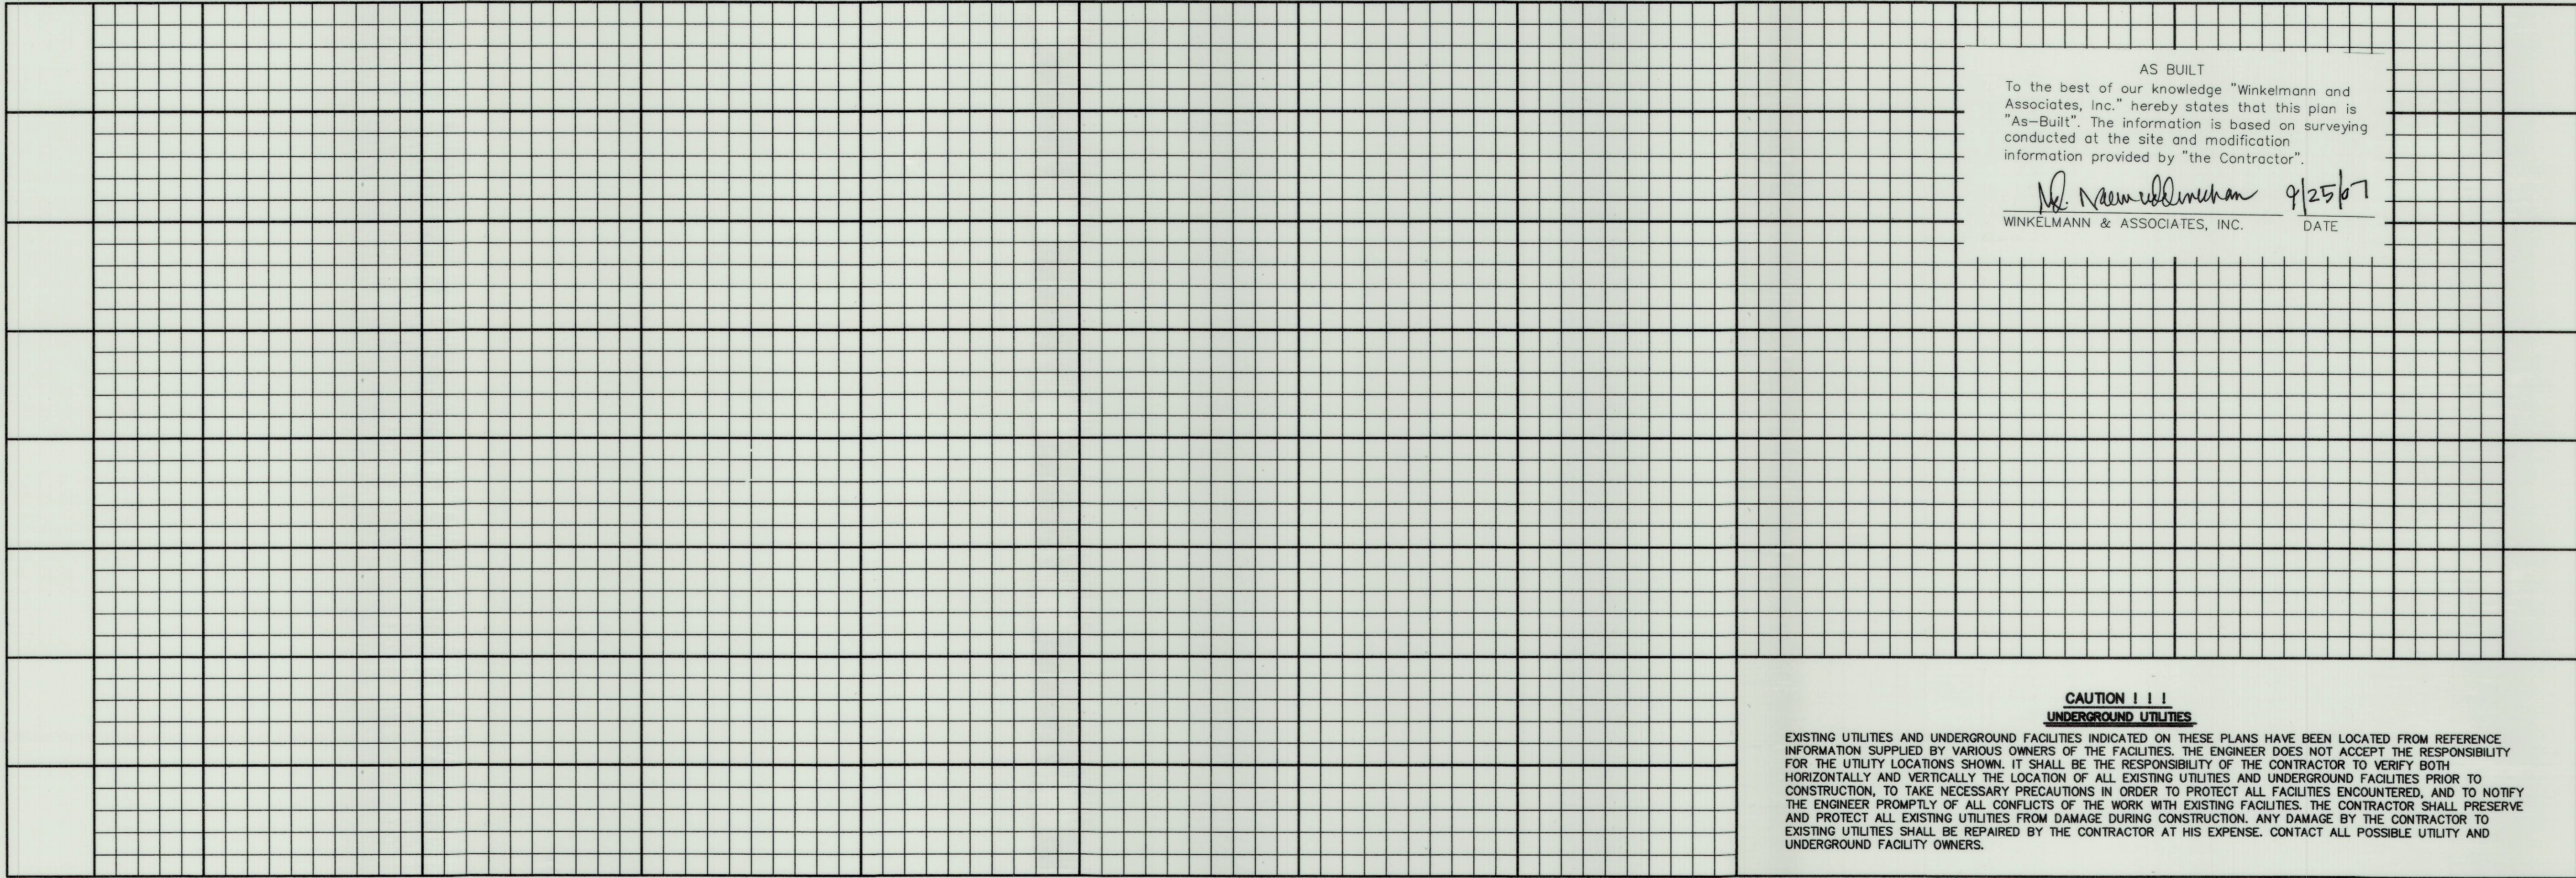

BENCHMARK 1 USGS Monument-stamped Boren 1986
Located approximately 1.25 miles east of Rockwall at the Rockwall Municipal Airport, in the north end of a circular grass area at the intersection of the north and south legs of a 1/4 section.
ELEVATION = 571.11

BENCHMARK 2 USGS Monument-5" cap stamped N 1495/1986
Located 24.8 feet west of the center of a paved road leading to the Rockwall Municipal Airport, 16.4 feet south of a utility pole with a transformer and north of the north leg of a sign.
ELEVATION = 567.44

THESE CONSTRUCTION PLANS WERE PREPARED UNDER THE RESPONSIBLE SUPERVISION OF MD. NAIM UDDIN KHAN, REGISTERED PROFESSIONAL ENGINEER NO. 87776.

THE SEAL APPEARING ON THIS DOCUMENT WAS AUTHORIZED BY MD. NAIM UDDIN KHAN, P.E. #87776

JOHN M. GLASS SURVEY ABSTRACT No. 88
CITY OF ROCKWALL, TEXAS

D. R. HORTON
4306 MILLER ROAD, SUITE A
ROWLETT, TEXAS 75088
214-607-4244


SHEET
34C
OF
45

Scale: 1" = 40'
Designed By: MS
Drawn By: MS
Checked By: NK
File: 40709WT.dwg
Project No.: 40709.00

16" WATER PROFILE
WLIN 'B' STA 1+00 TO STA 11+44.75

JOHN M. GLASS SURVEY ABSTRACT No. 88
CITY OF ROCKWALL, TEXAS

D. R. HORTON
4306 MILLER ROAD, SUITE A
ROWLETT, TEXAS 75088
214-607-4244

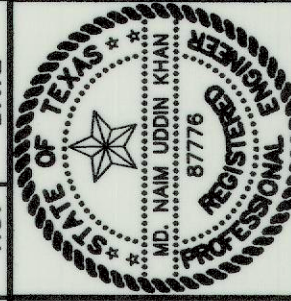

Winkelmann & Associates, Inc.
CONSULTING CIVIL ENGINEERS ■ SURVEYORS
6750 HILLCREST PLAZA DRIVE, SUITE 100
DALLAS, TEXAS 75230
(972) 480-7988
(972) 480-7989 FAX