
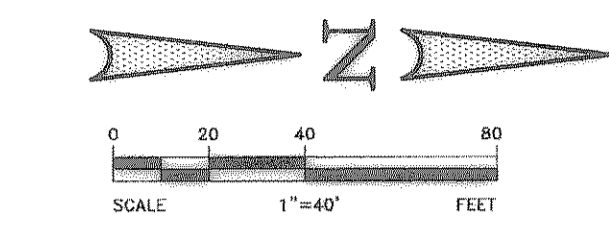


NOTE:
ELEVATIONS ARE TO THE NEAREST TENTH. REFER TO PAVING PLANS FOR EXACT PAVING ELEVATIONS.

NOTE:
ALL FILL SHALL BE COMPACTED BY SHEEP'S FOOT ROLLER

FIELD CHANGES AS MADE BY D. R. HORTON. WAI NOT RESPONSIBLE FOR THESE GRADING CHANGES/MODIFICATIONS




NOTE:
NO WALL / FOOTING SHALL BE CONSTRUCTED IN EASEMENT AND/OR RIGHT OF WAY

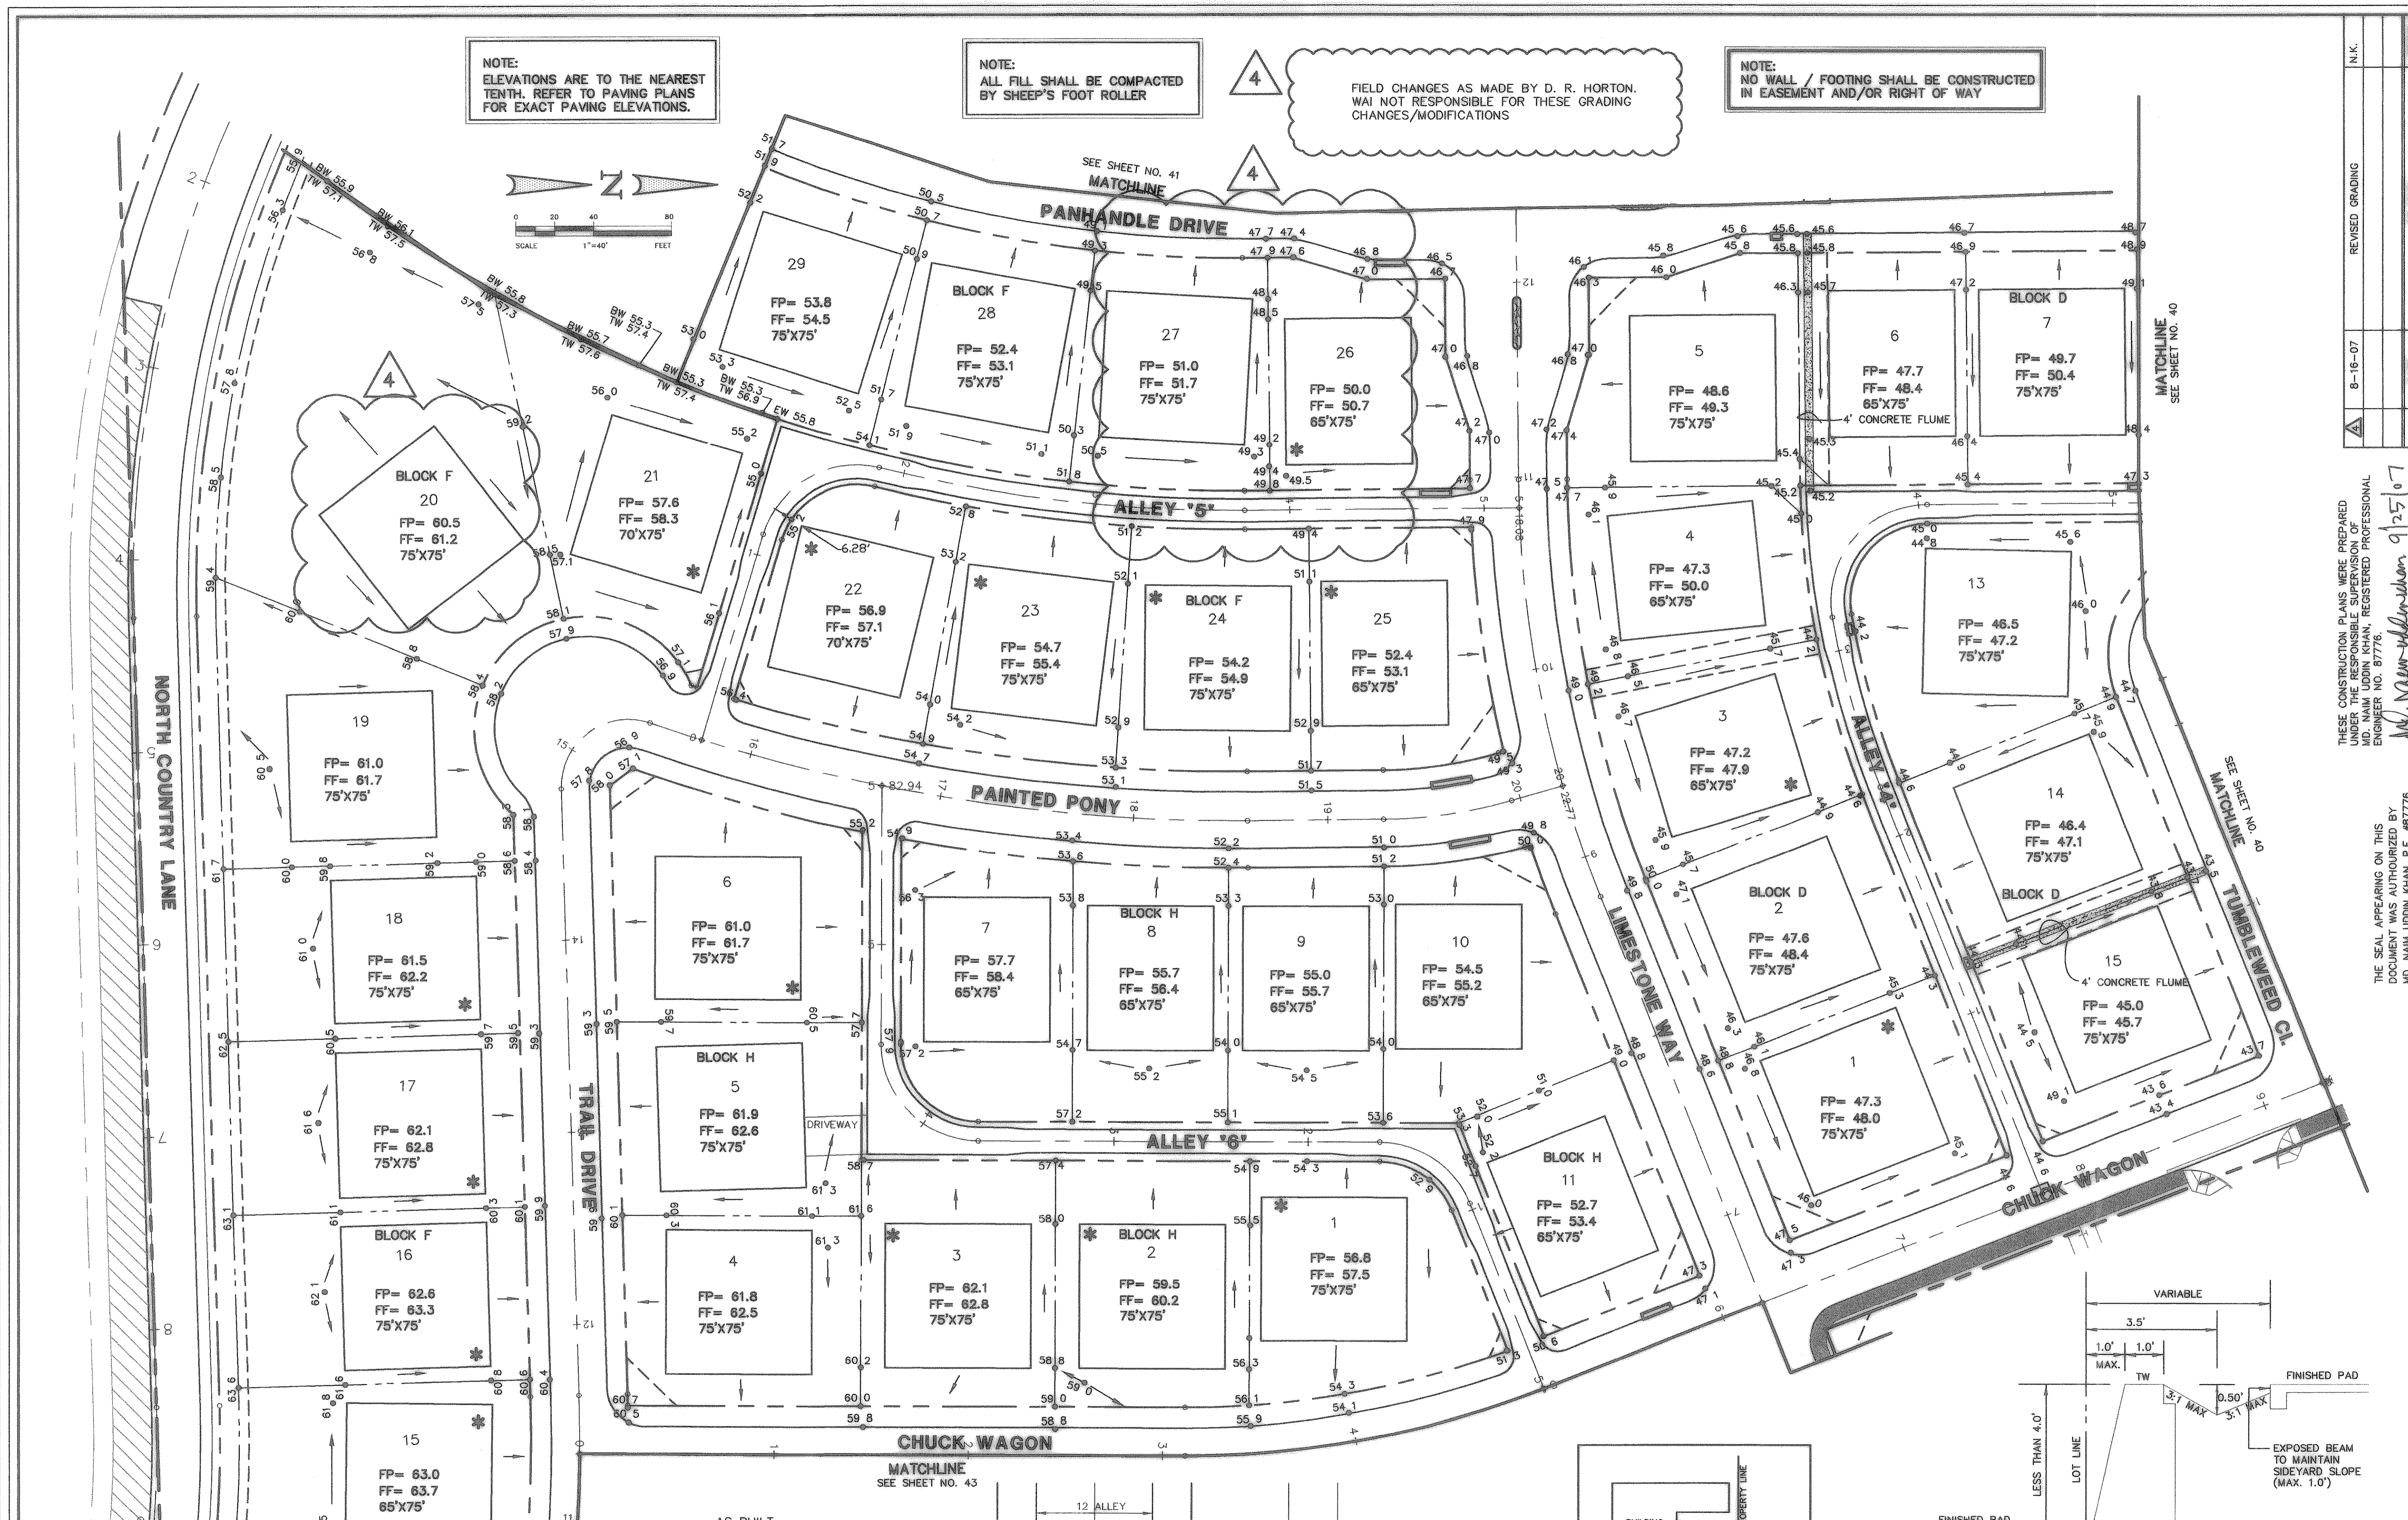

BENCHMARK 1 USGS Monument—stamped Boren 1986
Located approximately 1.25 miles east of Rockwall at the Rockwall Municipal Airport, in the north end of a circular grass area at the end of a taxiway.
ELEVATION = 574.77

BENCHMARK 2 USGS Monument—5" cap stamped N 1495/1986
Located 24.6 feet west of the center of a paved ramp leading to the Rockwall Municipal Airport, 16.4 feet south of a utility pole with a transformer and light, 2 feet west of the north leg of a sign. Access to datum point is through a 5 inch logo cap.
ELEVATION = 567.44

AS BUILT
To the best of our knowledge "Winkelman and Associates, Inc." hereby states that this plan is "As-Built". The information is based on surveying conducted at the site and modification information provided by "the Contractor".
D. R. Horton 9/25/07
WINKELMANN & ASSOCIATES, INC. DATE

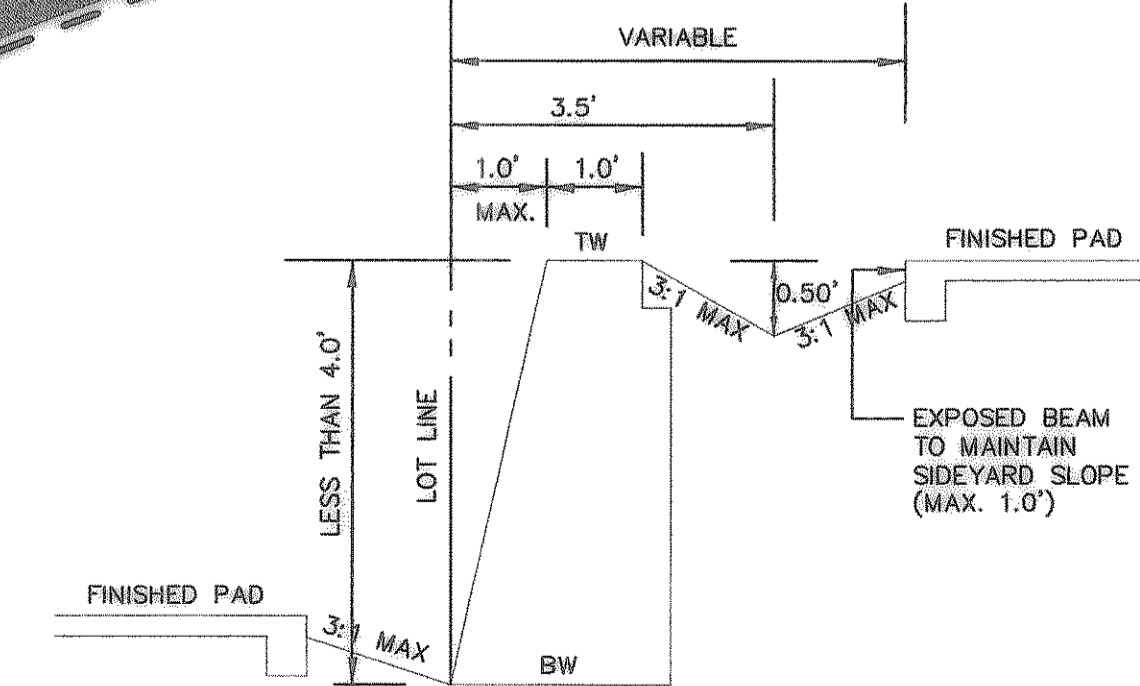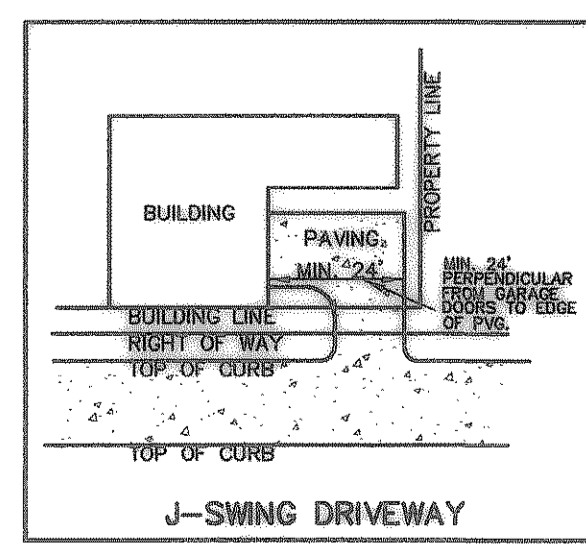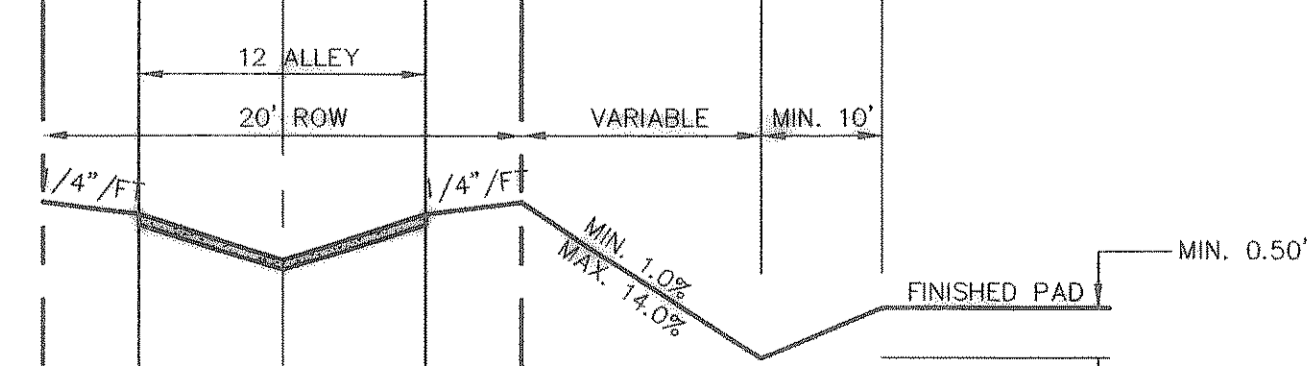

NOTE:
SIDE YARD RETAINING WALLS TO RAMP AT 4:1 SLOPE TO GRADE AT FRONT & BACK PAD LINES UNLESS OTHERWISE NOTED ON PLANS
N.T.S.

NO.	DATE	REVISION	APPROVED
1	8-16-07	REVISED GRADING	N.K.

Winkelman & Associates, Inc.
CONSULTING CIVIL ENGINEERS & SURVEYORS
2500 HURST ROAD, SUITE 100
DALLAS, TEXAS 75229
(972) 465-7299 FAX
COPYRIGHT © 2003, WINKELMANN & ASSOCIATES, INC.

THESE CONSTRUCTION PLANS WERE PREPARED UNDER THE RESPONSIBLE SUPERVISION OF MECHANICAL ENGINEER, REGISTERED PROFESSIONAL ENGINEER NO. 87776
D. R. Horton 9/25/07

JOHN M. GLASS SURVEY ABSTRACT NO. 88
CITY OF ROCKWALL, TEXAS
ROCKWALL COUNTY, TEXAS
D. R. HORTON
4306 MILLER ROAD, SUITE A
ROWLETT, TEXAS 75088
214-607-4244

THE SEAL APPEARING ON THIS DOCUMENT WAS AUTHORIZED BY
MD. NAIM UDDIN KHAN, P.E. #87776

LOT GRADING PLAN

Scale: 1"=40'
Designed By: MS
Drawn By: MS
Checked By: NK
File: 40709LGrv.dwg View: LGS
Project No.: 40709.00

Date: 09/08/06
SHEET 42 OF 45