


LEGEND

- TO = TOP OF GROUND
- TP = TOP OF PAVEMENT
- FP = FINISHED PAD
- FF = FINISHED FLOOR
- TW = TOP OF WALL
- BW = BOTTOM OF WALL
- EW = END OF WALL
- 570 EXISTING CONTOURS
- 560 PROP. CONTOURS
- 61.5 PROP. SPOT ELEVATION
- +556.56 EXIST. SPOT ELEVATION
- FLOW ARROWS
- LOT 1A 10' FOR SCREENING PED. & LANDSCAPING TO HOA
- * INDICATES SIDE OF LOT WHERE DRIVEWAY MUST BE LOCATED DUE TO GRADE DIFFERENTIAL OR INLET LOCATION
- D.E. = DRAINAGE EASEMENT

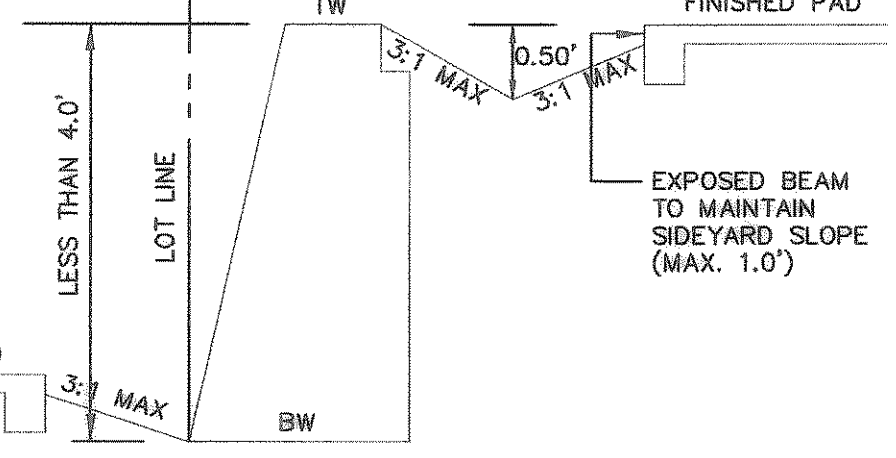


NOTE: SIDE YARD RETAINING WALLS TO RAMP AT 4:1 SLOPE TO GRADE AT FRONT & BACK PAD LINES UNLESS OTHERWISE NOTED ON PLANS

TYPICAL GRADING AT SIDE YARD & RETAINING WALL BETWEEN LOTS N.T.S.

NO.	DATE	REVISION	APPROVAL
5-2-07		REVISED GRADING	
5-31-07		REVISED GRADING & PAD 4 MOVED 20' NORTH	
8-16-07		REVISED GRADING & PAD 4 MOVED 25' EAST	

Winkelmann & Associates, Inc.
 CONSULTING ENGINEERS & SURVEYORS
 6710 MILLER ROAD, SUITE 100
 ROCKWALL, TEXAS 75087
 (972) 462-7999
 FAX (972) 462-7998
 COPYRIGHT ©2003, WINKELMANN & ASSOCIATES, INC.

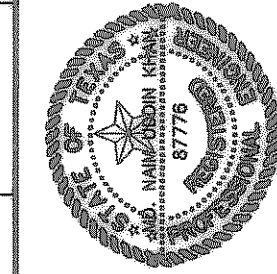

JOHN M. GLASS SURVEY ABSTRACT No. 86
 CITY OF ROCKWALL
 ROCKWALL COUNTY, TEXAS
 D. R. HORTON
 4306 MILLER ROAD, SUITE A
 ROCKWALL, TEXAS 75086
 214-907-4244

LOT GRADING PLAN

Scale: 1"=40'
 Date: 09/08/06
 Designed By: MS
 Drawn By: MS
 Checked By: NK
 File: 40708LGrv.dwg Rev: LG1
 Project No.: 40708.00

SHEET 40 OF 45

BENCHMARK 1 USGS Monument-stamped Boren 1986
 Located approximately 1.25 miles east of Rockwall at the Rockwall Municipal Airport, in the north end of a circular grass area at the end of a taxiway.
 ELEVATION = 574.77

BENCHMARK 2 USGS Monument-5" cap stamped N 1495/1986
 Located 24.6 feet west of the center of a paved ramp leading to the Rockwall Municipal Airport, 16.4 feet south of a utility pole with a transformer and light, 2 feet west of the north leg of a sign. Access to datum point is through a 5 inch logo cap.
 ELEVATION = 567.44

FIELD CHANGES AS MADE BY D. R. HORTON
 WAI NOT RESPONSIBLE FOR THESE GRADING CHANGES/MODIFICATIONS

SEE SHEET NO. 41
MATCHLINE

SEE SHEET NO. 42
MATCHLINE

NOTE:
 ALL FILL SHALL BE COMPACTED BY SHEEP'S FOOT ROLLER

NOTE:
 ELEVATIONS ARE TO THE NEAREST TENTH. REFER TO PAVING PLANS FOR EXACT PAVING ELEVATIONS.

THE SEAL APPEARING ON THIS DOCUMENT WAS AUTHORIZED BY MD. NAIM UDDIN KHAN, P.E. #87776

NOTE:
 NO WALL / FOOTING SHALL BE CONSTRUCTED IN EASEMENT AND/OR RIGHT OF WAY

THESE CONSTRUCTION PLANS WERE PREPARED UNDER THE RESPONSIBLE SUPERVISION OF MD. NAIM UDDIN KHAN, REGISTERED PROFESSIONAL ENGINEER NO. 87776.