


AS BUILT
 To the best of our knowledge "Winkelmann and Associates, Inc." hereby states that this plan is "As-Built". The information is based on surveying conducted at the site and modification information provided by "the Contractor".
 W. N. Winkelmann 9/25/07
 WINKELMANN & ASSOCIATES, INC. DATE

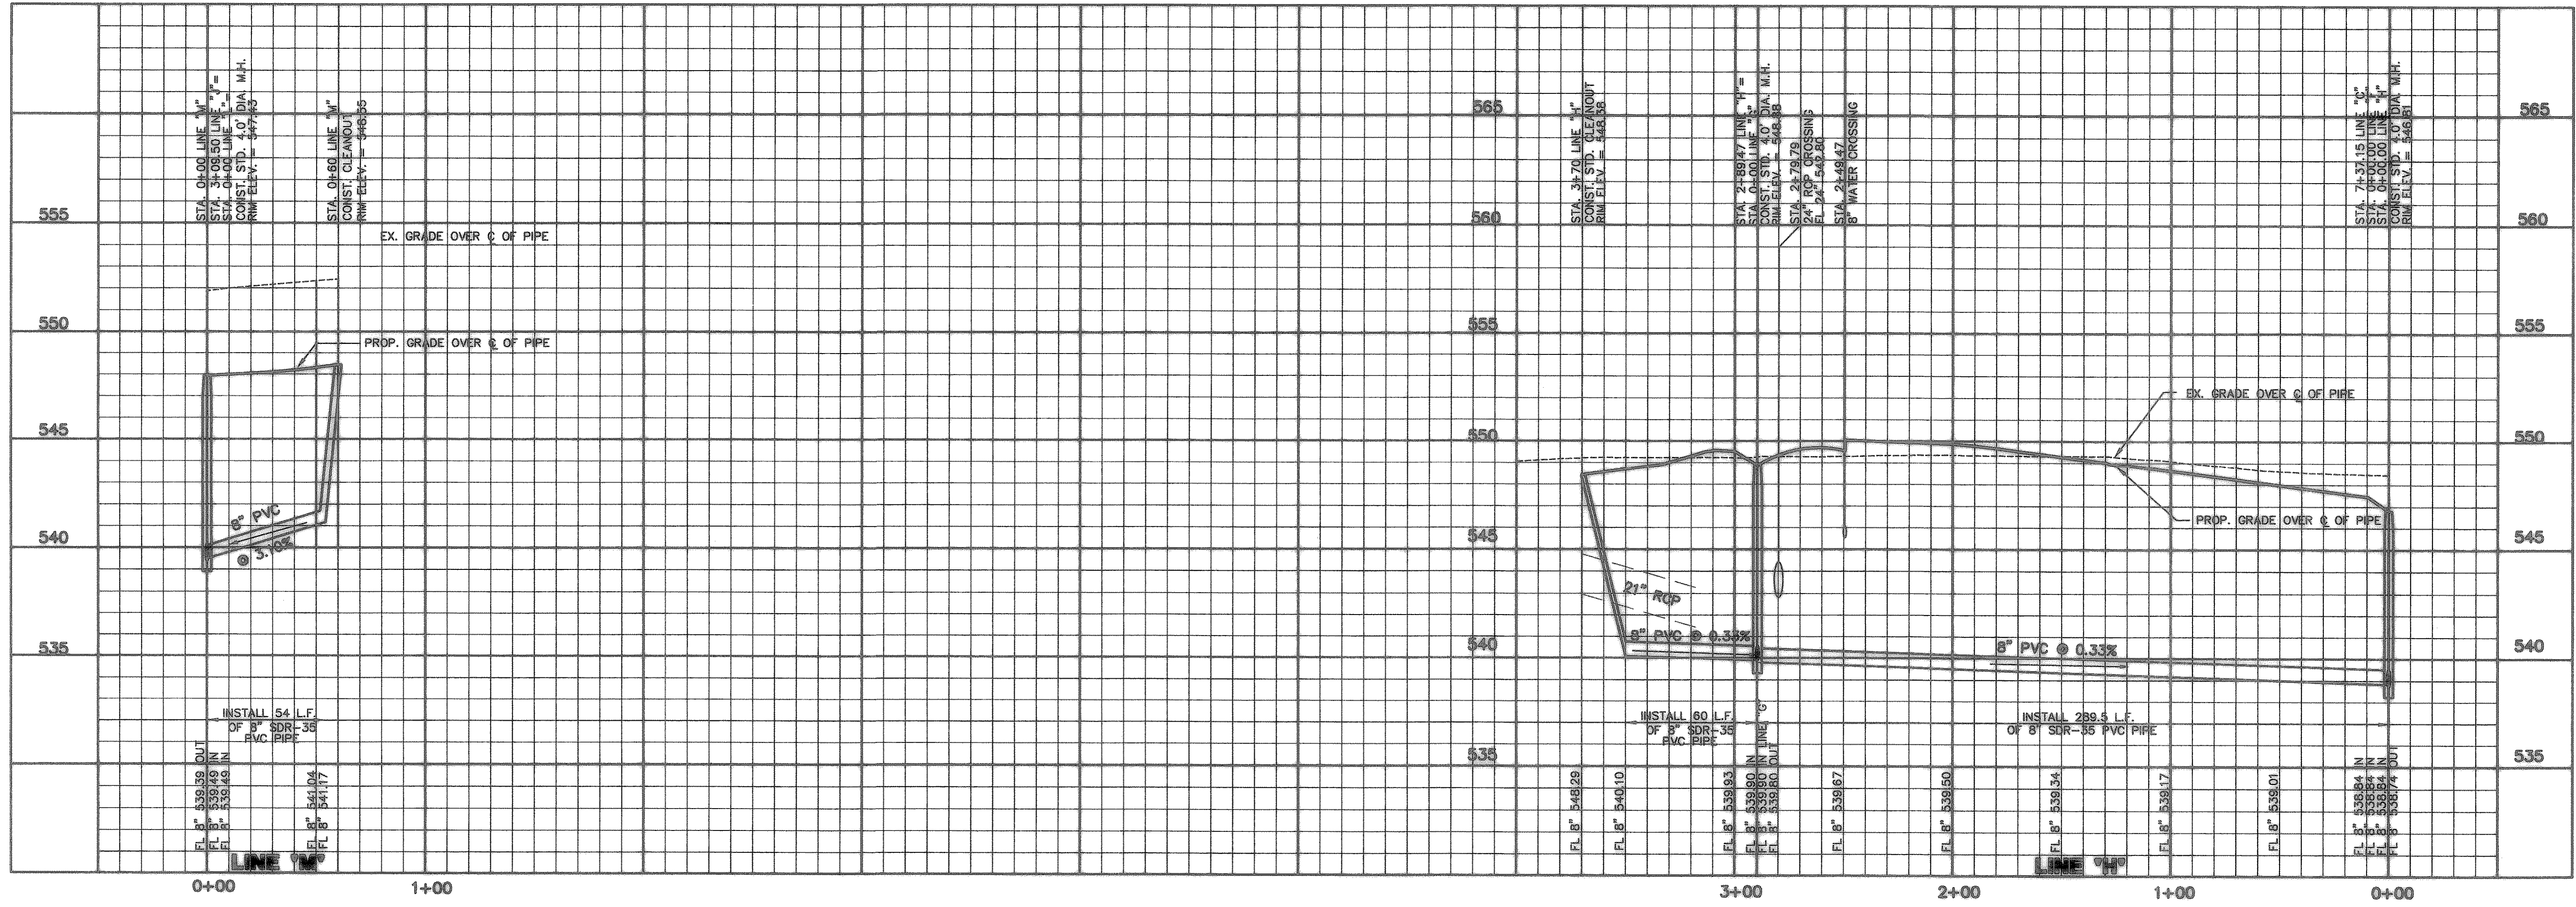

THESE CONSTRUCTION PLANS WERE PREPARED AND DESIGNED UNDER THE CLOSE SUPERVISION OF ME, THE PROFESSIONAL ENGINEER, REGISTERED PROFESSIONAL ENGINEER NO. 87776.

APPROVED: *W. N. Winkelmann* 9/25/07
 WINKELMANN & ASSOCIATES, INC. DATE

THESE CONSTRUCTION PLANS WERE PREPARED AND DESIGNED UNDER THE CLOSE SUPERVISION OF ME, THE PROFESSIONAL ENGINEER, REGISTERED PROFESSIONAL ENGINEER NO. 87776.

APPROVED: *John M. Glass* 9/18/06
 JOHN M. GLASS SURVEY ABSTRACT NO. 88
 CITY OF ROCKWALL, TEXAS
 ROCKWALL COUNTY, TEXAS
 D R HORTON
 4306 MILLER ROAD, SUITE A
 ROCKWALL, TEXAS 75088
 214-607-4244

THE SEAL APPEARING ON THIS DOCUMENT WAS AUTHORIZED BY MD. NAIM UDDIN KHAN, P.E. #87776

BENCHMARK 2 USGS Monument-stamped Bore 1986 Located 24.6 feet west of the center of a paved road leading to Municipal Airport, in the north end of a circular grass area at the end of a driveway. Access to datum point is through a 6 inch logo cap. ELEVATION = 5 671.44

BENCHMARK 1 USGS Monument-stamped Bore 1986 Located 24.6 feet west of the center of a paved road leading to Municipal Airport, in the north end of a circular grass area at the end of a driveway. Access to datum point is through a 6 inch logo cap. ELEVATION = 5 711.11

Scale: 1" = 10' Date: 06/06/06
 Designed By: IT
 Drawn By: IT
 Checked By: NK
 File: 40709SSP.dwg View: SSP1
 Project No.: 40709.00

35A OF 45

SANITARY SEWER PROFILES
 LINE "B-1" - STA. 0+00 TO STA. 7+00
 LINE "H" - STA. 0+00 TO STA. 3+70.00
 LINE "M" - STA. 0+00 TO STA. 0+60

Winkelmann & Associates, Inc.
 CONSULTING CIVIL ENGINEERS & SURVEYORS
 8700 WILCOX PLAZA, SUITE 100
 DALLAS, TEXAS 75240
 (972) 981-7288 FAX