

AS BUILT
 To the best of our knowledge "Winkelman and Associates, Inc." hereby states that this plan is "As-Built". The information is based on surveying conducted at the site and modification information provided by "the Contractor".
W. M. Uddin Khan 9/25/07
 WINKELMANN & ASSOCIATES, INC. DATE

THESE CONSTRUCTION PLANS WERE PREPARED UNDER THE RESPONSIBLE SUPERVISION OF MD. NAIM UDDIN KHAN, REGISTERED PROFESSIONAL ENGINEER NO. 87776.
W. M. Uddin Khan 9/18/06

BENCHMARK 2 USGS Monument - 8" cap stamped N 1495/1986 Located 24.6 feet west of the center of a paved road leading to the Rockwall Municipal Airport, 16.4 feet south of a utility pole with a transformer and light pole, west of the north leg of a sign. ELEVATION = 547.44


BENCHMARK 1 USGS Monument - stamped Baren 1986 Located approximately 1.25 miles east of Rockwall at the Rockwall Municipal Airport, in the north end of a circular grass area at the ELEVATION = 574.71

STORM SEWER PROFILES
 LINE 7^B - STA. 1+14.64 TO STA. 9+27.49
 LINE 7^C - STA. 1+00.00 TO STA. 5+74.55
 LINE 8^A - STA. 1+00.00 TO STA. 2+73.60

Seals: *W. M. Uddin Khan* Date: 06/06/06
 Designed By: IT / RS
 Drawn By: IT / RS
 Checked By: NK
 File: 4070951P.dwg View:
 Project No.: 41502.0B

SHEET
 27
 OF
 45

JOHN M. GLASS SURVEY ABSTRACT NO. 86
 CITY OF ROCKWALL
 ROCKWALL COUNTY, TEXAS
 D. R. HORTON
 4306 MILLER ROAD, SUITE A
 ROWLETT, TEXAS 75088
 214-607-4244

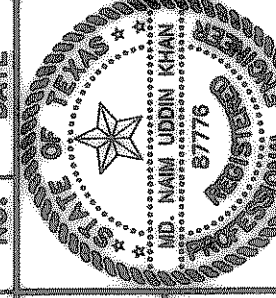

Winkelman & Associates, Inc.
 CONSULTING CIVIL ENGINEERS & SURVEYORS
 6700 MILLER PLAZA, SUITE 100
 DALLAS, TEXAS 75226
 (972) 492-7000 FAX
 (972) 492-7000 FAX

NO.	DATE	REVISION	APPROV.