

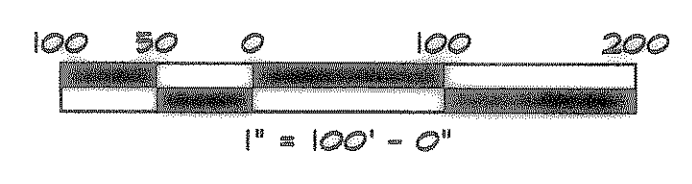


RECORD DOCUMENTS
 THESE RECORD DOCUMENTS HAVE BEEN PREPARED BASED ON INFORMATION PROVIDED BY OTHERS. JONES & BOYD, INC. HAS NOT VERIFIED THE ACCURACY AND/OR COMPLETENESS OF THIS INFORMATION, UNLESS OTHERWISE NOTED ON THESE DOCUMENTS. JONES & BOYD, INC. SHALL NOT BE RESPONSIBLE FOR ANY ERRORS OR OMISSIONS THAT MAY BE INCORPORATED AS A RESULT OF ERRONEOUS INFORMATION PROVIDED BY OTHERS.
 JONES & BOYD, INC.
 BY: *[Signature]*
 DATE: 10.18.2007

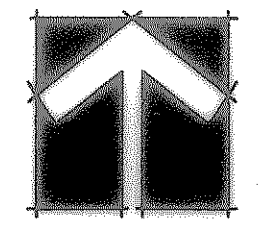

NO.	REVISIONS DURING CONSTRUCTION	BY	DATE	NO.	REVISIONS DURING PLAN REVIEW	BY	DATE
				5	CITY COMMENTS	TLM	4/26/07
				4	CITY COMMENTS	TLM	4/16/07
				3	REVISED SCREENING LAYOUT	TLM	4/10/07
				2	CITY COMMENTS	TLM	4/6/06
				1	CITY COMMENTS	TLM	8/13/06

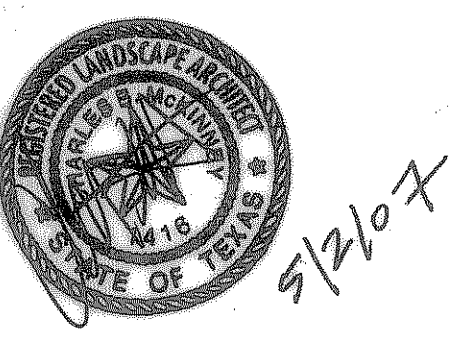

Jones & Boyd, Inc.
 17090 Dallas Parkway, Suite 200
 Dallas, Texas 75248
 972.248.7676 office
 972.248.1414 fax
 www.jones-boyd.com

- Engineering
- Surveying
- Planning
- Landscape Architecture
- Construction Management

SCREENING/ LANDSCAPE PLAN		PROJECT NO.
Overall Plan		HOE048
Dalton Ranch		SHEET NO.
City of Rockwall, Rockwall County, Texas		L1