
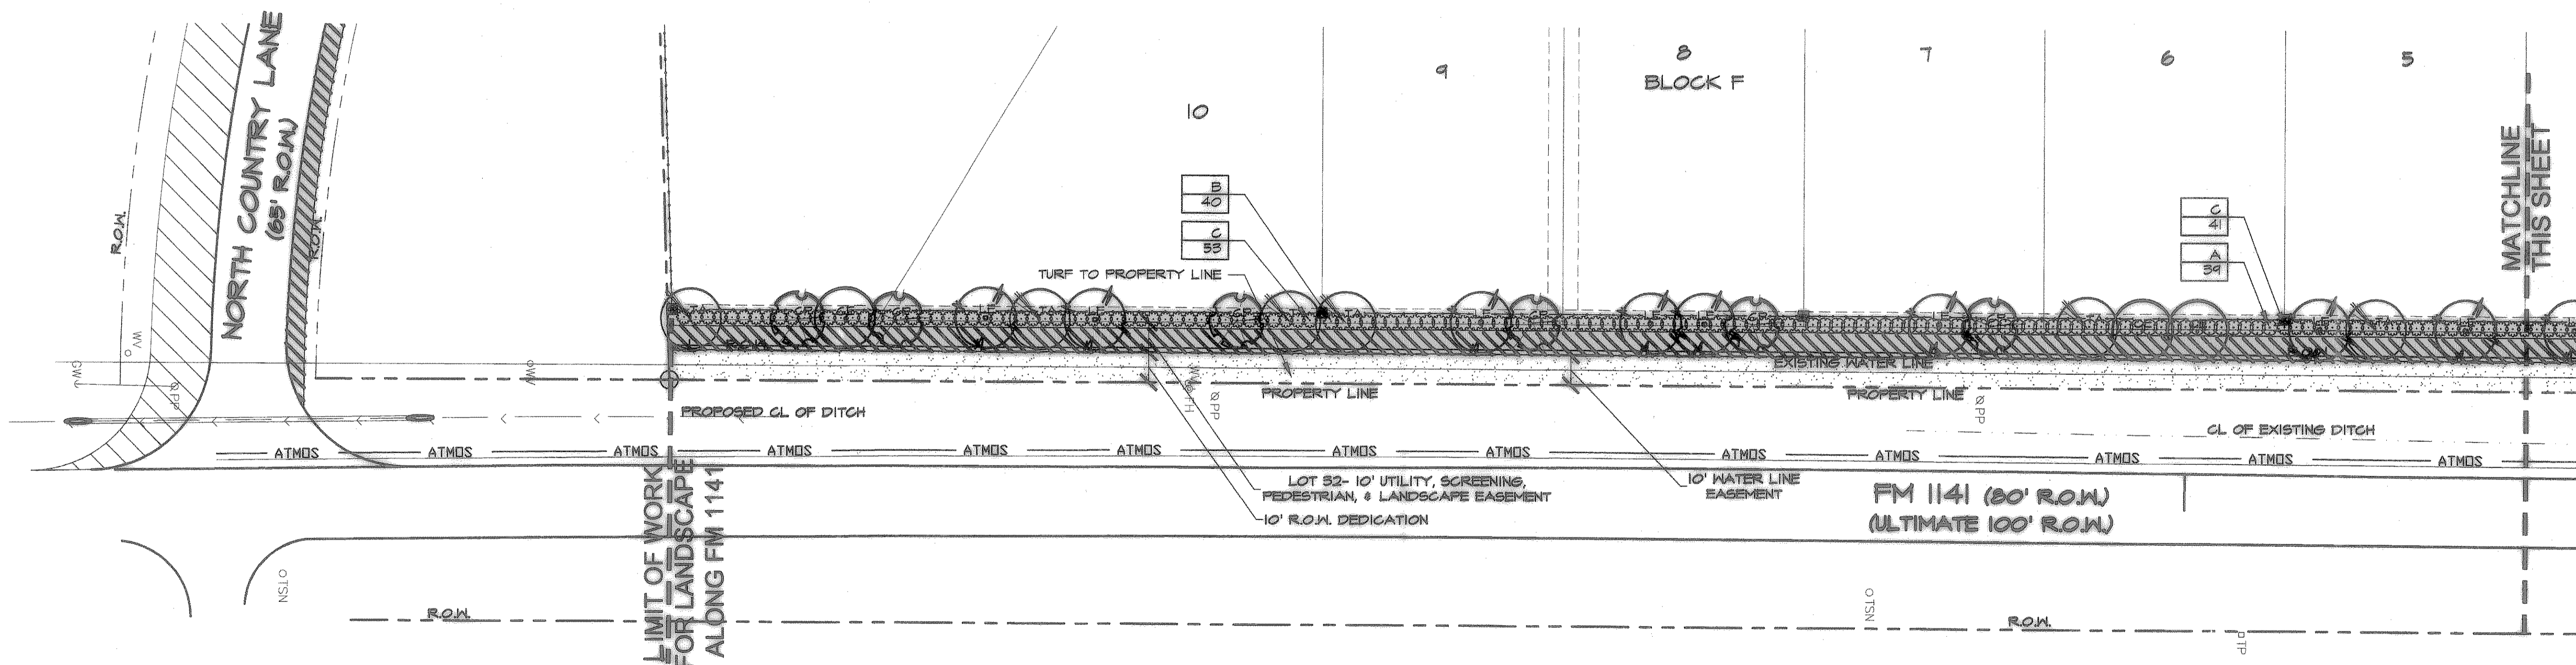
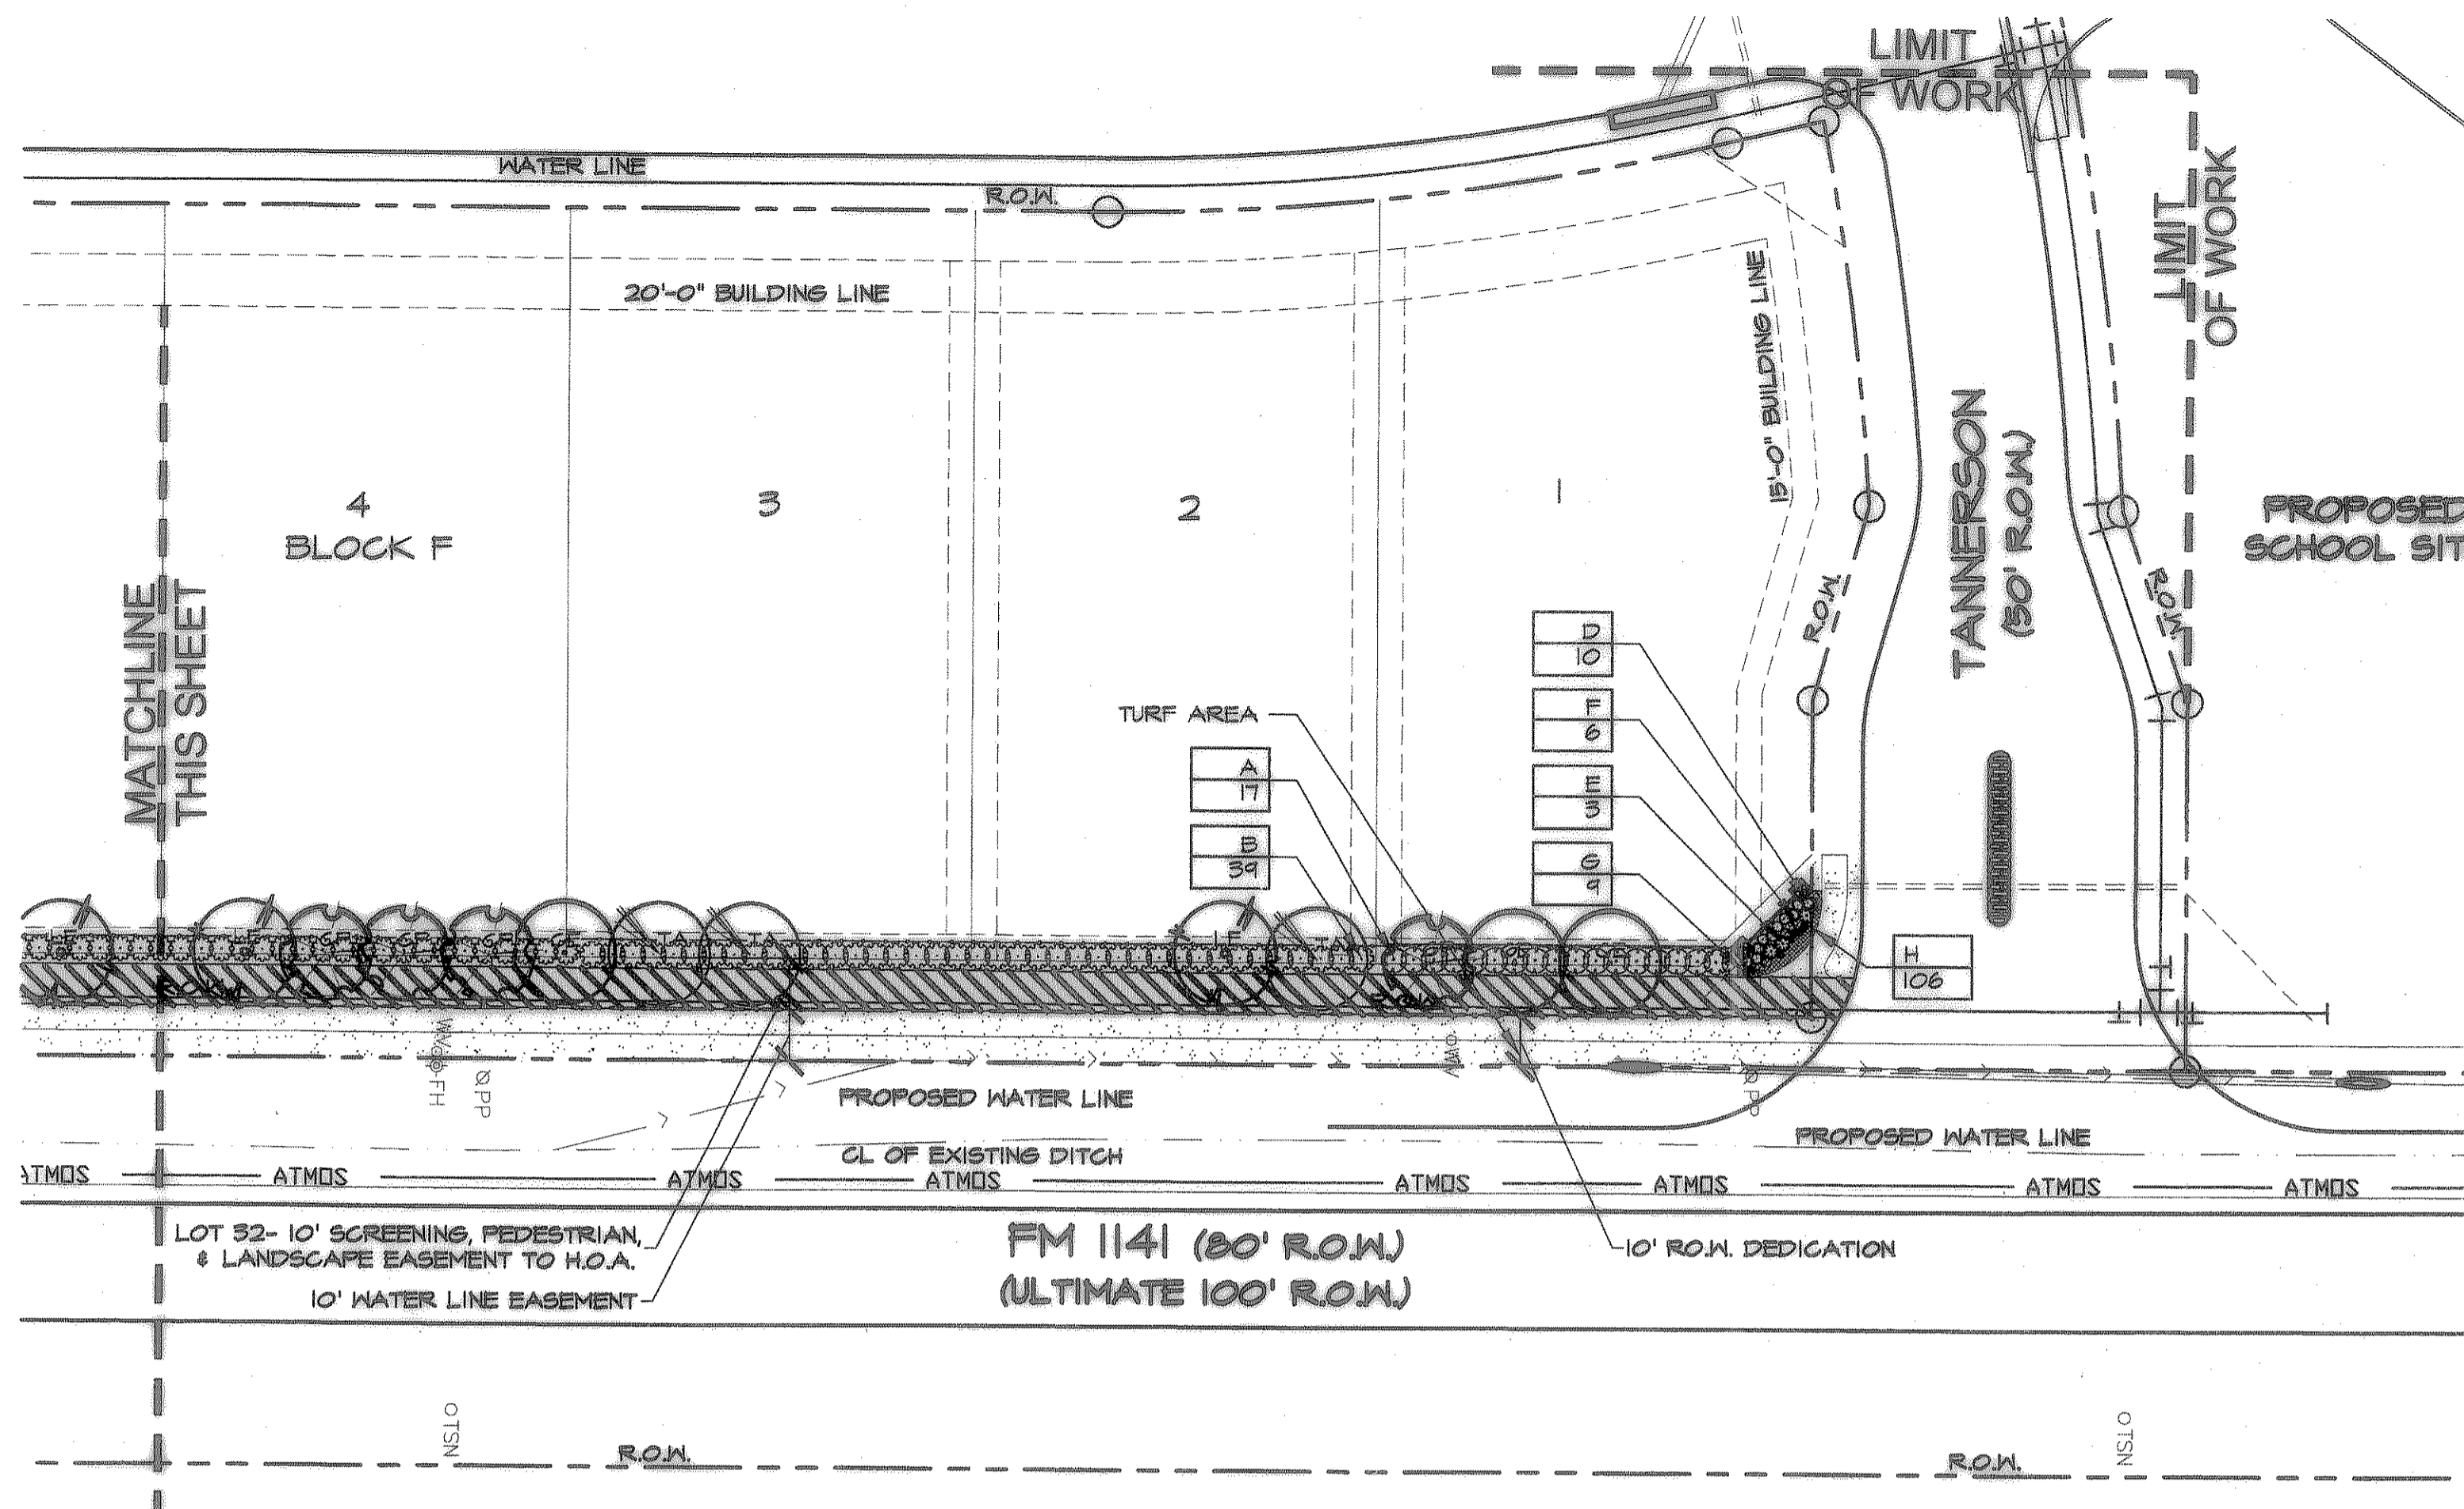


LANDSCAPE LEGEND

- | | | | |
|--|-------------------|---|---------------------------|
| | CEDAR ELM | | DALLAS RED' GRAPE MYRTLE |
| | LACEBARK ELM | A | DWARF WAX MYRTLE |
| | TEXAS ASH | B | 'GREEN CLOUD' TEXAS SAGE |
| | CHINESE PISTACHIO | C | ELAEGNUS |
| | LIVE OAK | D | 'ADAGIO' ORNAMENTAL GRASS |
| | | E | RED YUGGA |
| | | F | 'FIREPOWER' NANDINA |
| | | G | 'HAMELN' ORNAMENTAL GRASS |
| | | H | 'BIG BLUE' LIRIOPE |
| | | J | SEASONAL COLOR |
| | | | COMMON BERMUDA HYDROMULCH |


NOTE:
NO TREES WITHIN
5'-0" OF ANY
UTILITIES

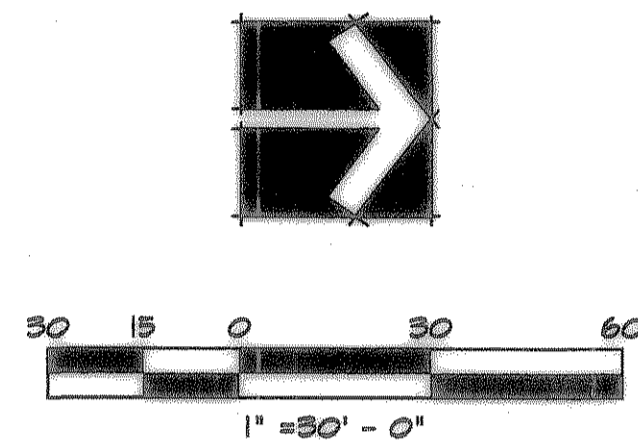

RECORD DOCUMENTS
THESE RECORD DOCUMENTS HAVE BEEN PREPARED BASED ON INFORMATION PROVIDED BY OTHERS. JONES & BOYD, INC. HAS NOT VERIFIED THE ACCURACY AND/OR COMPLETENESS OF THIS INFORMATION, UNLESS OTHERWISE NOTED ON THESE DOCUMENTS. JONES & BOYD, INC. SHALL NOT BE RESPONSIBLE FOR ANY ERRORS OR OMISSIONS THAT MAY BE INCORPORATED AS A RESULT OF ERRONEOUS INFORMATION PROVIDED BY OTHERS.

JONES & BOYD, INC.
BY: *[Signature]*
DATE: 10.18.2007

NO.	REVISIONS DURING CONSTRUCTION	BY	DATE	NO.	REVISIONS DURING PLAN REVIEW	BY	DATE
				5	CITY COMMENTS	TLM	4/26/07
				4	CITY COMMENTS	TLM	4/16/07
				3	REVISED SCREENING LAYOUT	TLM	4/10/07
				2	CITY COMMENTS	TLM	4/6/06
				1	CITY COMMENTS	TLM	8/18/06

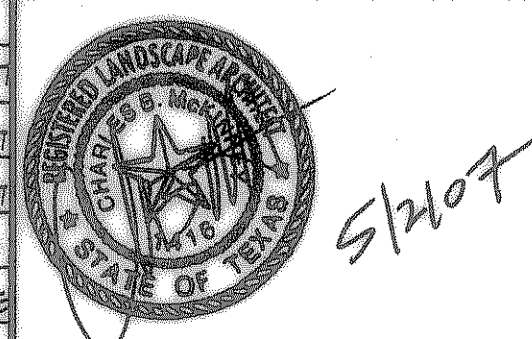

Jones & Boyd, Inc.
17090 Dallas Parkway, Suite 200
Dallas, Texas 75248
972.248.7676 office
972.248.1414 fax
www.jones-boyd.com

- Engineering
- Surveying
- Planning
- Landscape Architecture
- Construction Management

SCREENING/LANDSCAPE PLAN
Landscape Plan - FM 1141
Dalton Ranch
City of Rockwall, Rockwall County, Texas

PROJECT NO. HOE048
SHEET NO. L5