
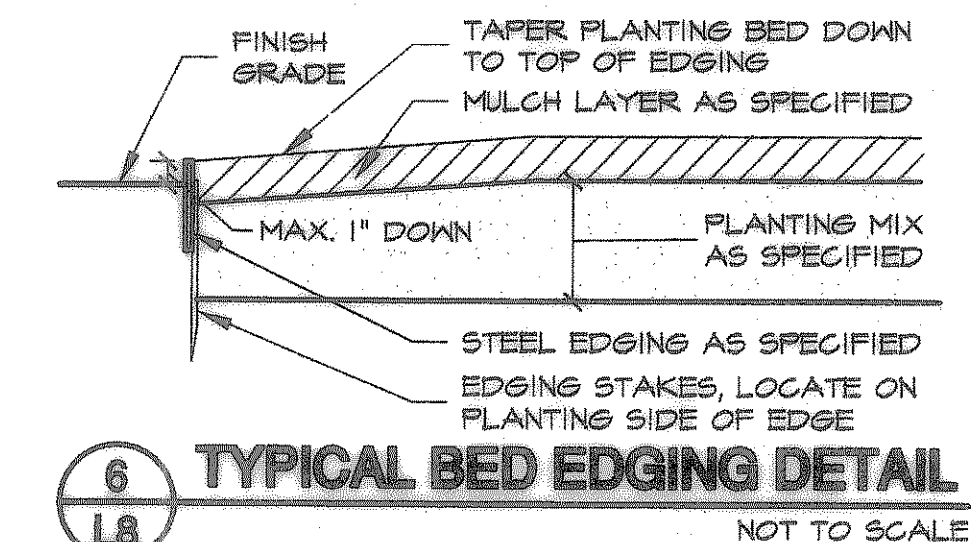
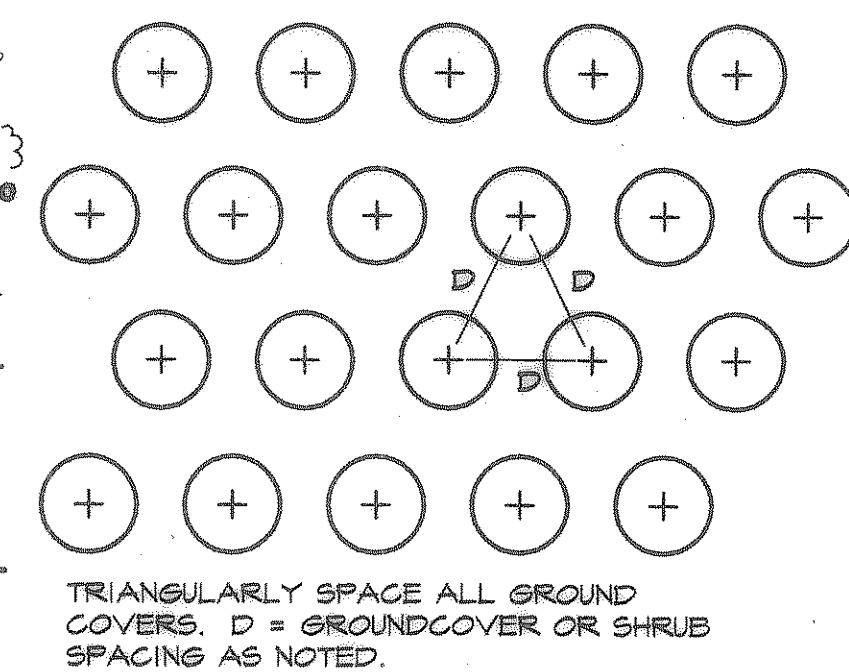
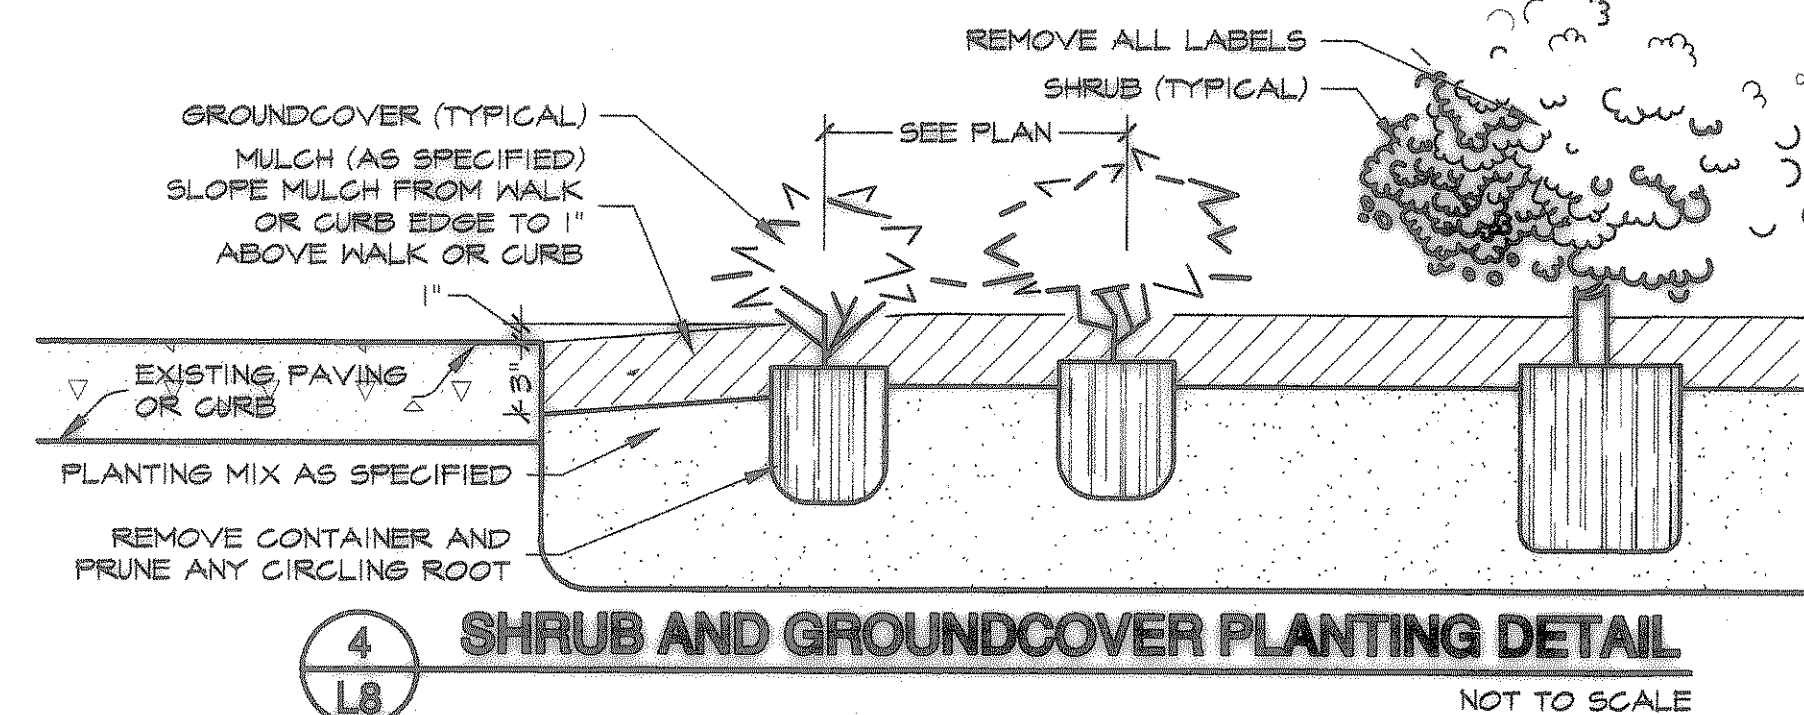
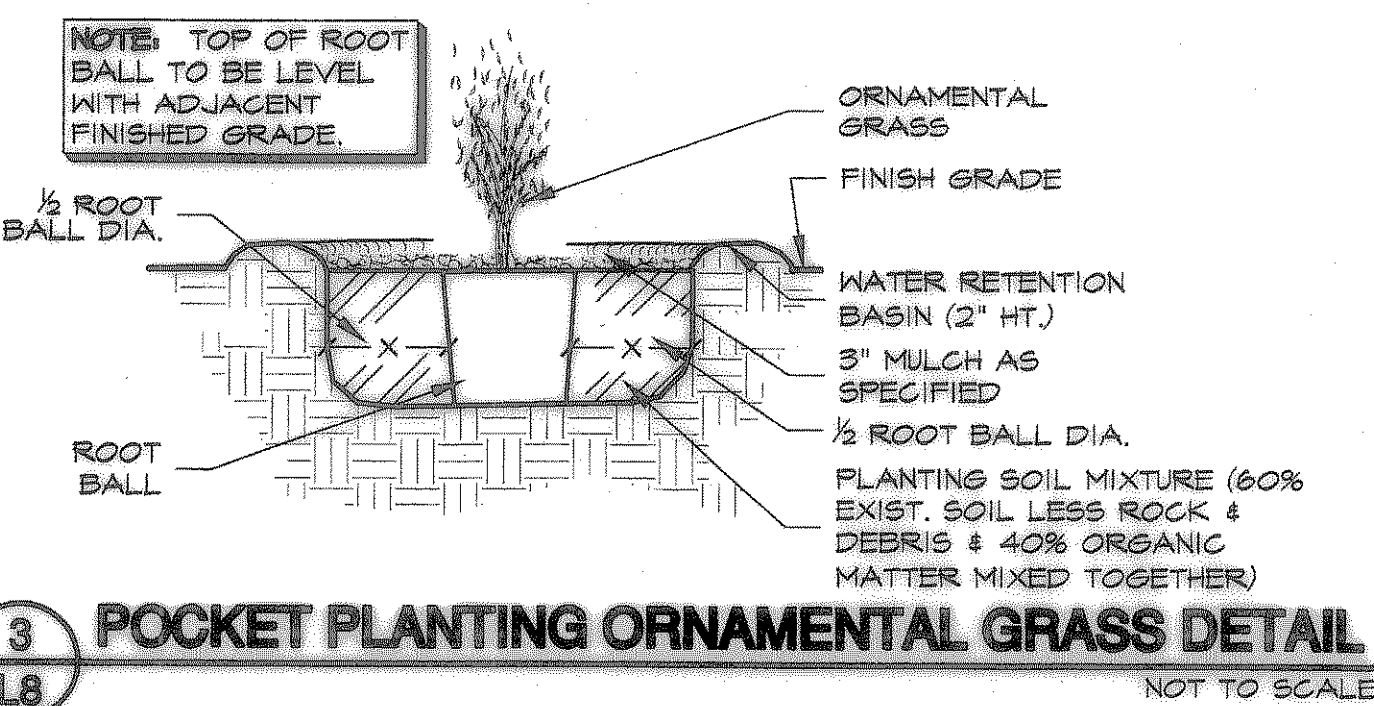
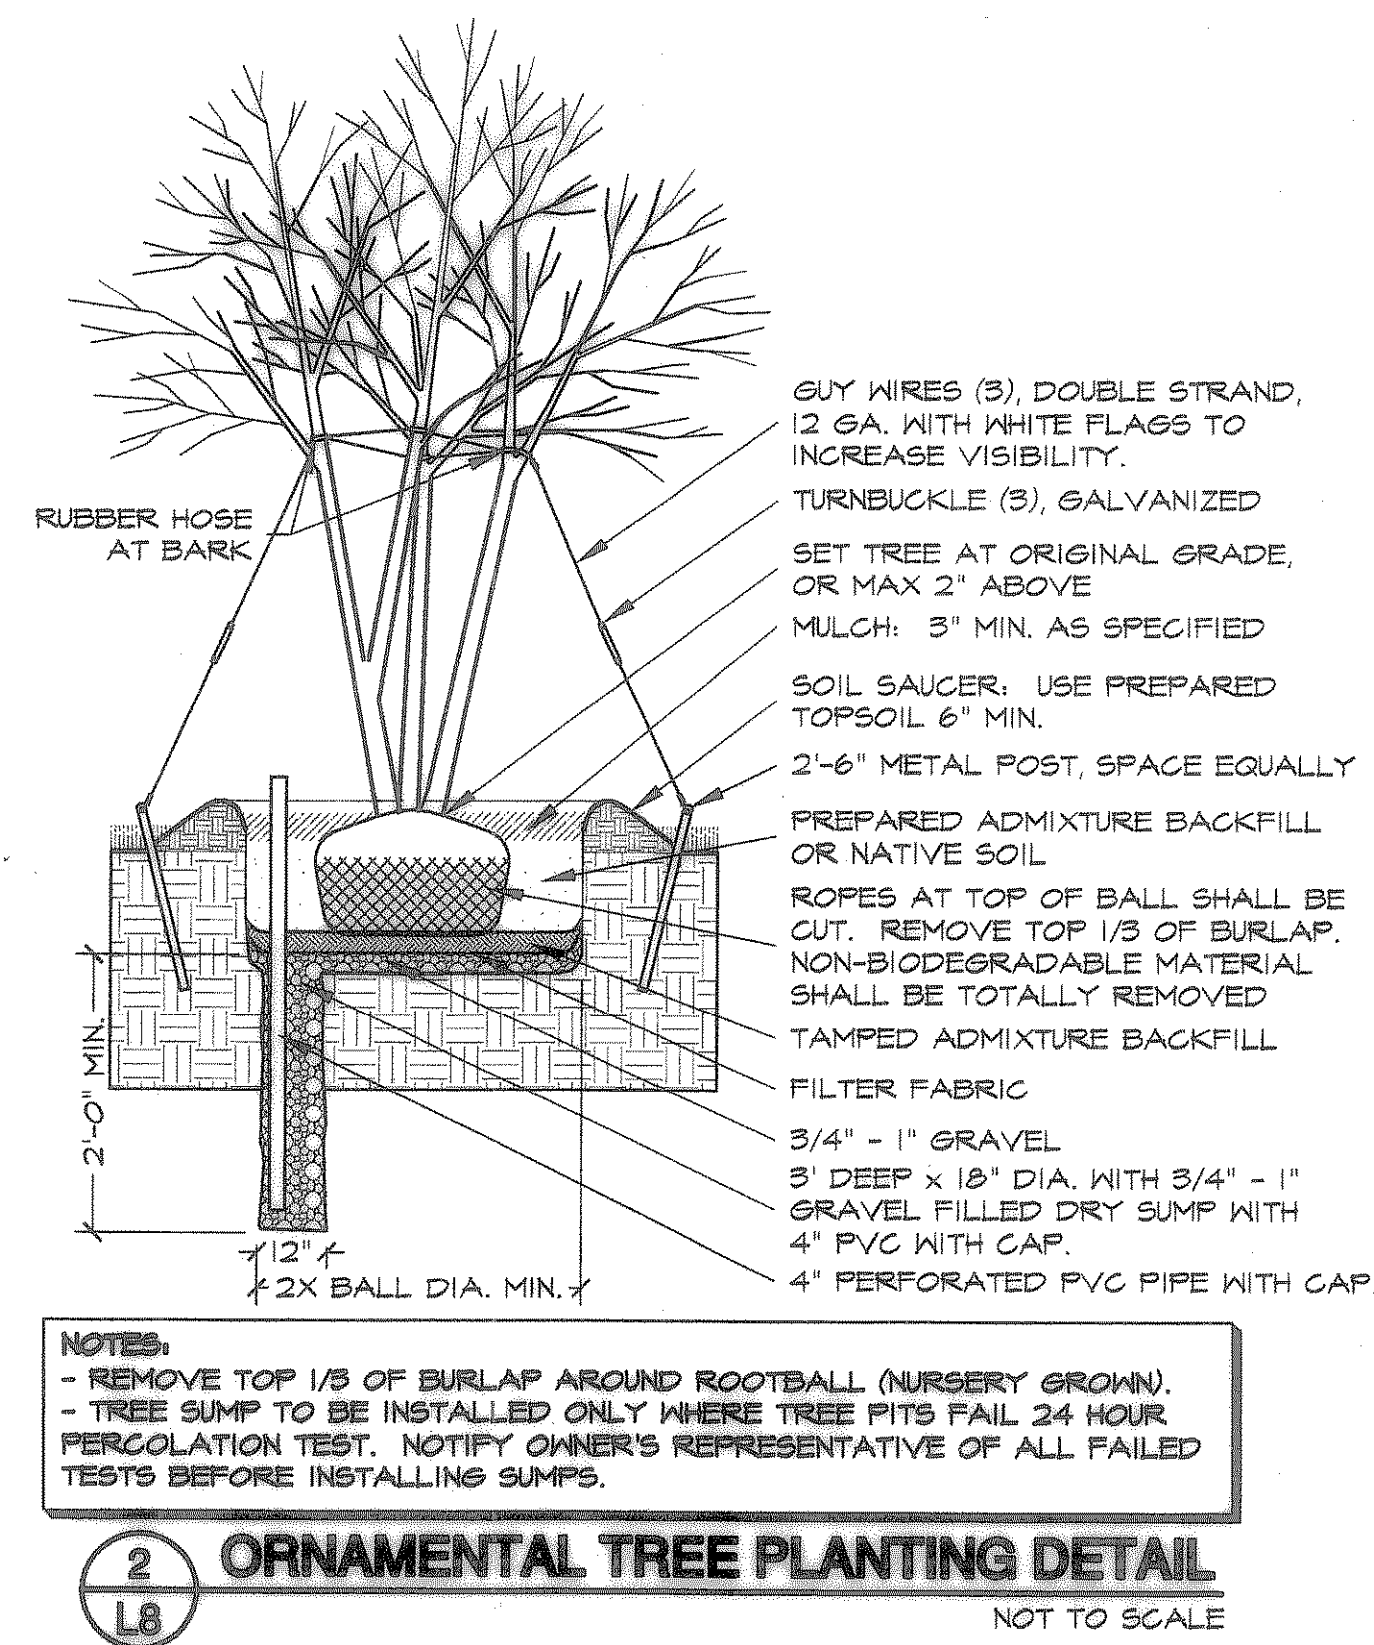


**DALTON RANCH PLANT LIST**

SYMBOL	COMMON/BOTANICAL NAME	SIZE	SPACING	QUANTITY	REMARKS
TA	TEXAS ASH / FRAXINUS TEXENSIS	3" CALIFER	AS SHOWN	26	6' MINIMUM SPREAD; 12' MINIMUM HEIGHT; FULL ROUNDED HEAD 6' MINIMUM BRANCHING HEIGHT; NURSERY GROWN
CP	CHINESE PISTACHE / PISTACIA CHINENSIS	3" CALIFER	AS SHOWN	30	6' MINIMUM SPREAD; 12' MINIMUM HEIGHT; FULL ROUNDED HEAD 6' MINIMUM BRANCHING HEIGHT; NURSERY GROWN
CE	CEDAR ELM / ULMUS CRASSIFOLIA	3" CALIFER	AS SHOWN	15	6' MINIMUM SPREAD; 12' MINIMUM HEIGHT; FULL ROUNDED HEAD 6' MINIMUM BRANCHING HEIGHT; NURSERY GROWN
LE	LACEBARK ELM / ULMUS PARVIFOLIA	3" CALIFER	AS SHOWN	26	6' MINIMUM SPREAD; 12' MINIMUM HEIGHT; FULL ROUNDED HEAD 6' MINIMUM BRANCHING HEIGHT; NURSERY GROWN
LO	LIVE OAK / QUERCUS VIRGINIANA	3" CALIFER	AS SHOWN	6	6' MINIMUM SPREAD; 12' MINIMUM HEIGHT; FULL ROUNDED HEAD 6' MINIMUM BRANCHING HEIGHT; NURSERY GROWN
CM	GRAPE MYRTLE / LAGERSTROEMIA INDICA 'PECOS'	6'-8" HT.	AS SHOWN	22	6'-8" MINIMUM HEIGHT; MINIMUM 3 CANES AT 1/3" CALIFER; FULL ROUNDED HEAD 6' MINIMUM BRANCHING HEIGHT; NURSERY GROWN
A	DWARF WAX MYRTLE / MYRTICA CERIFERA	5 GALLON	4' O.C.	157	CONTAINER GROWN; NURSERY GROWN
B	TEXAS SAGE / LEUCOPHYLLUM FRUTESCENS 'GREEN CLOUD'	5 GALLON	4' O.C.	264	CONTAINER GROWN; NURSERY GROWN
C	ELEAGNUS / ELEAGNUS SPP.	5 GALLON	4' O.C.	224	CONTAINER GROWN; NURSERY GROWN
D	ORNAMENTAL GRASS / MISCANTHUS SINENSIS 'ADAGIO'	5 GALLON	AS SHOWN	34	CONTAINER GROWN; NURSERY GROWN
E	RED YUCCA / YUCCA HESPERALOE	5 GALLON	AS SHOWN	18	CONTAINER GROWN; NURSERY GROWN
F	NANDINA / NANDINA DOMESTICA 'FIREPOWER'	5 GALLON	AS SHOWN	18	CONTAINER GROWN; NURSERY GROWN
G	ORNAMENTAL GRASS / FENNICETUM ALOPECUROIDES 'HAMEL'	1 GALLON	AS SHOWN	42	CONTAINER GROWN; NURSERY GROWN
H	SEASONAL COLOR BERMUDA GRASS / CYNODON DACTYLOIDES	4" POT	AS SHOWN	355	VARIETY DETERMINED AT TIME OF PLANTING
	BERMUDA GRASS / CYNODON DACTYLOIDES	HYDROMULCH	AS SHOWN	55,000 SF	COMMON BERMUDA GRASS
	BERMUDA GRASS / CYNODON DACTYLOIDES	SOLID SOD	AS SHOWN	4,000 SF	COMMON BERMUDA GRASS

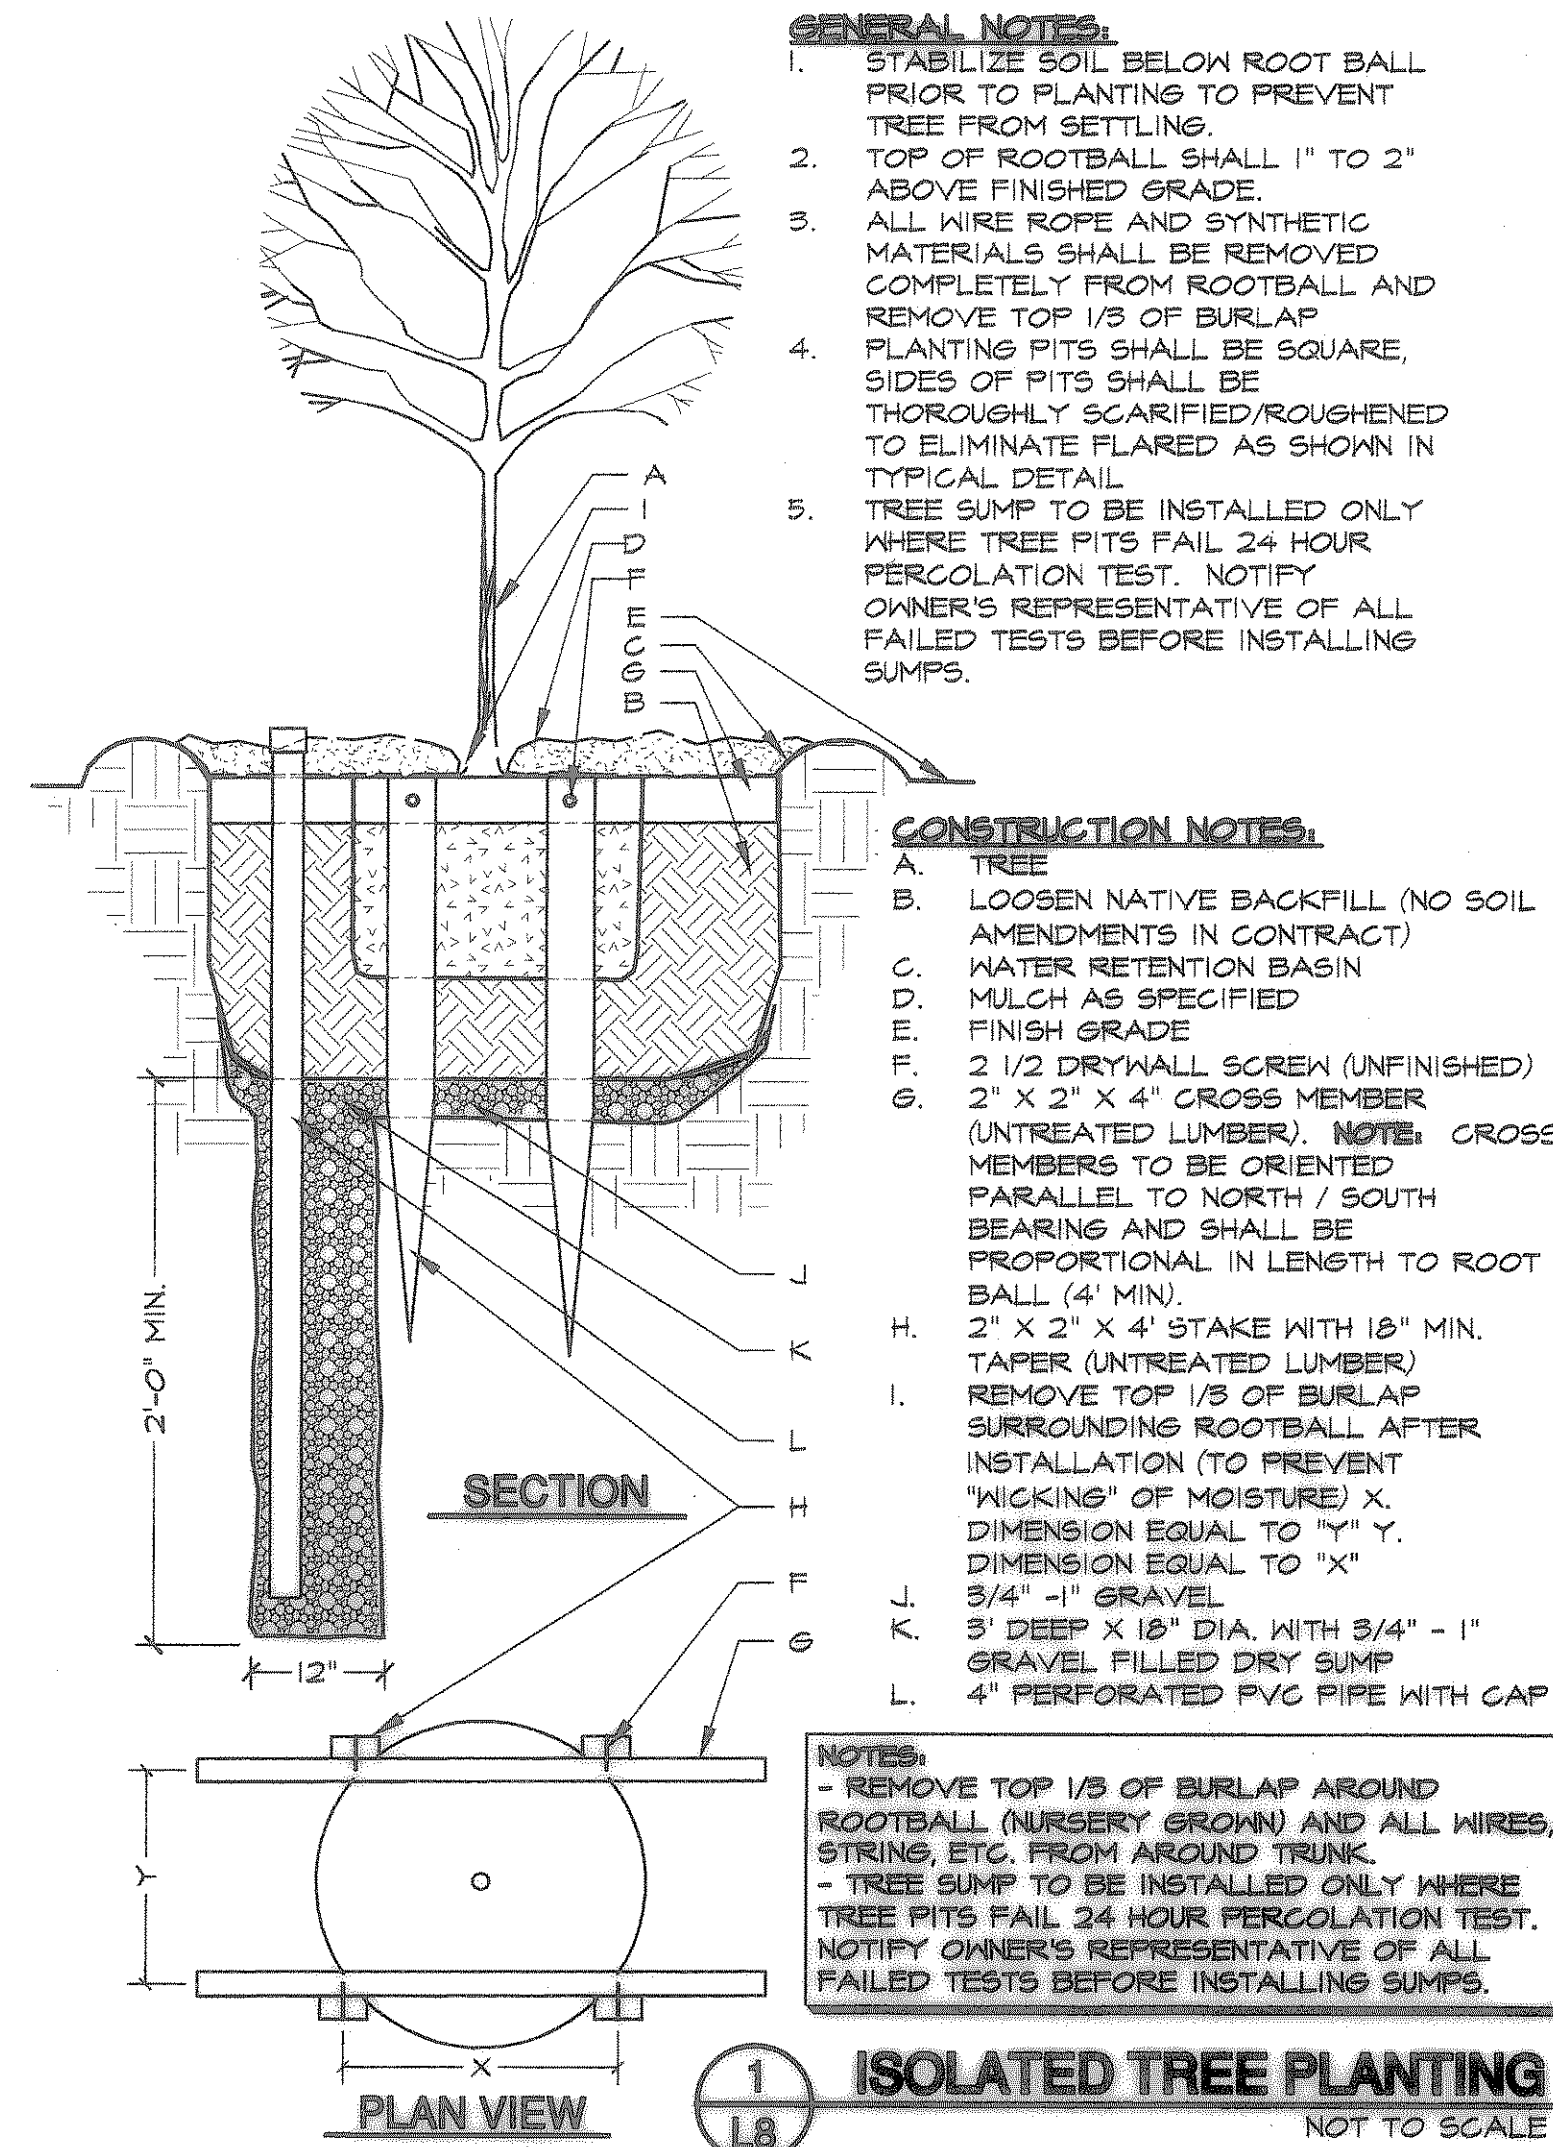


**RECORD DOCUMENTS**

THESE RECORD DOCUMENTS HAVE BEEN PREPARED BASED ON INFORMATION PROVIDED BY OTHERS. JONES & BOYD, INC., HAS NOT VERIFIED THE ACCURACY AND/OR COMPLETENESS OF THIS INFORMATION, UNLESS OTHERWISE NOTED ON THESE DOCUMENTS. JONES & BOYD, INC., SHALL NOT BE RESPONSIBLE FOR ANY ERRORS OR OMISSIONS THAT MAY BE INCORPORATED AS A RESULT OF ERRONEOUS INFORMATION PROVIDED BY OTHERS.

JONES & BOYD, INC.  
BY: *[Signature]*  
DATE: 10-18-2007

NO.	REVISIONS DURING CONSTRUCTION	BY	DATE	NO.	REVISIONS DURING PLAN REVIEW	BY	DATE
				5	CITY COMMENTS	TLM	4/26/07
				4	CITY COMMENTS	TLM	4/16/07
				3	REVISED SCREENING LAYOUT	TLM	4/10/07
				2	CITY COMMENTS	TLM	4/6/06
				1	CITY COMMENTS	TLM	8/13/06

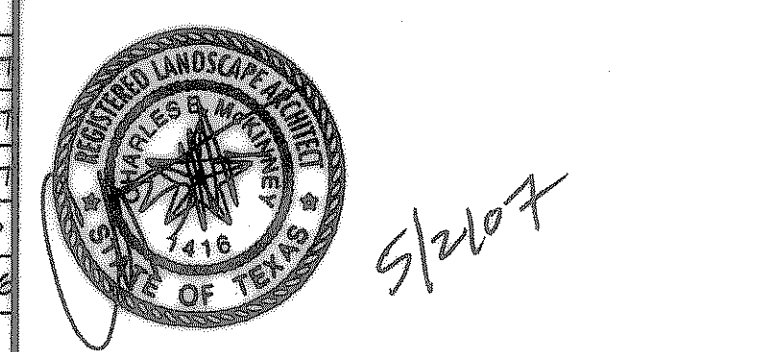

**Jones & Boyd, Inc.**

17090 Dallas Parkway, Suite 200  
Dallas, Texas 75248  
972.248.7676 office  
972.248.1414 fax  
www.jones-boyd.com

- Engineering
- Surveying
- Planning
- Landscape Architecture
- Construction Management

<b>SCREENING/ LANDSCAPE PLAN</b>		PROJECT NO.
Landscape Details & Plant Schedule		H0E048
Dalton Ranch		SHEET NO.
City of Rockwall, Rockwall County, Texas		L8