


REMOVE EX. 12" BLIND FLANGE
 CONN. TO EX. 12" FLANGED OUTLET
 INSTALL:
 1-12" 8" REDUCER
 2-8" 45° BENDS
 1-8" GATE VALVE

INSTALL:
 1-8" GATE VALVE
 1-8" BLIND FLANGE

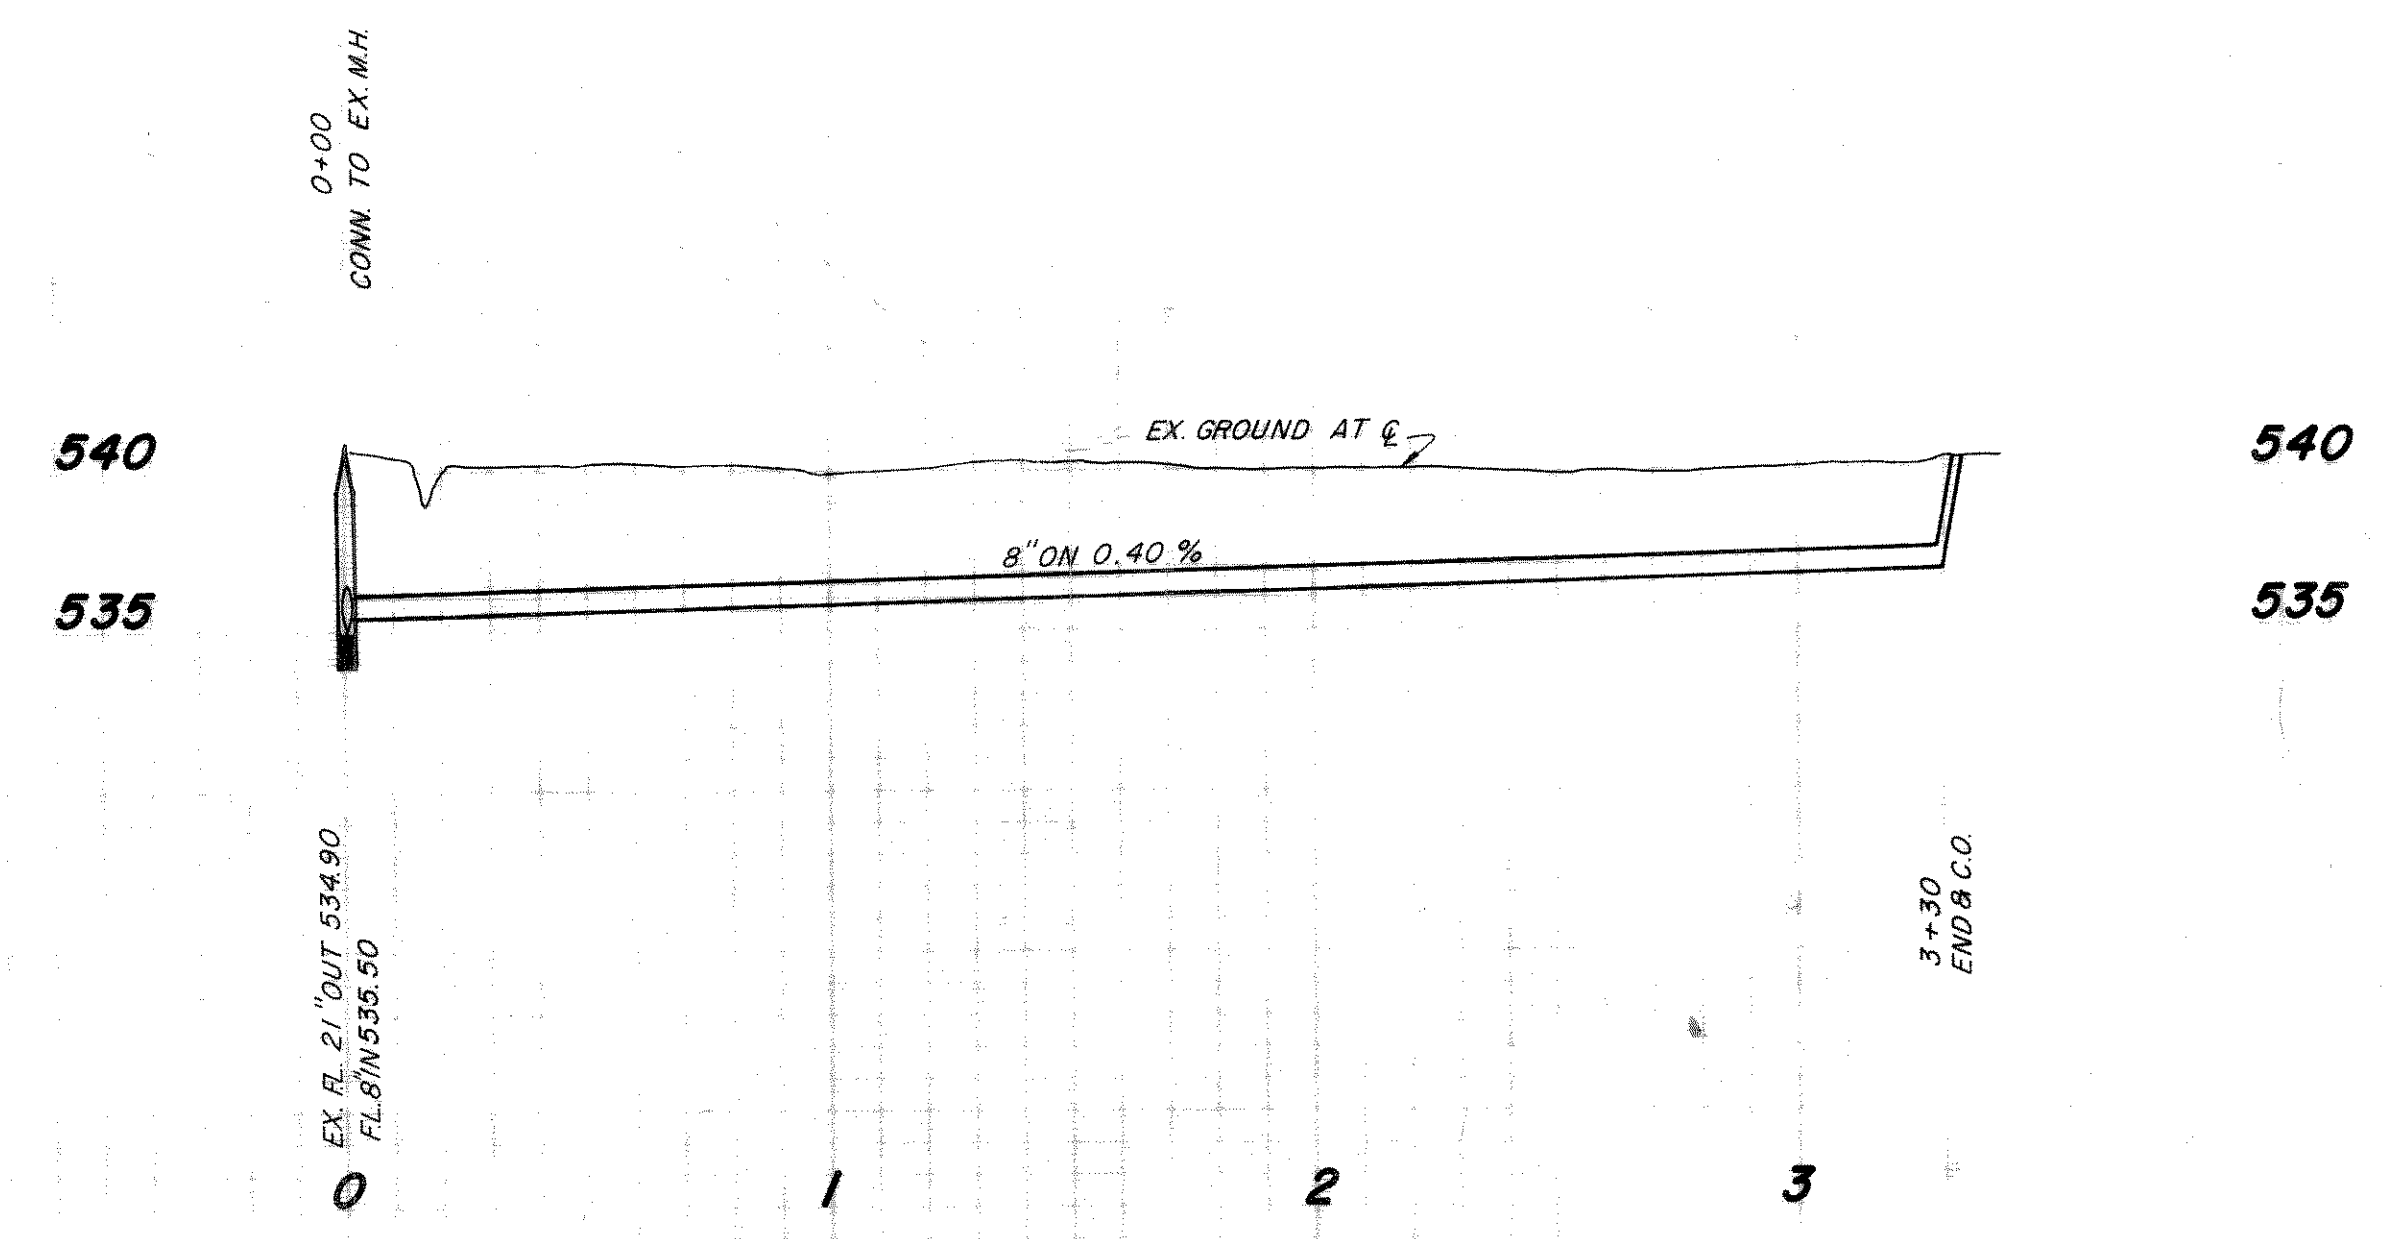

AS BUILT

WATER & SEWER PLAN						
DERRICK ADDITION						
CITY OF ROCKWALL						
HAROLD L. EVANS CONSULTING ENGINEER						
DESIGN	DRAWN	DATE	SCALE	NOTES	FILE	NO.
G.C.W.	M.L.P.	MAY, 1982	1"=40'H 1"=6'V			233