



K:\vdodge\gnt\VENUE\REFNS\SH-01.dwg Plot Date: 17:18:19, 25/2001 STATION=11

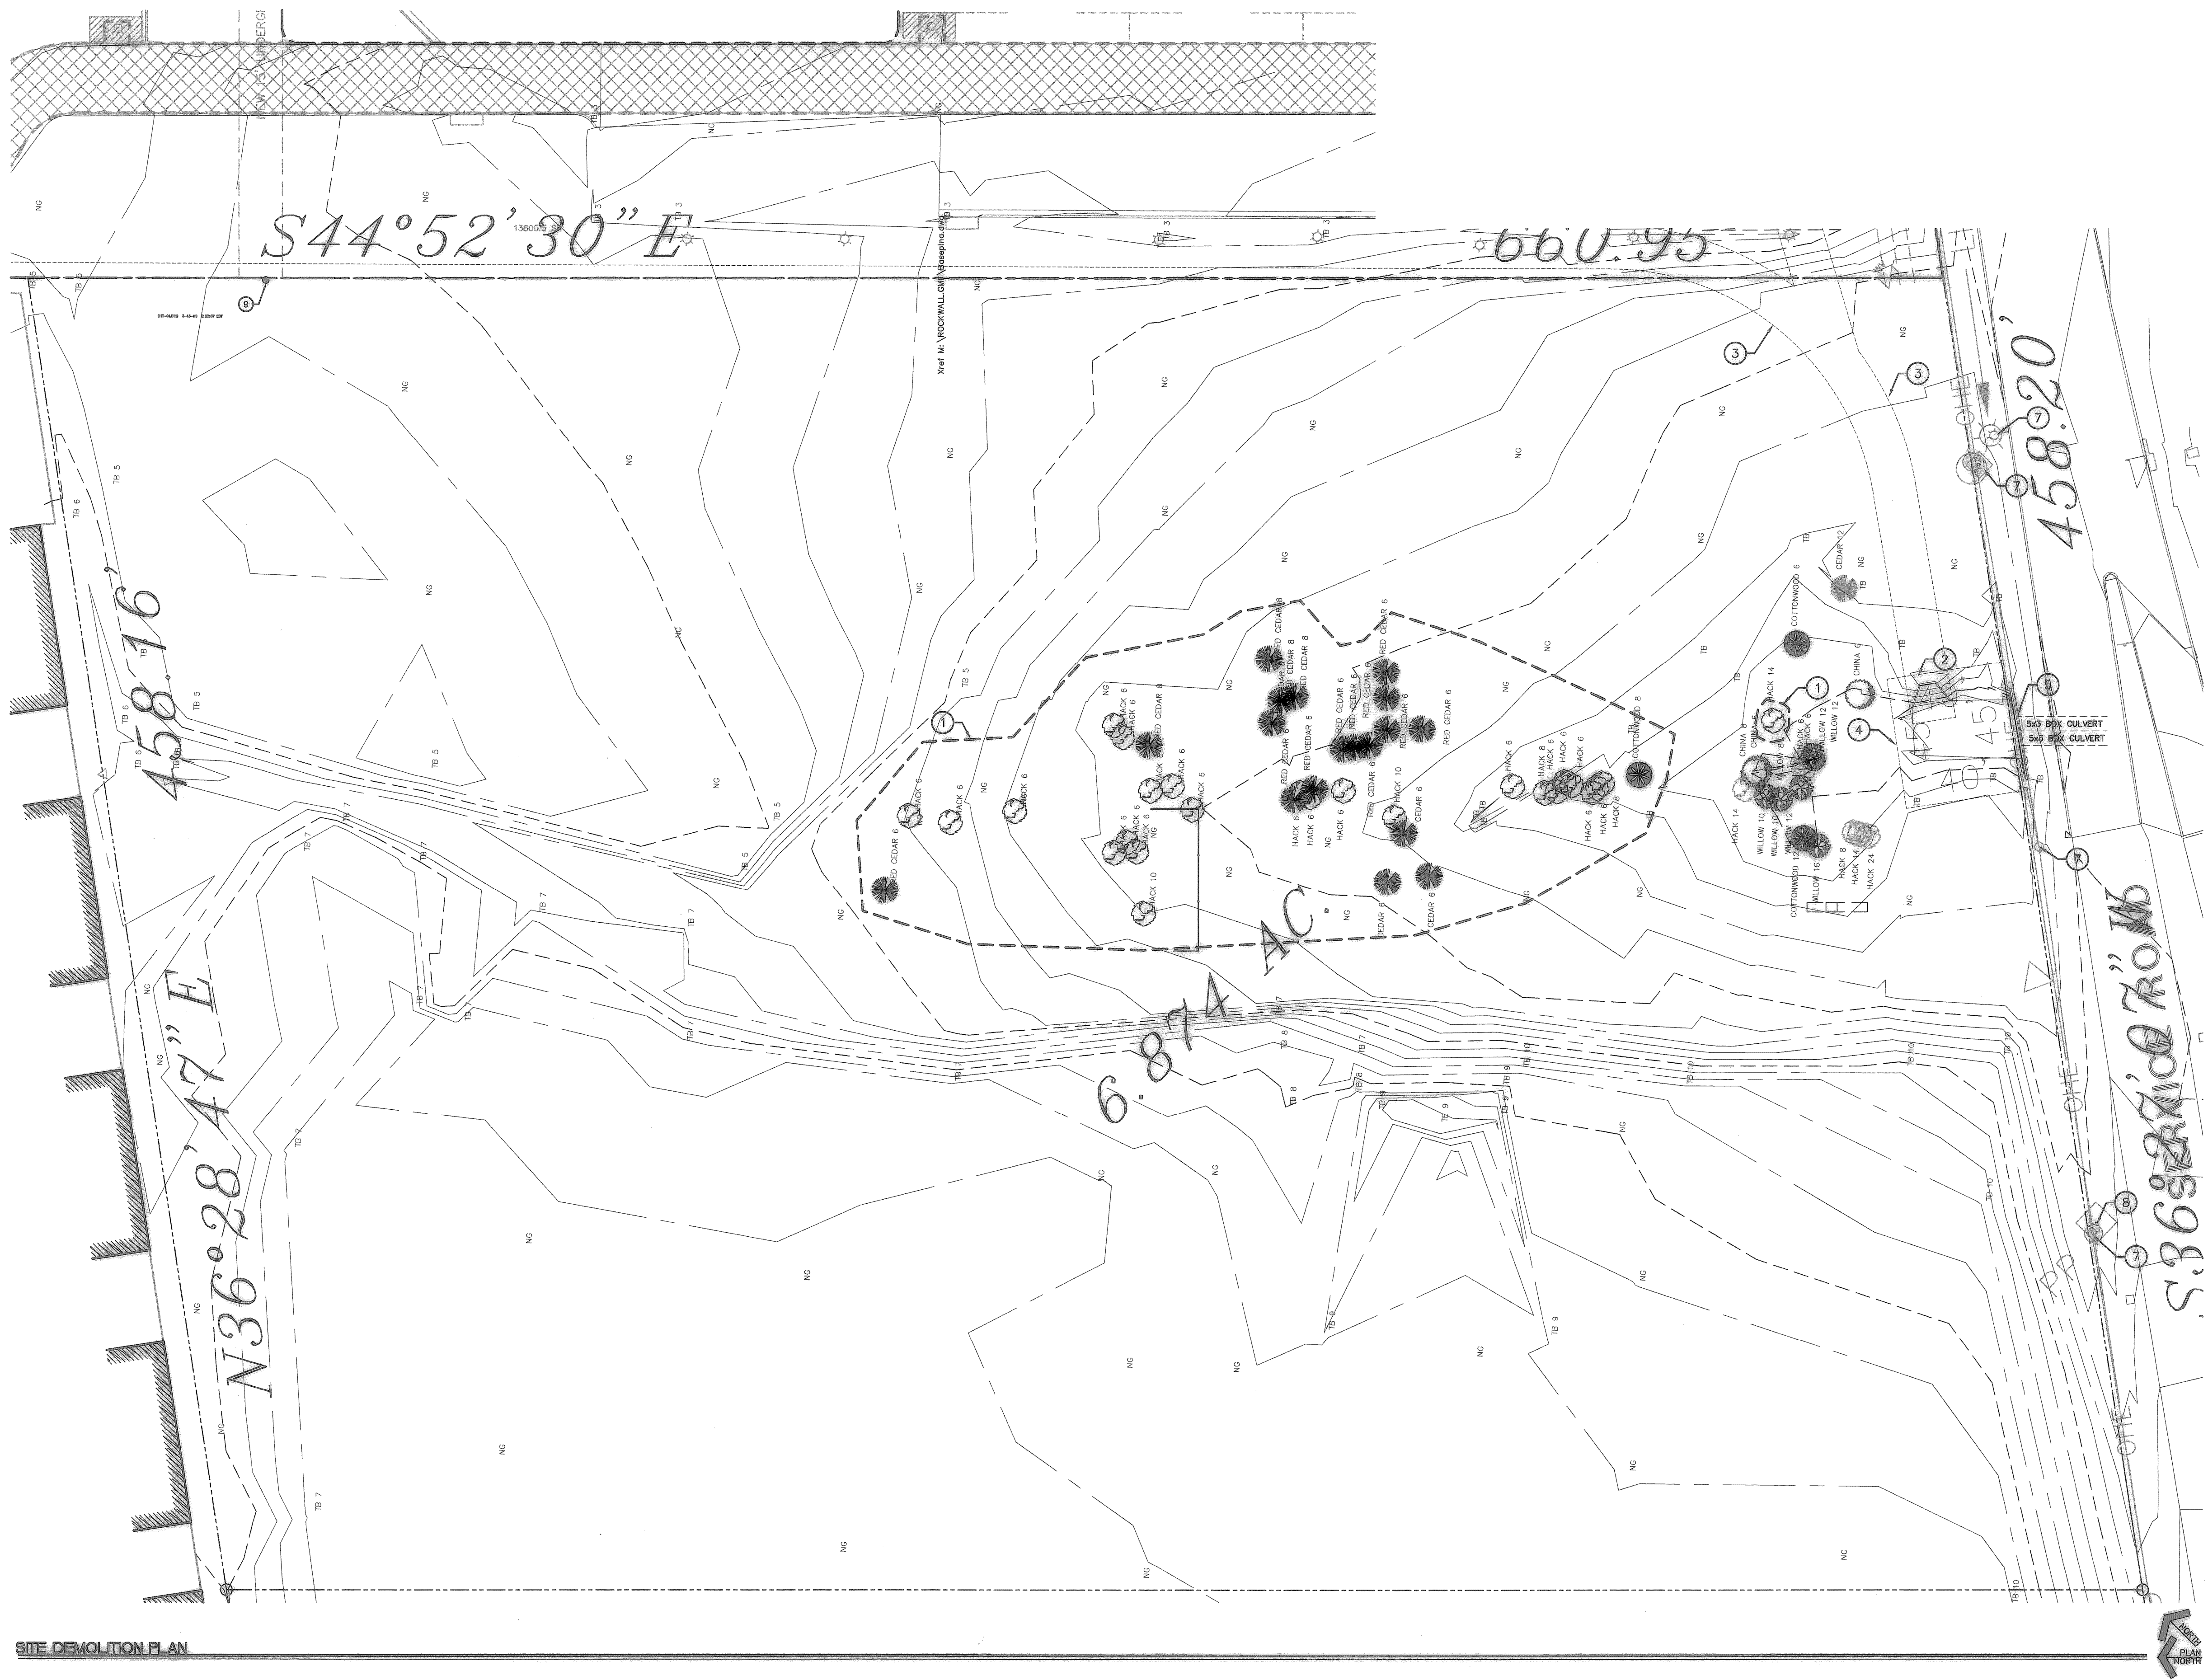

SITE DEMOLITION PLAN

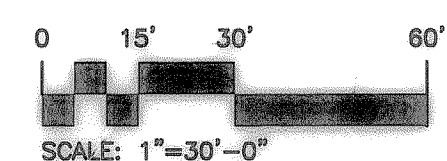

- NOTES:**
KEYED NOTES DESIGNATED BY: ○
1. REMOVE ALL EXISTING TREES THIS AREA.
 2. EXISTING HEADWALL REMAINS.
 3. EXISTING UNDERGROUND UTILITY EASEMENT.
 4. EXISTING TX DOT DRAINAGE BASEMENT.
 5. EXG TX DOT DRAINAGE CULVERT.
 6. NOT USED.
 7. EXG POWER POLE (TXU).
 8. EXG SWBT TELEPHONE PEDESTAL.
 9. EXG MANHOLE.

RECORD DOCUMENTS

PROJECT NO: P99-
DATE: 03/13/00

REVISIONS:
DATE: 11/08/00
RECORD DOCUMENTS: 12/17/01

PROPOSED
DODGE
CAR DEALERSHIP


ROCKWALL, TEXAS

Architectural Resources

2525 74TH ST., SUITE 200
(866) 745-1103

ALLEN ASSOCIATES
CONSULTING ENGINEERS
STRUCTURAL • MECHANICAL • ELECTRICAL

2505 PARK ST. LUBBOCK, TX 79423
(806) 745-1103

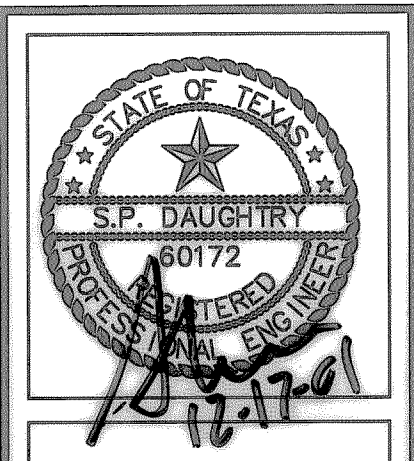

SHEET NO.
1