



ELECTRICAL, GAS AND TELEPHONE UTILITY SITE PLAN

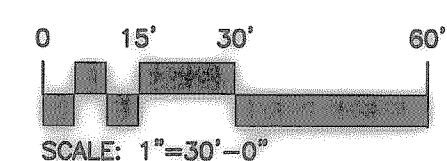

**NOTES:**

KEYED NOTES DESIGNATED BY: ○

1. EXG SWBT TELEPHONE PEDESTAL.
2. EXG (TXU) POWER POLE.
3. NEW (TXU) GAS METER.
4. UNDERGROUND SECONDARY SERVICE BY ELECTRICAL CONTRACTOR.
5. UTILITY SERVICE TERMINATES AT PROPERTY LINE FOR TELEPHONE & NATURAL GAS. SERVICES ON SITE ARE INSTALLED AND MAINTAINED BY PROPERTY OWNER.

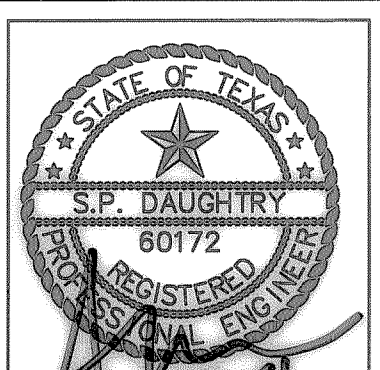

**ALLEN ASSOCIATES**  
CONSULTING ENGINEERS  
ELECTRICAL, MECHANICAL, PLUMBING  
2805 74TH ST., LUBBOCK, TX 79423  
(806) 745-1103

**Architectural Resources**  
2525 74TH ST., SUITE 200  
LUBBOCK, TX 79423  
(806) 745-1103

**PROPOSED DODGE CAR DEALERSHIP**

ROCKWALL, TEXAS

**RECORD DOCUMENTS**

PROJECT NO. F88-
DATE: 03/15/00
REVISIONS:
DATE: 11/08/00
RECORD DOCUMENTS: 12/17/00

SHEET NO.  
**4**

K:\dodge.dwg (ENGINEERING)\SRT-64.dwg Mem Dec. 17 10:20:34 2001 STA:1004-11