

WATER AND WASTE WATER SITE UTILITY PLAN

- NOTES:**
KEYED NOTES DESIGNATED BY: ○
- REFER TO SHEET 10 FOR WATER & WASTE WATER SYSTEM INSTALLATION DETAILS.
 - PROVIDE 6" CONG FILLED STEEL BOLLARDS AROUND FIRE HYDRANT (4).
 - BENCHMARK**
"C" CUT AT TOP OF CURB 15' SOUTHEAST OF EAST CORNER OF ROCKWALL FORD ADDITION VOL 1375 PG 301 ELEV 583.95
 - ALL WATER LINES SHALL BE CLASS 200 PVC. C-900



ALLIED ASSOCIATES CONSULTING ENGINEERS
 ELECTRICAL ENGINEER
 (86) 745-1103
 2525 74TH ST., SUITE 200
 LUBBOCK, TX 79423
 (806) 745-1103


Architectural Resources

PROPOSED DODGE CAR DEALERSHIP

PROJECT NO. F89-
 DATE: 08/18/00
 REVISIONS:
 DATE: 11/08/00
 RECORD DOCUMENTS 12/17/00

SHEET NO.
9

RECORD DOCUMENTS

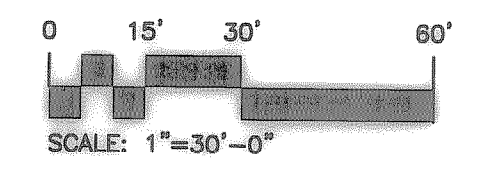

M:\dodge_0811\ENGINEERING\0811-09_dwg_001.dwg Rev Dec 17 10 23 11 2001 STATION=11