


LAKE POINTE BAPTIST CHURCH ADDITION
 Cab. D, Slide 385
 P.R.R.C.T.

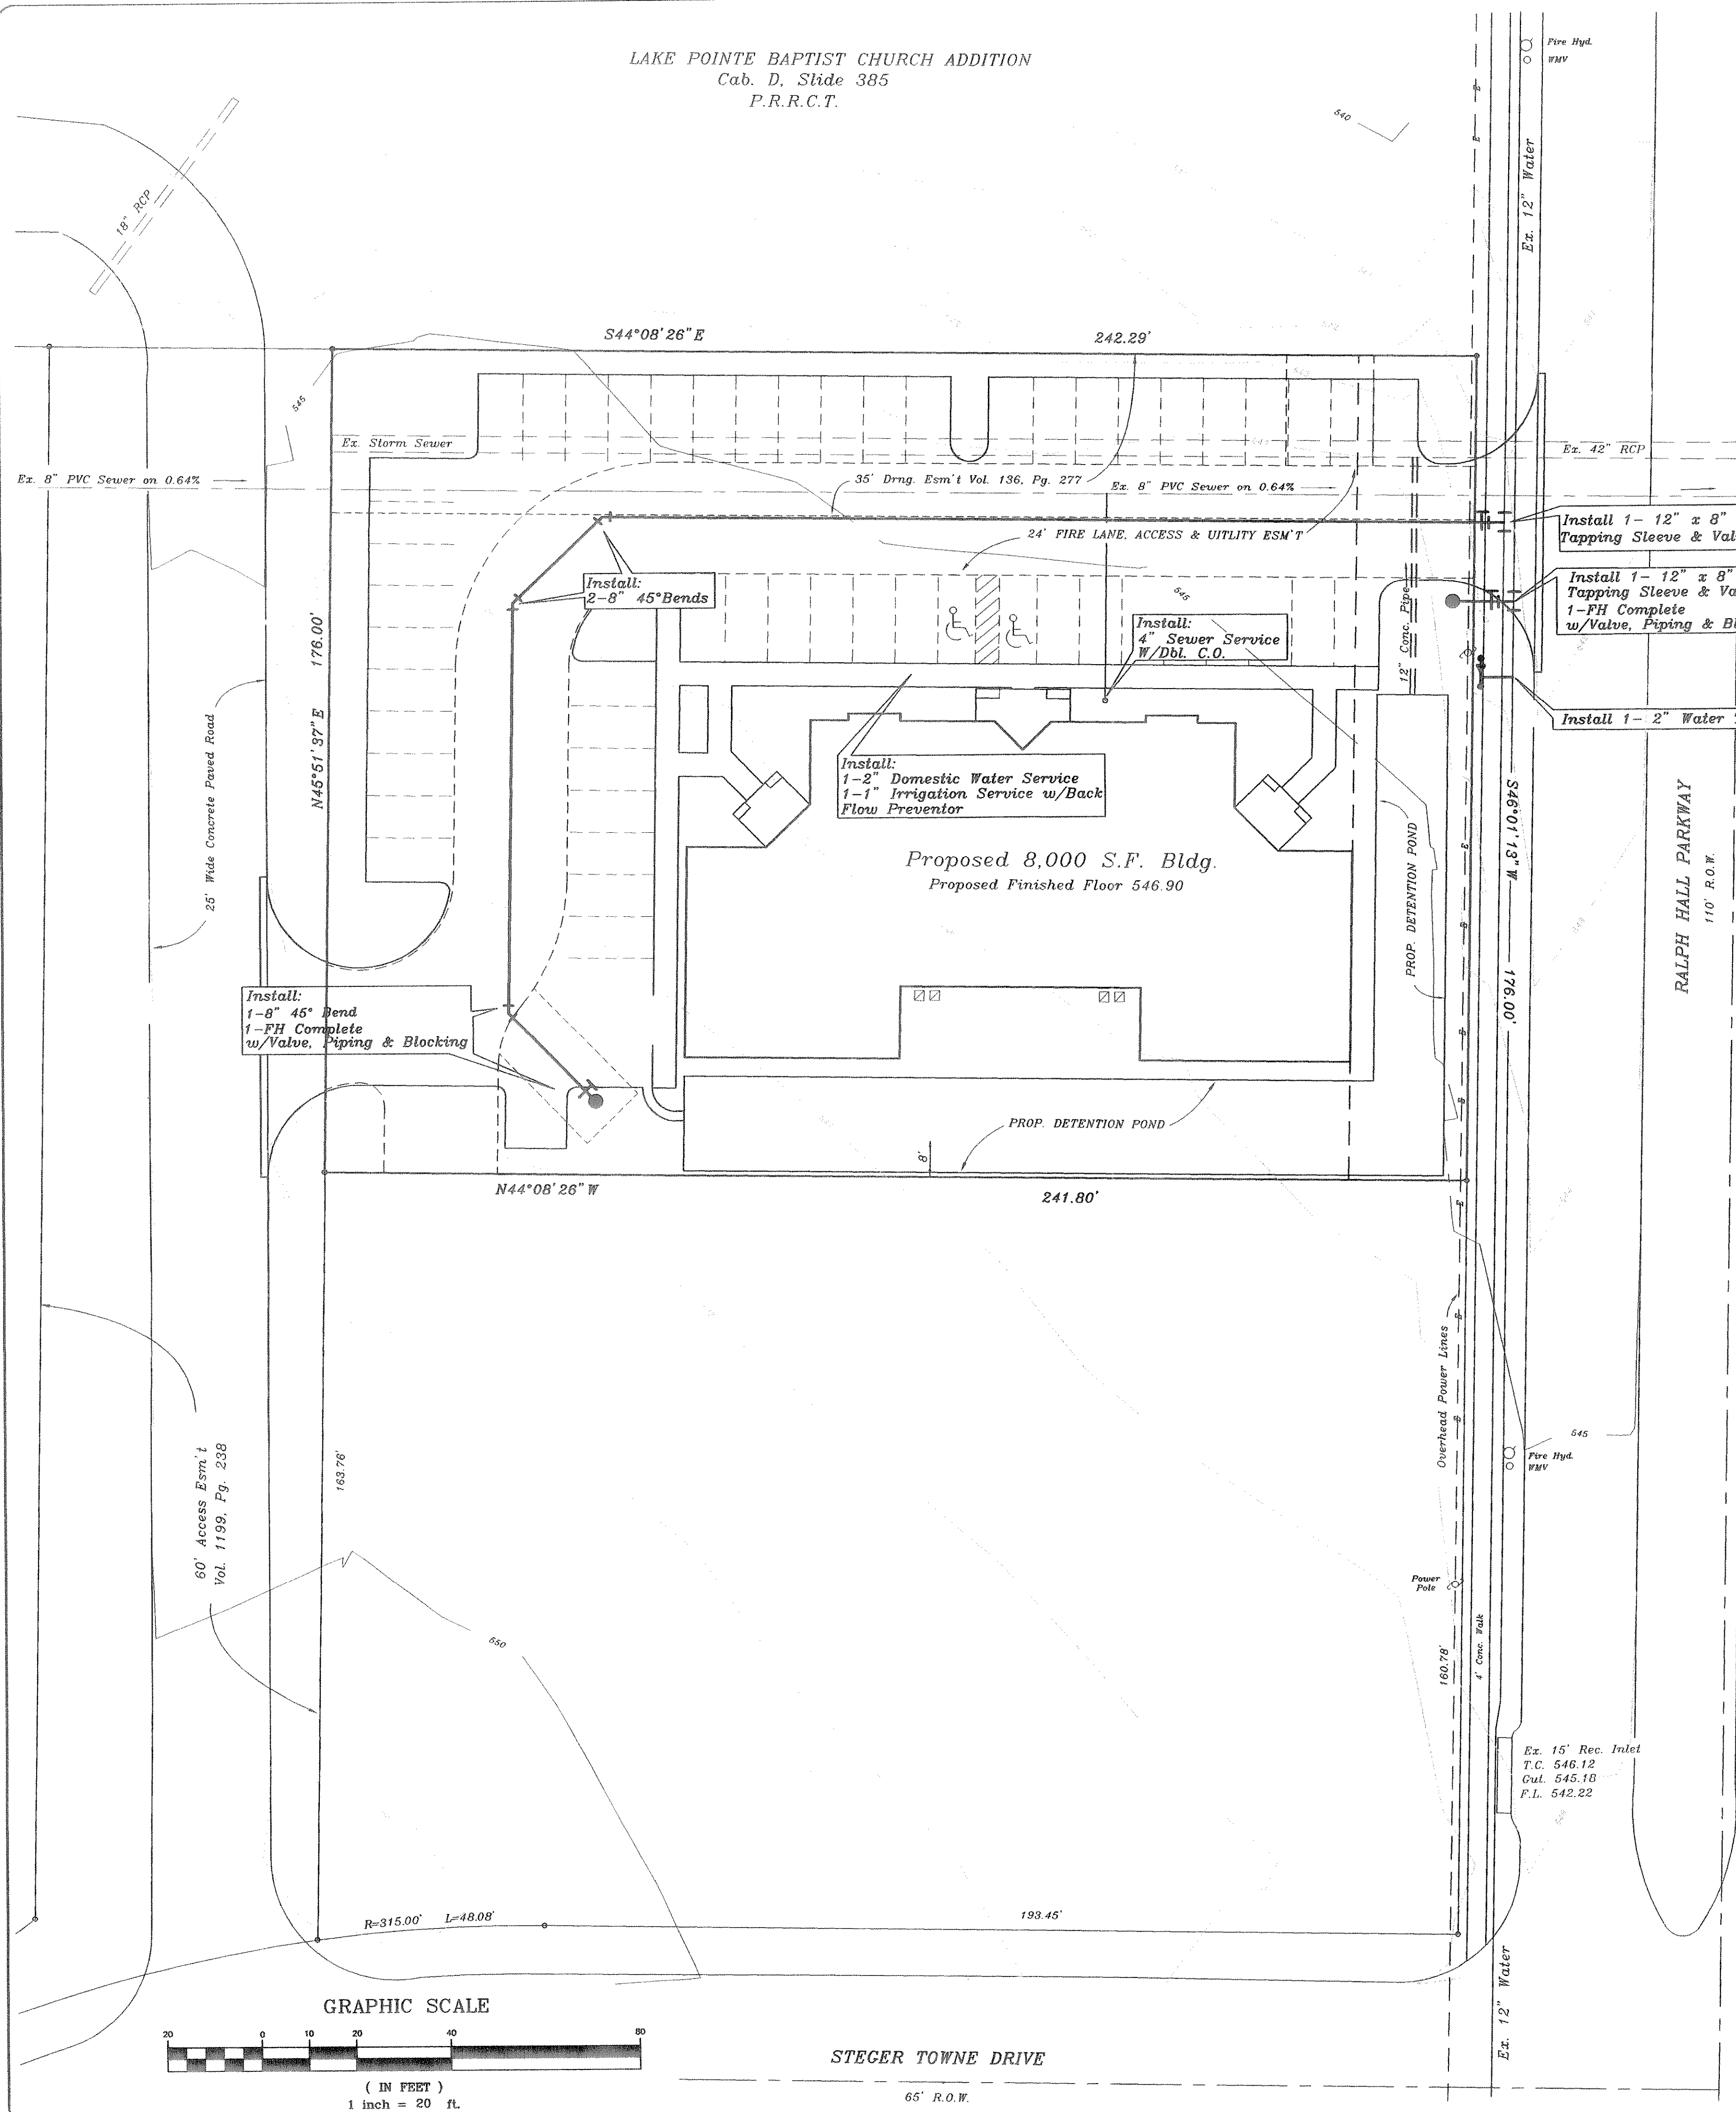

Ex. Sanitary Sewer Man Hole
 Top = 541.14
 F.L. In = 531.54
 F.L. Out = 531.34

WINDMILL RIDGE ESTATES No. 3B
 Cab. C, Slide 224
 P.R.R.C.T.

OVERBROOK COURT

BLOCK M

33

32

26


27

AUTUMN TRIAL

BLOCK M


25

24

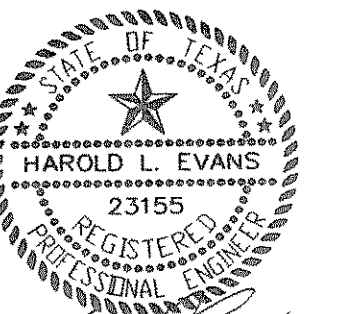

AS BUILT

OWNER:
 MICHAEL BUFFINGTON
 616 LIECHTY COURT
 HEATH, TEXAS 75032
 (972) 772-7907

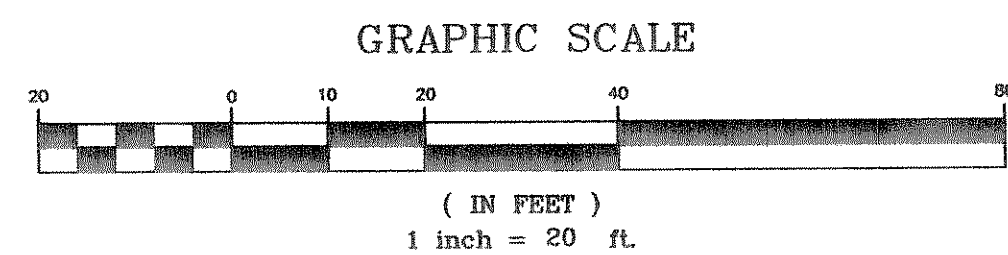

STEGER TOWNE DRIVE
 65' R.O.W.

Revised	12-6-01
Revised	3-6-02
Revised	3-25-02
Revised	3-20-03
Revised	3-24-03

HAROLD L. EVANS
 CONSULTING ENGINEER
 P.O. BOX 28355
 2331 CUS THOMASSON ROAD, SUITE 102
 DALLAS, TEXAS 75228. (214) 328-8133

UTILITY PLAN
 DRAKE I

SHEET NO.

4

6

JOB NO.

01074

REVISION DESCRIPTION	DATE	SCALE	DESIGN	DRAWN
	11-2-01	1" = 20'	H.L.E.	JMA

CITY OF ROCKWALL