
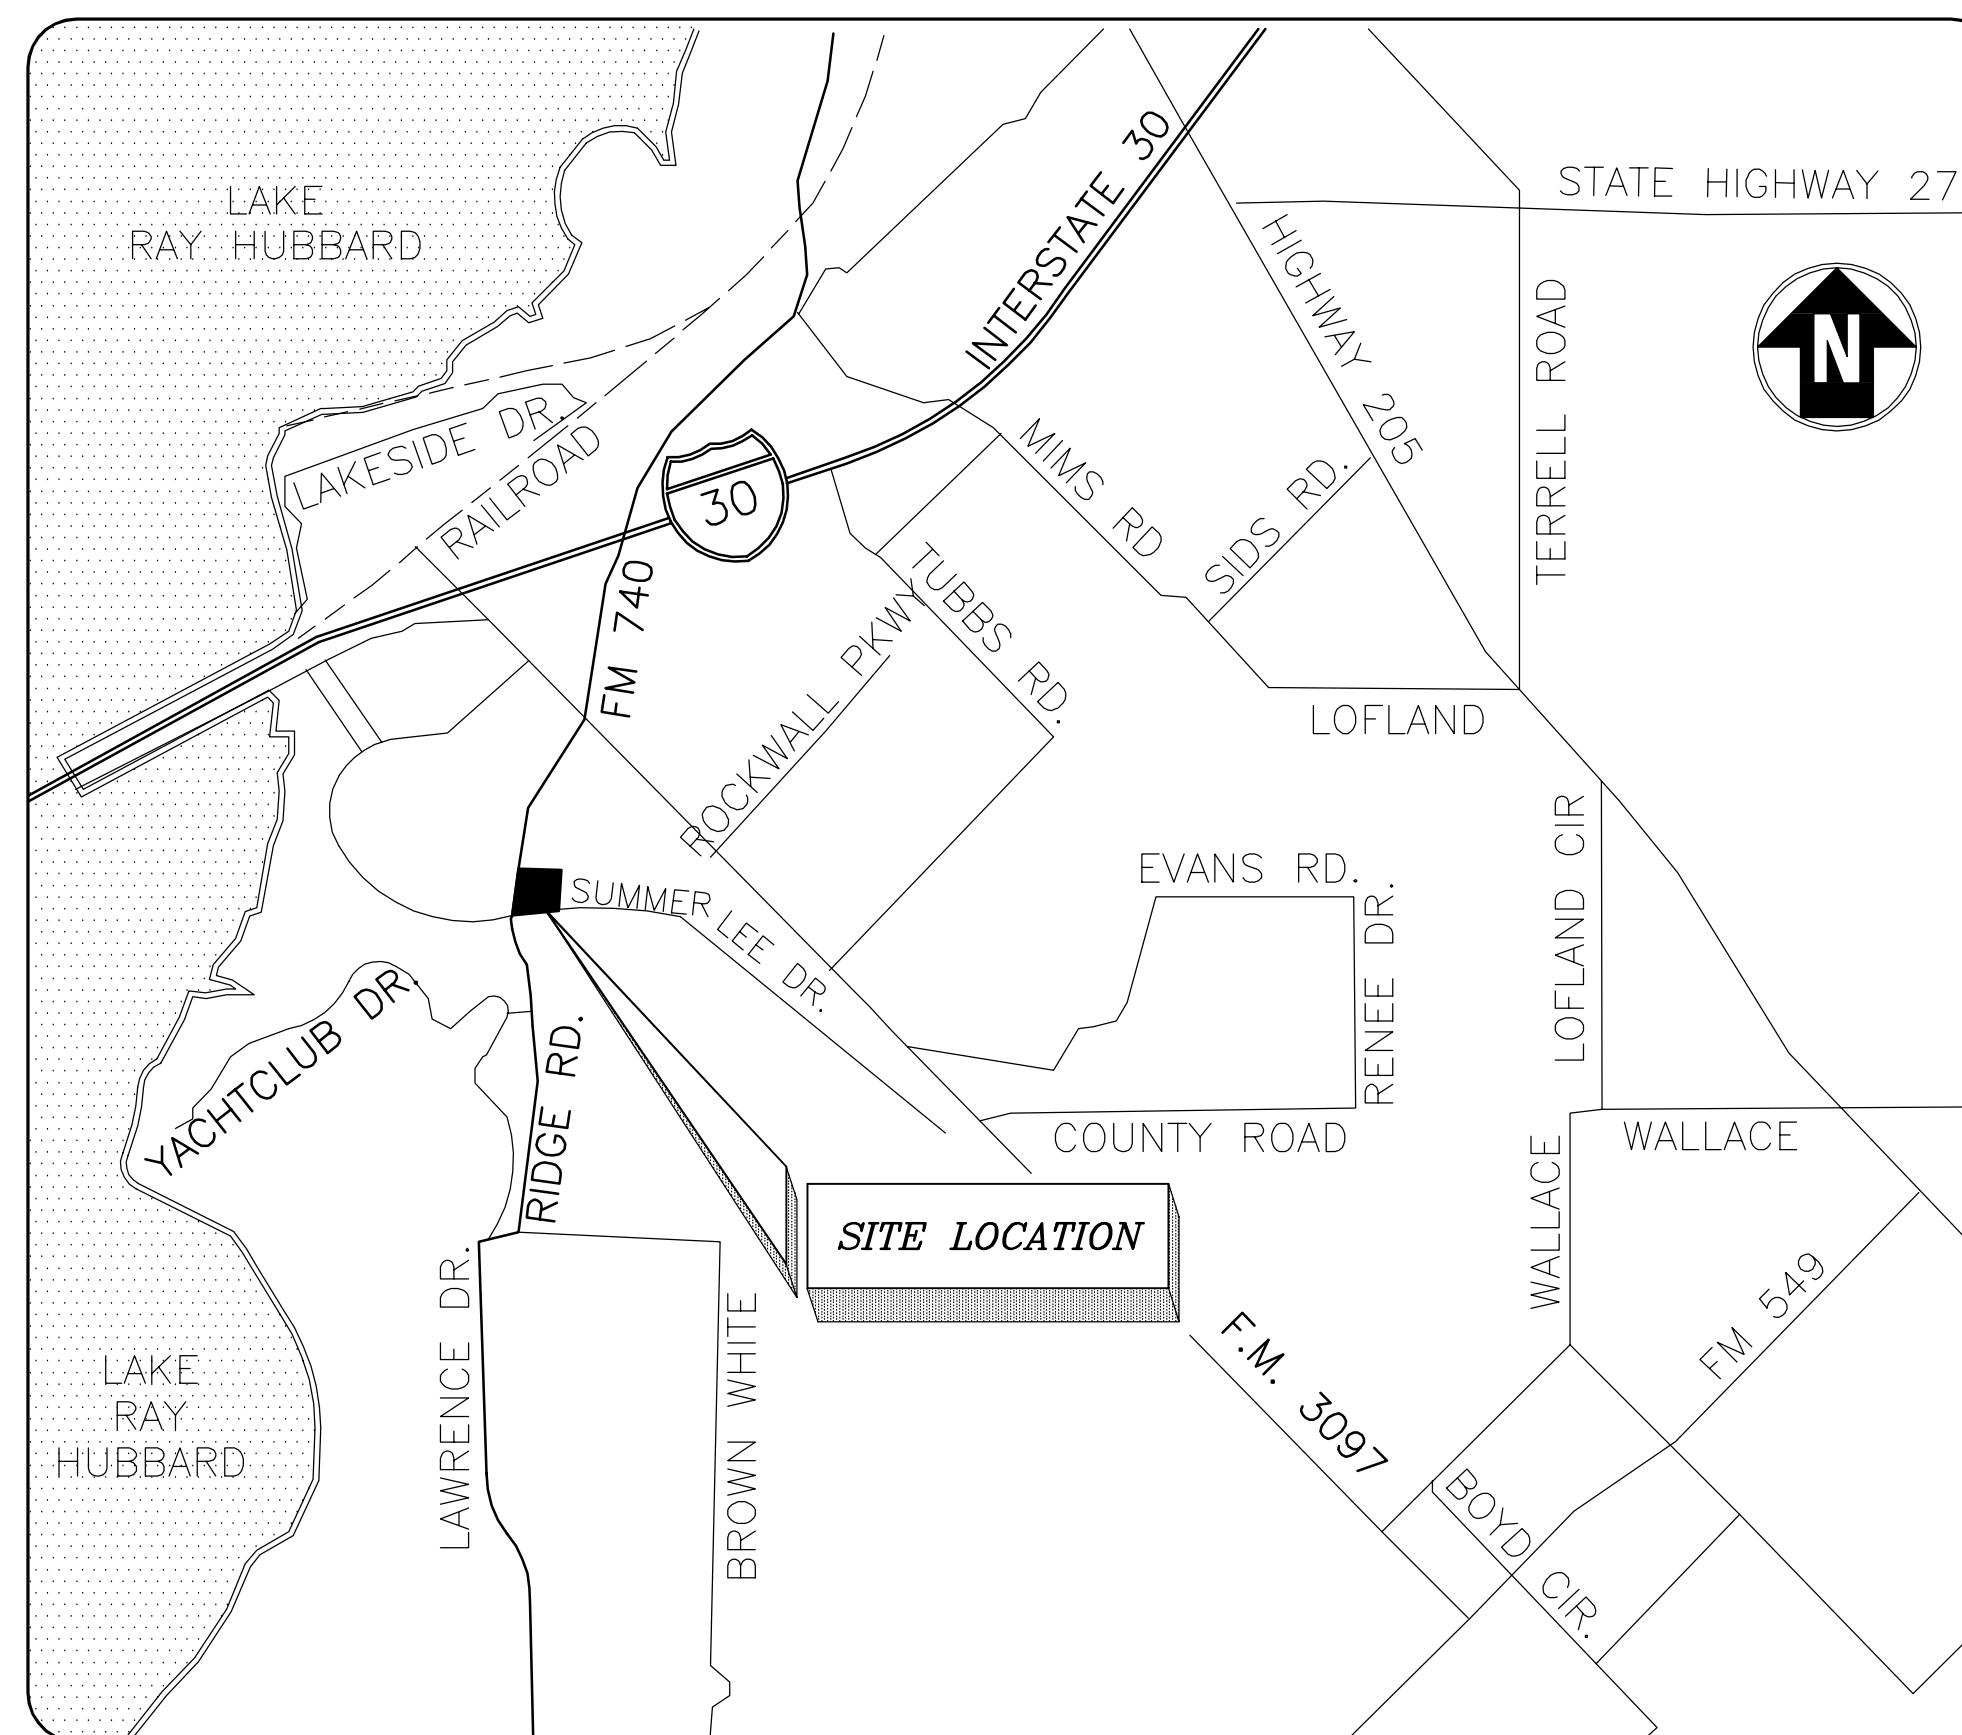


DUNKIN' DONUTS & RETAIL SPACE

RIDGE ROAD & SUMMER LEE DR.

ROCKWALL, TEXAS

NOVEMBER 2013

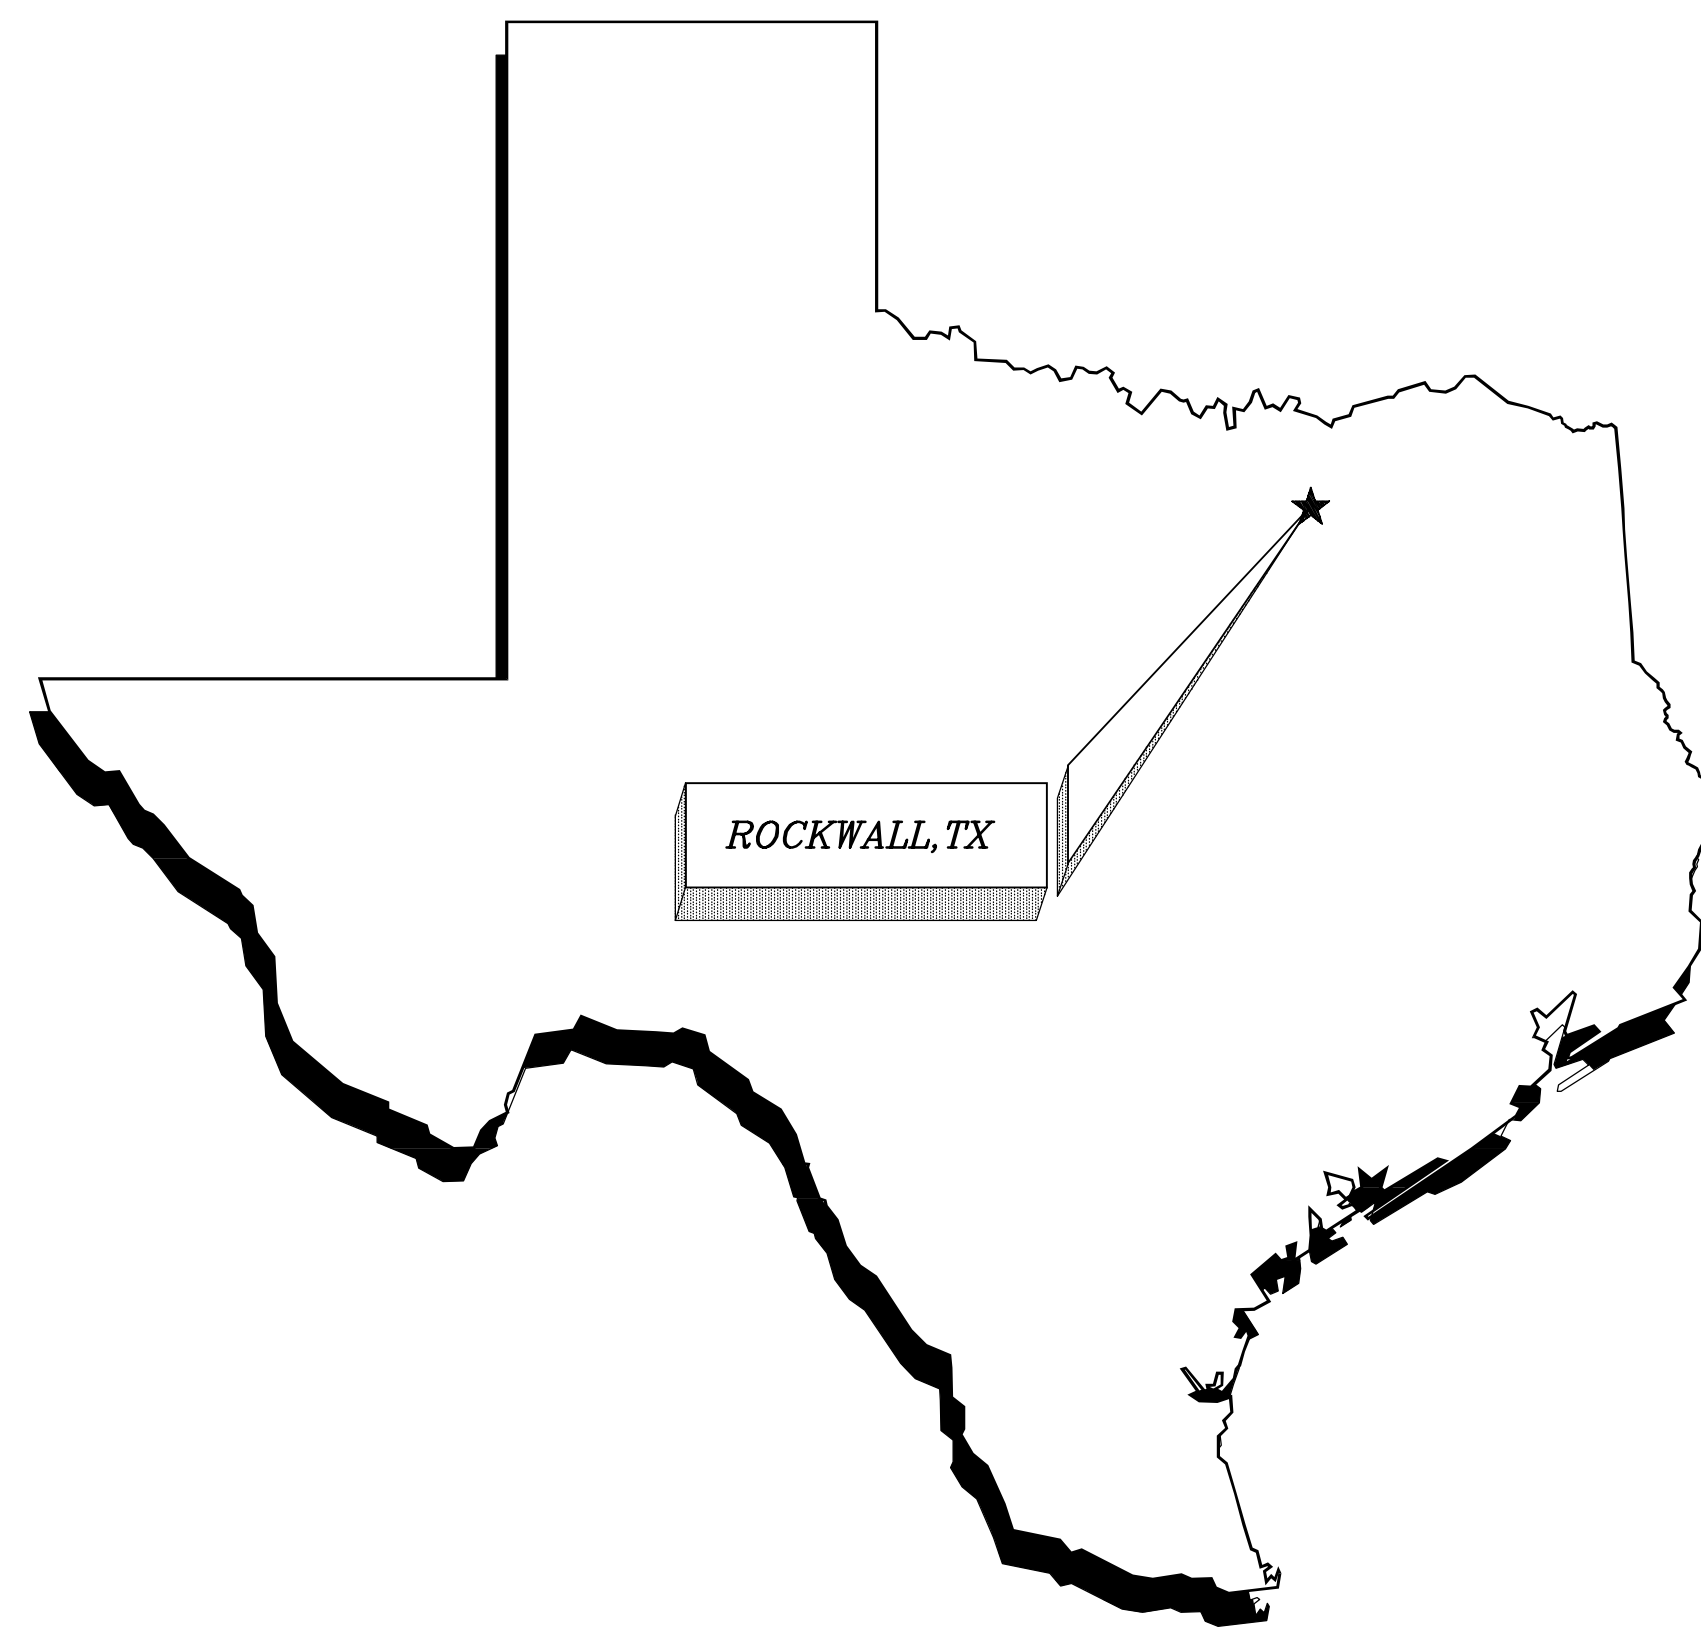

VICINITY MAP

NOT TO SCALE

INDEX TO SHEETS

SHEET NO.	DESCRIPTION
C-100	COVER SHEET
C-101	SITE PLAN
C-102	PAVING PLAN
C-201	GRADING PLAN
C-202	DRAINAGE PLAN
C-203	EROSION & SEDIMENT CONTROL PLAN
C-301	UTILITY PLAN
C-302	STORM & SANITARY PROFILES
C-501	LANDSCAPE PLAN
C-502	LANDSCAPE DETAILS
C-601	CITY OF ROCKWALL DETAILS
C-602	DETAILS
C-603	DETAILS
C-604	DETAILS
S-001	AS-BUILT SURVEY


CONTACT INFORMATION

CIVIL ENGINEER	DEVELOPER
T. CRAIG CARNEY, P.E. CARNEY ENGINEERING CO., PLLC 4588 HINTON DR. PLANO, TEXAS 75024 (469) 443-0861	STACY McVEY DOUBLE EAGLE PROPERTIES 7218 LAKEWOOD DR. DALLAS, TEXAS 75214 (469) 426-7402

RECORD DRAWINGS

AUGUST 27, 2014

TO THE BEST OF OUR KNOWLEDGE, CARNEY ENGINEERING, PLLC, HEREBY, STATES THAT THESE PLANS ARE AS-BUILT. THIS INFORMATION IS BASED ON SURVEYING AT THE SITE AND INFORMATION PROVIDED BY THE CONTRACTOR.

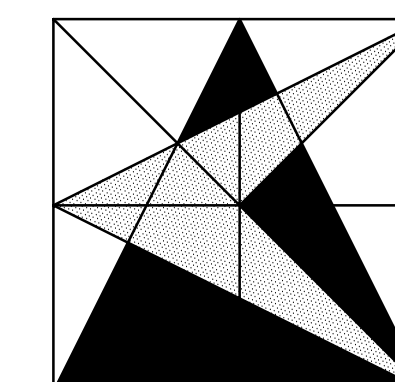

CARNEY
ENGINEERING
COMPANY
4588 HINTON DRIVE
Plano, Texas 75024
PH (469) 443-0861
FAX (469) 443-0863

CIVIL ENGINEERING DRAWINGS