

VICINITY MAP  
NO SCALE

**\*\*CAUTION--NOTICE TO CONTRACTOR\*\***


THE CONTRACTOR IS SPECIFICALLY CAUTIONED THAT THE LOCATION AND/OR ELEVATION OF EXISTING UTILITIES AS SHOWN ON THESE PLANS IS BASED ON RECORDS OF THE VARIOUS UTILITY COMPANIES AND, WHERE POSSIBLE, MEASUREMENTS TAKEN IN THE FIELD. THE INFORMATION IS NOT TO BE RELIED ON AS BEING EXACT OR COMPLETE. THE CONTRACTOR SHALL CONTACT THE APPROPRIATE UTILITY COMPANY TWO WORKING DAYS PRIOR TO ANY EXCAVATION TO REQUEST EXACT FIELD LOCATION OF UTILITIES. IT SHALL BE THE RESPONSIBILITY OF THE CONTRACTOR TO RELOCATE ALL EXISTING UTILITIES WHICH CONFLICT WITH THE PROPOSED IMPROVEMENTS SHOWN ON THE PLANS.

REVISIONS


#1	10/21/13	REVISION PER CITY COMMENTS
#2	10/29/13	AM. REVISIONS PER CITY COMMENTS
#3	10/29/13	PM. REVISIONS PER CITY COMMENTS
#4	11/15/13	CHANGE IN PIPE MATERIAL
#5	01/10/14	REVISION TO DETENTION SYSTEM
#6	08/27/14	RECORD AS-BUILT DRAWINGS

DUNKIN' DONUTS & RETAIL SPACE  
RIDGE ROAD & SUMMER LEE DR.  
ROCKWALL, TEXAS

DRAINAGE PLAN

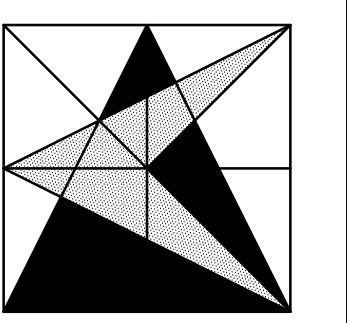


**CARNEY ENGINEERING COMPANY**  
4608 Hinton Dr.  
Ft. Worth, Texas 76104  
PH (469) 443-0861  
FAX (469) 443-0863

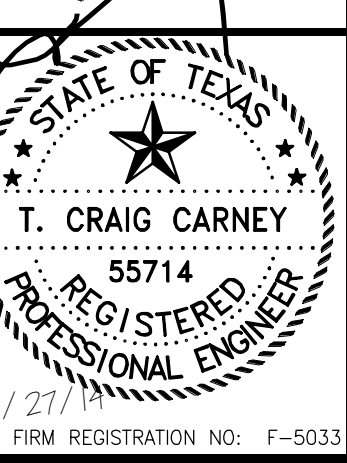

08/27/14  
T.E.P.E. FIRM REGISTRATION NO. F-5033  
DRAWN BY: GWM  
CHECKED BY: T.C.C.  
START DATE: MAY 2013  
SCALE: AS SHOWN  
PROJECT NO.: 24437-1015

SHEET  
**C-202**

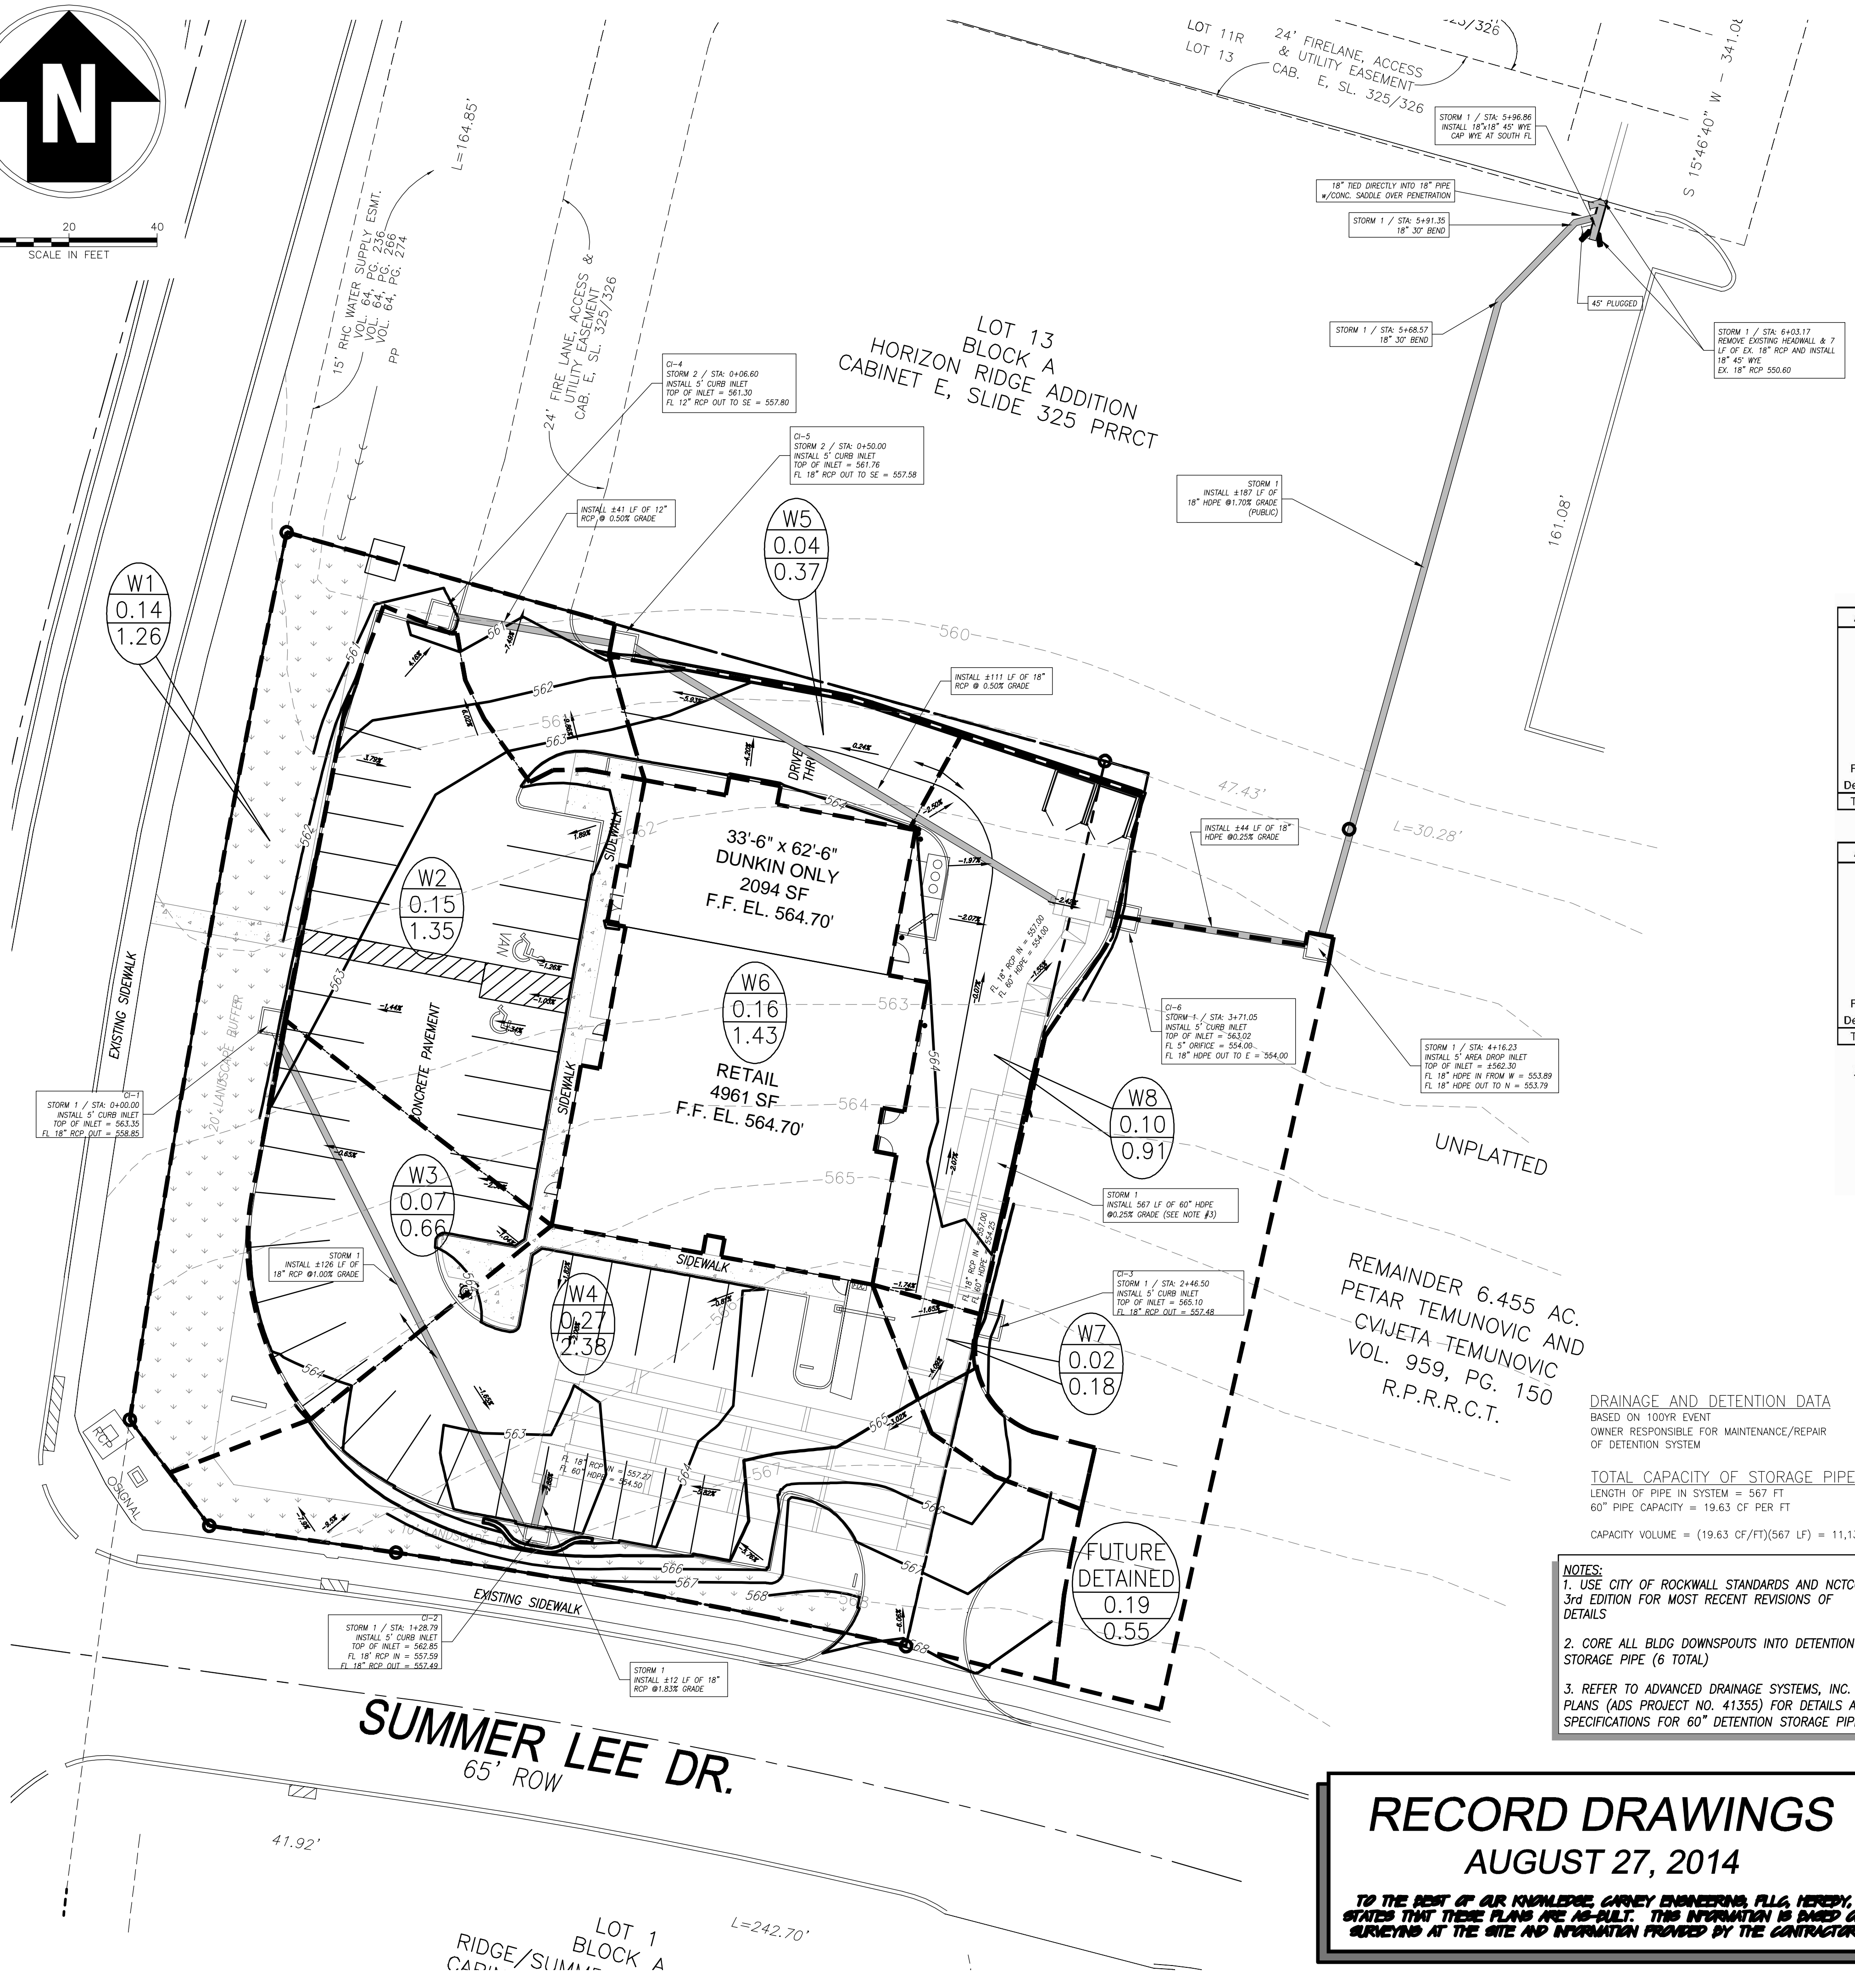

PRE-DEVELOPMENT DRAINAGE CALCULATIONS

AREA	ACRES	COEFF*	Tc	I <sub>5</sub>	Q <sub>5</sub>	I <sub>10</sub>	Q <sub>10</sub>	I <sub>15</sub>	Q <sub>15</sub>	I <sub>100</sub>	Q <sub>100</sub>
W1	0.14	0.35	20	4.9	0.25	5.9	0.30	6.6	0.33	8.3	0.42
W2	0.15	0.35	20	4.9	0.26	5.9	0.32	6.6	0.35	8.3	0.44
W3	0.07	0.35	20	4.9	0.13	5.9	0.15	6.6	0.17	8.3	0.22
W4	0.27	0.35	20	4.9	0.46	5.9	0.56	6.6	0.62	8.3	0.78
W5	0.04	0.35	20	4.9	0.07	5.9	0.09	6.6	0.10	8.3	0.12
W6	0.16	0.35	20	4.9	0.28	5.9	0.33	6.6	0.37	8.3	0.47
W7	0.02	0.35	20	4.9	0.03	5.9	0.04	6.6	0.05	8.3	0.06
W8	0.10	0.35	20	4.9	0.18	5.9	0.21	6.6	0.24	8.3	0.30
Future Detained	0.19	0.35	20	4.9	0.33	5.9	0.39	6.6	0.44	8.3	0.55
TOTAL	0.97	0.35	20	4.9	1.66	5.9	2.00	6.6	2.24	8.3	2.81

POST-DEVELOPMENT DRAINAGE CALCULATIONS

AREA	DRAINS TO	ACRES	COEFF*	Tc	I <sub>5</sub>	Q <sub>5</sub>	I <sub>10</sub>	Q <sub>10</sub>	I <sub>15</sub>	Q <sub>15</sub>	I <sub>100</sub>	Q <sub>100</sub>
W1	OFFSITE	0.14	0.90	10	6.1	0.79	7.1	0.91	8.3	1.07	9.8	1.26
W2	CI-4	0.15	0.90	10	6.1	0.84	7.1	0.98	8.3	1.14	9.8	1.35
W3	CI-1	0.07	0.90	10	6.1	0.41	7.1	0.48	8.3	0.56	9.8	0.66
W4	CI-2	0.27	0.90	10	6.1	1.48	7.1	1.73	8.3	2.02	9.8	2.38
W5	CI-5	0.04	0.90	10	6.1	0.23	7.1	0.27	8.3	0.31	9.8	0.37
W6	DET. BOX	0.16	0.90	10	6.1	0.89	7.1	1.03	8.3	1.21	9.8	1.43
W7	CI-3	0.02	0.90	10	6.1	0.11	7.1	0.13	8.3	0.15	9.8	0.18
W8	CI-6	0.10	0.90	10	6.1	0.57	7.1	0.66	8.3	0.77	9.8	0.91
Future Detained	Area Inlet	0.19	0.35	20	4.9	0.33	5.9	0.39	6.6	0.44	8.3	0.55
TOTAL	--	0.97	0.90	10	6.1	5.31	7.1	6.18	8.3	7.23	9.8	8.54

Present Conditions				Future Conditions			
Q = CIA	By-Pass Acreage = 0.14	New Acreage = 0.82	Q = CIA				Q = CIA
A = 0.97			A = 0.97				A = 0.97
C = 0.35			C = 0.90				C = 0.90
Tc = 20	By-Pass Q cfs	Q <sub>5</sub> Q <sub>10</sub> Q <sub>15</sub> Q <sub>100</sub>	Tc = 10				Tc = 10
I <sub>100</sub> = 8.3	New Allowable cfs	0.87 1.08 1.17 1.55	I <sub>100</sub> = 9.8				I <sub>100</sub> = 9.8
Q <sub>100</sub> = 2.81	Actual cfs	0.57 0.66 0.77 0.91	Q <sub>100</sub> = 8.54				Q <sub>100</sub> = 8.54

POST-DEVELOPMENT FLOWS FOR STORM DURATIONS

Time	C	A	I <sub>5</sub>	Q <sub>5</sub>	I <sub>10</sub>	Q <sub>10</sub>	I <sub>15</sub>	Q <sub>15</sub>	I <sub>100</sub>	Q <sub>100</sub>
10 min	0.9	0.82	6.1	4.53	7.1	5.27	8.3	6.16	9.8	7.27
15 min	0.9	0.82	5.5	4.08	6.5	4.82	7.5	5.57	9.0	6.68
20 min	0.9	0.82	4.9	3.64	5.9	4.38	6.6	4.90	8.3	6.16
30 min	0.9	0.82	4.1	3.04	4.8	3.56	5.5	4.08	6.9	5.12
40 min	0.9	0.82	3.4	2.52	4.0	2.97	4.6	3.41	5.8	4.31
50 min	0.9	0.82	2.8	2.08	3.5	2.60	4.0	2.97	5.0	3.71
60 min	0.9	0.82	2.6	1.93	3.0	2.23	3.5	2.60	4.5	3.34
70 min	0.9	0.82	2.4	1.78	2.8	2.08	3.3	2.45	4.0	2.97
80 min	0.9	0.82	2.3	1.71	2.6	1.93	3.1	2.30	3.7	2.75
90 min	0.9	0.82	2.1	1.56	2.5	1.86	2.9	2.15	3.5	2.60
100 min	0.9	0.82	1.9	1.41	2.4	1.78	2.7	2.00	3.3	2.45
110 min	0.9	0.82	1.8	1.34	2.3	1.71	2.5	1.86	2.9	2.15

Storage Calculations

Time	Inflow	Storage	Outflow
10 min	4,364.49	3,435.05	929.44
15 min	6,012.31	4,850.51	1,161.80
20 min	7,392.91	5,998.75	1,394.16
30 min	9,218.87	7,359.99	1,858.88
40 min	10,332.25	8,008.66	2,323.60
50 min	11,133.90	8,345.58	2,788.32
60 min	12,024.62	8,771.58	3,253.04
70 min	12,469.97	8,752.21	3,717.76
80 min	13,182.54	9,000.06	4,182.48
90 min	14,028.72	9,381.52	4,647.20
100 min	14,696.75	9,584.83	5,111.92
110 min	14,206.86	8,630.22	5,576.64

**LEGEND**

- 568 --- EXISTING CONTOURS
- 566 --- PROPOSED FINISH CONTOURS
- - - - - WATERSHED BOUNDARY
- (A) WATERSHED AREA
- (0.23) DRAINAGE AREA IN ACRES
- (0.5) RUN-OFF IN cfs
- XXXXX DIRECTION OF SURFACE FLOW
- /// CROSSWALK
- LANDSCAPE BUFFER
- - - - - PROPERTY BOUNDARY
- - - - - PROPOSED UTILITY EASEMENT

**RECORD DRAWINGS**  
AUGUST 27, 2014

TO THE BEST OF OUR KNOWLEDGE, CARNEY ENGINEERING, PLLC, HEREBY STATES THAT THESE PLANS ARE AS-BUILT. THIS INFORMATION IS BASED ON SURVEYS AT THE SITE AND INFORMATION PROVIDED BY THE CONTRACTOR.

File: V:\PROJECTS\ANY\K3\24437\1015\CADD\ACAD\24437\1015\_C-202.DWG Saved: 8/29/2014 8:20:33 AM Plotted: 8/29/2014 9:00:02 AM User: Kane, Peter LaidSaveBy: 3276