


# DEVELOPMENT PLANS

# EAGLE POINT ESTATES

## CITY OF ROCKWALL, TEXAS

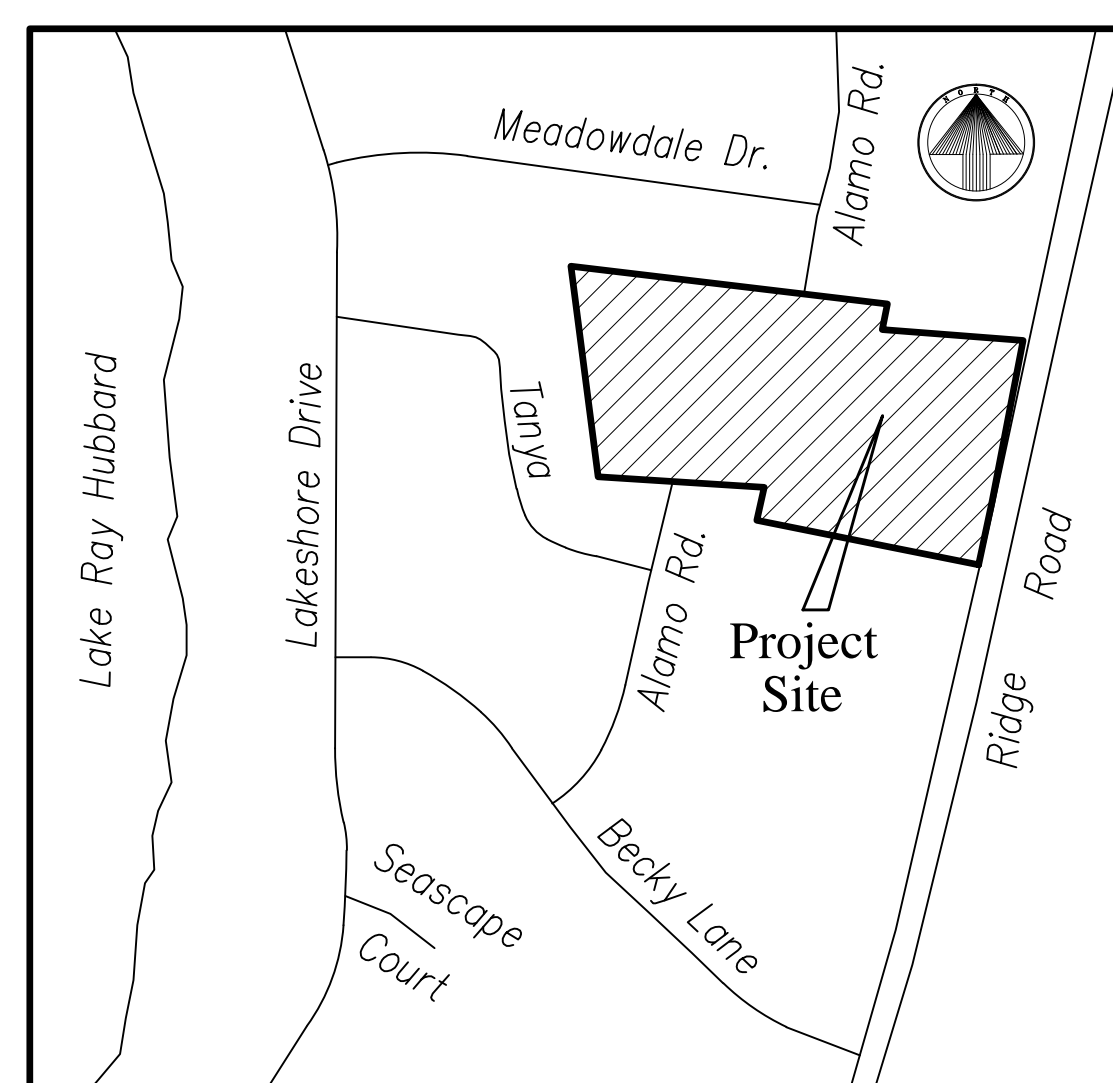

LOCATION MAP

### INDEX of SHEETS

<u>Sheet No.</u>	<u>Title</u>
1	Cover Sheet
2-3	Final Plat
4	Paving Plan
5	Water and Sanitary Sewer Plan
6	Sanitary Sewer Profiles
7	Drainage Area Map
8	Storm Sewer Plan
9-10	Storm Sewer Profiles
11	Grading Plan
12	Erosion Control Plan

Applicant ~ Developer  
 DAN BOBST  
 5133 F.M. 549  
 Rockwall, Texas 75032  
 (214) 533-5505

AS-BUILT  
 January 16, 2014



~ Engineer ~  
**F.C. CUNY CORPORATION**

#2 Horizon Court • Heath, Texas 75032 • (469) 402-7700  
 Texas Registered Engineering Firm F-7449