

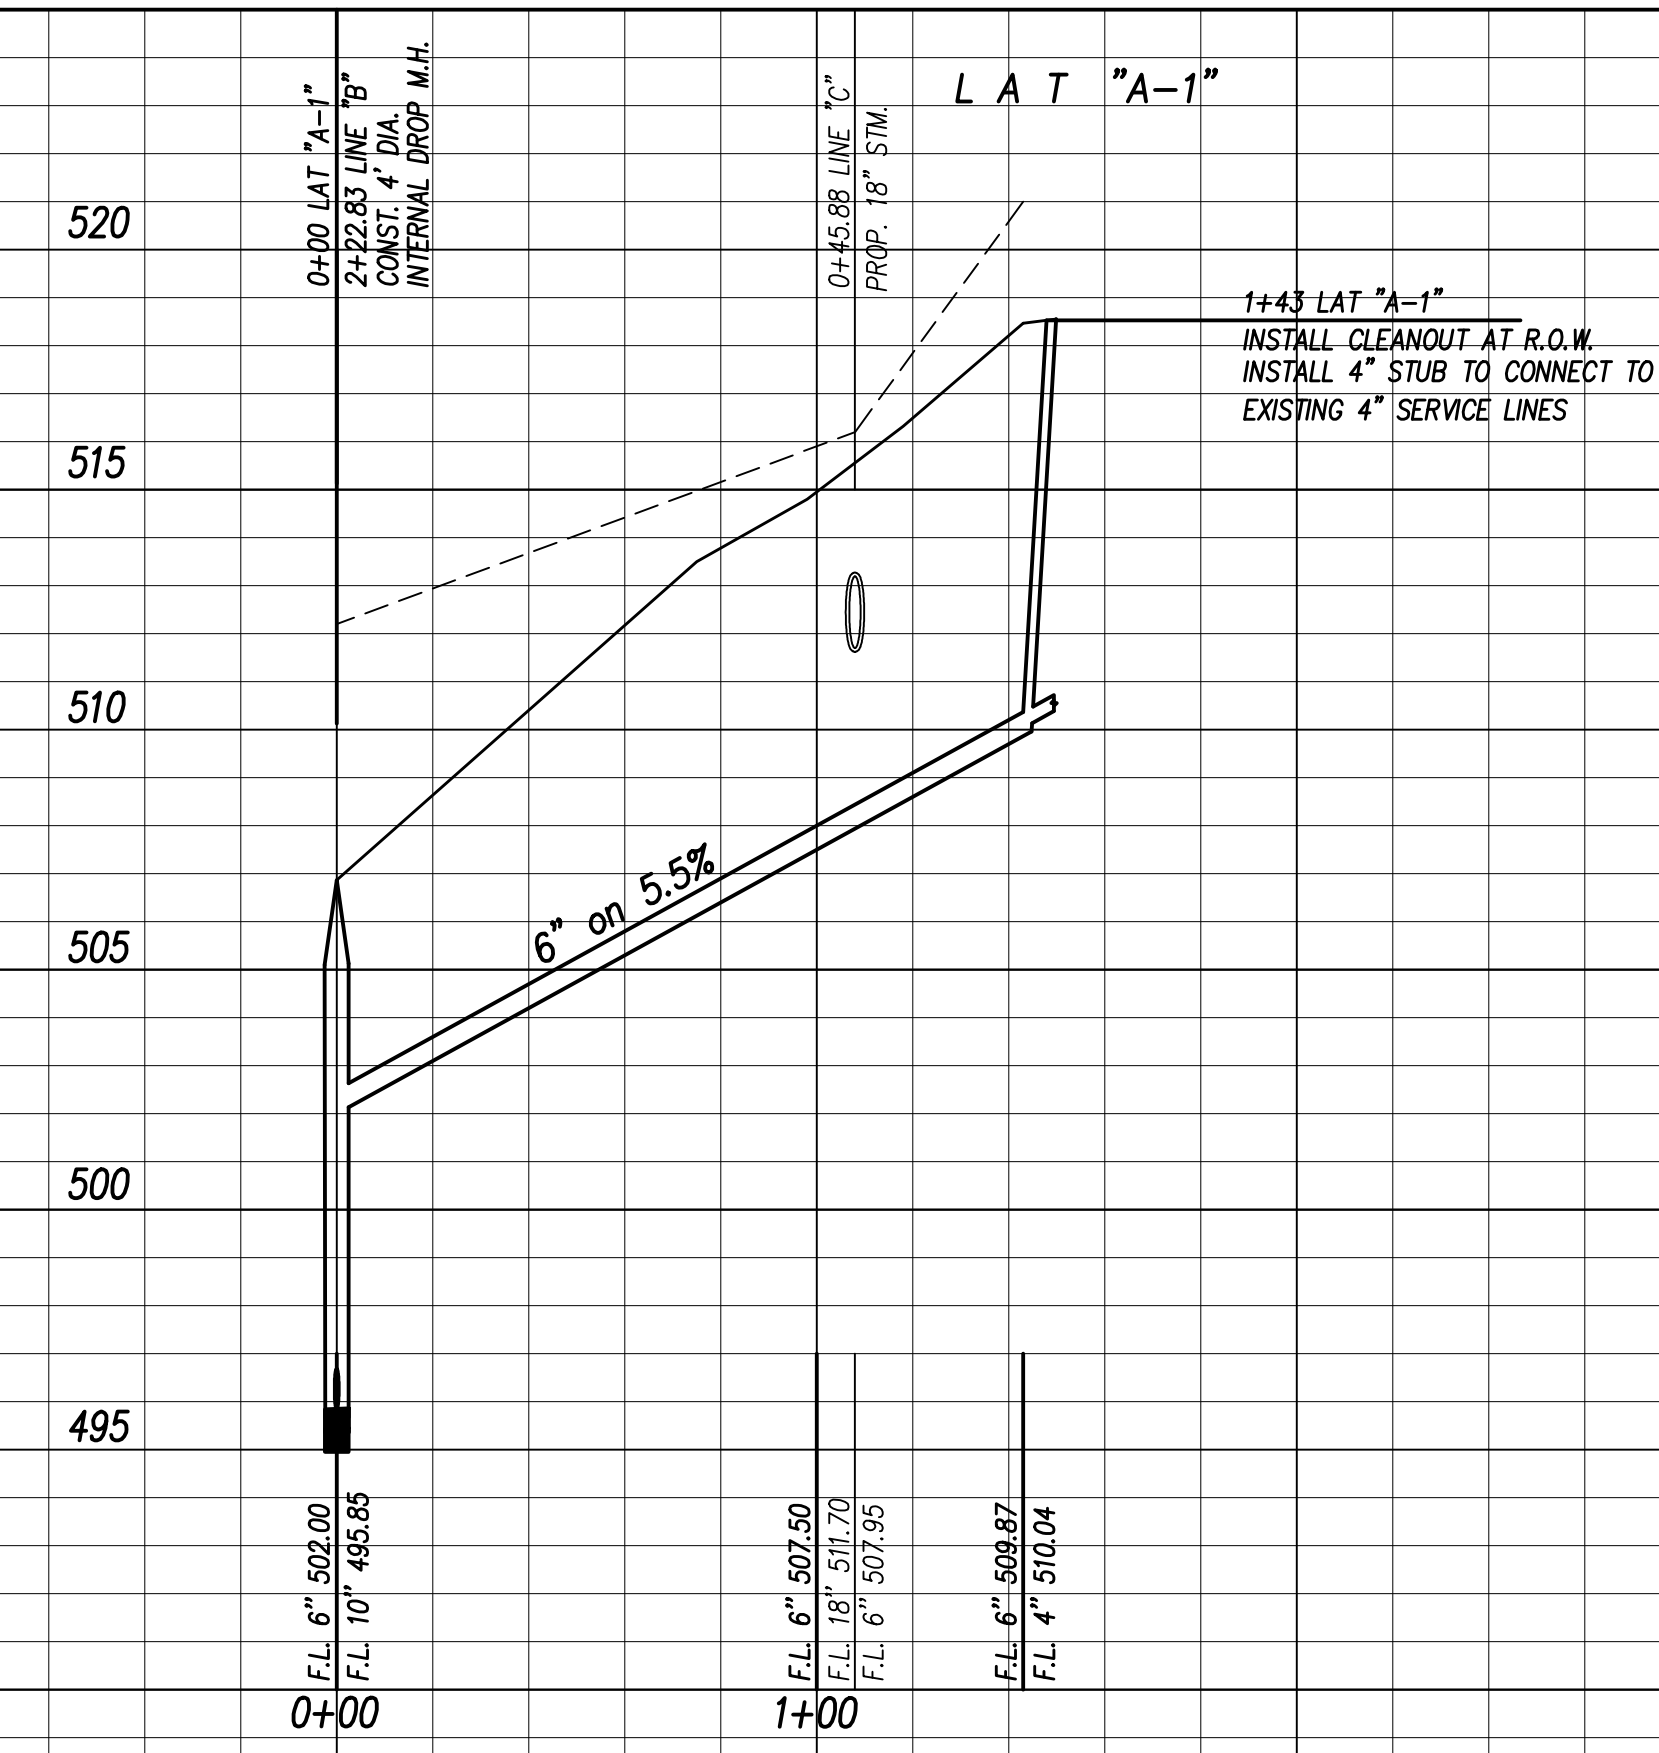
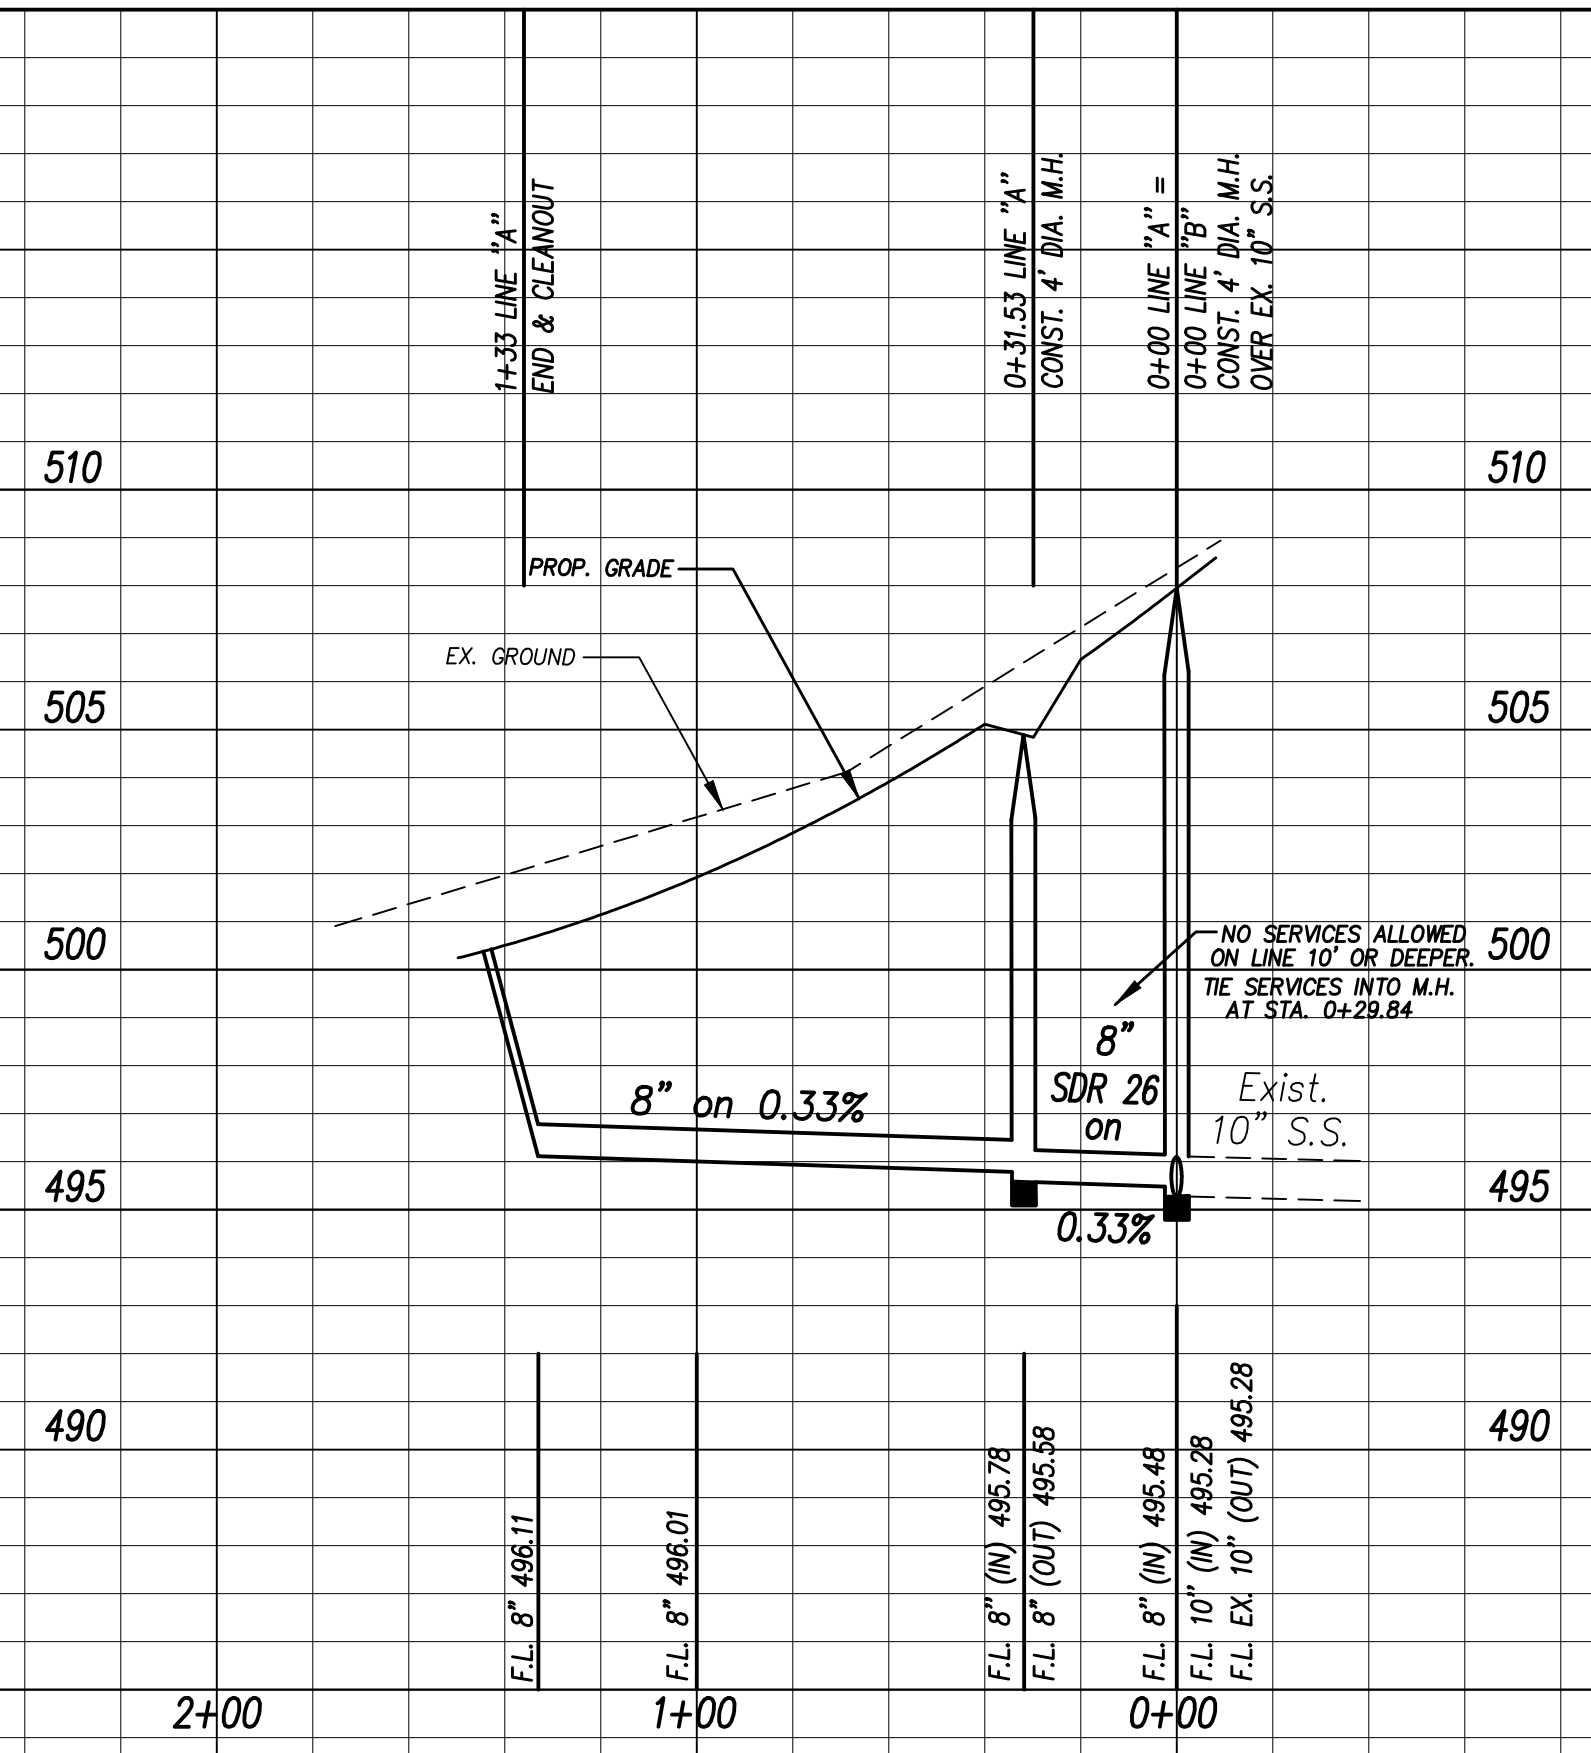


Revision	Date	Description
1	7/10/13	SANITARY SEWER REVISION
2	7/18/13	SANITARY SEWER REVISION
3	8/16/13	SANITARY SEWER REVISION

LINE "A"

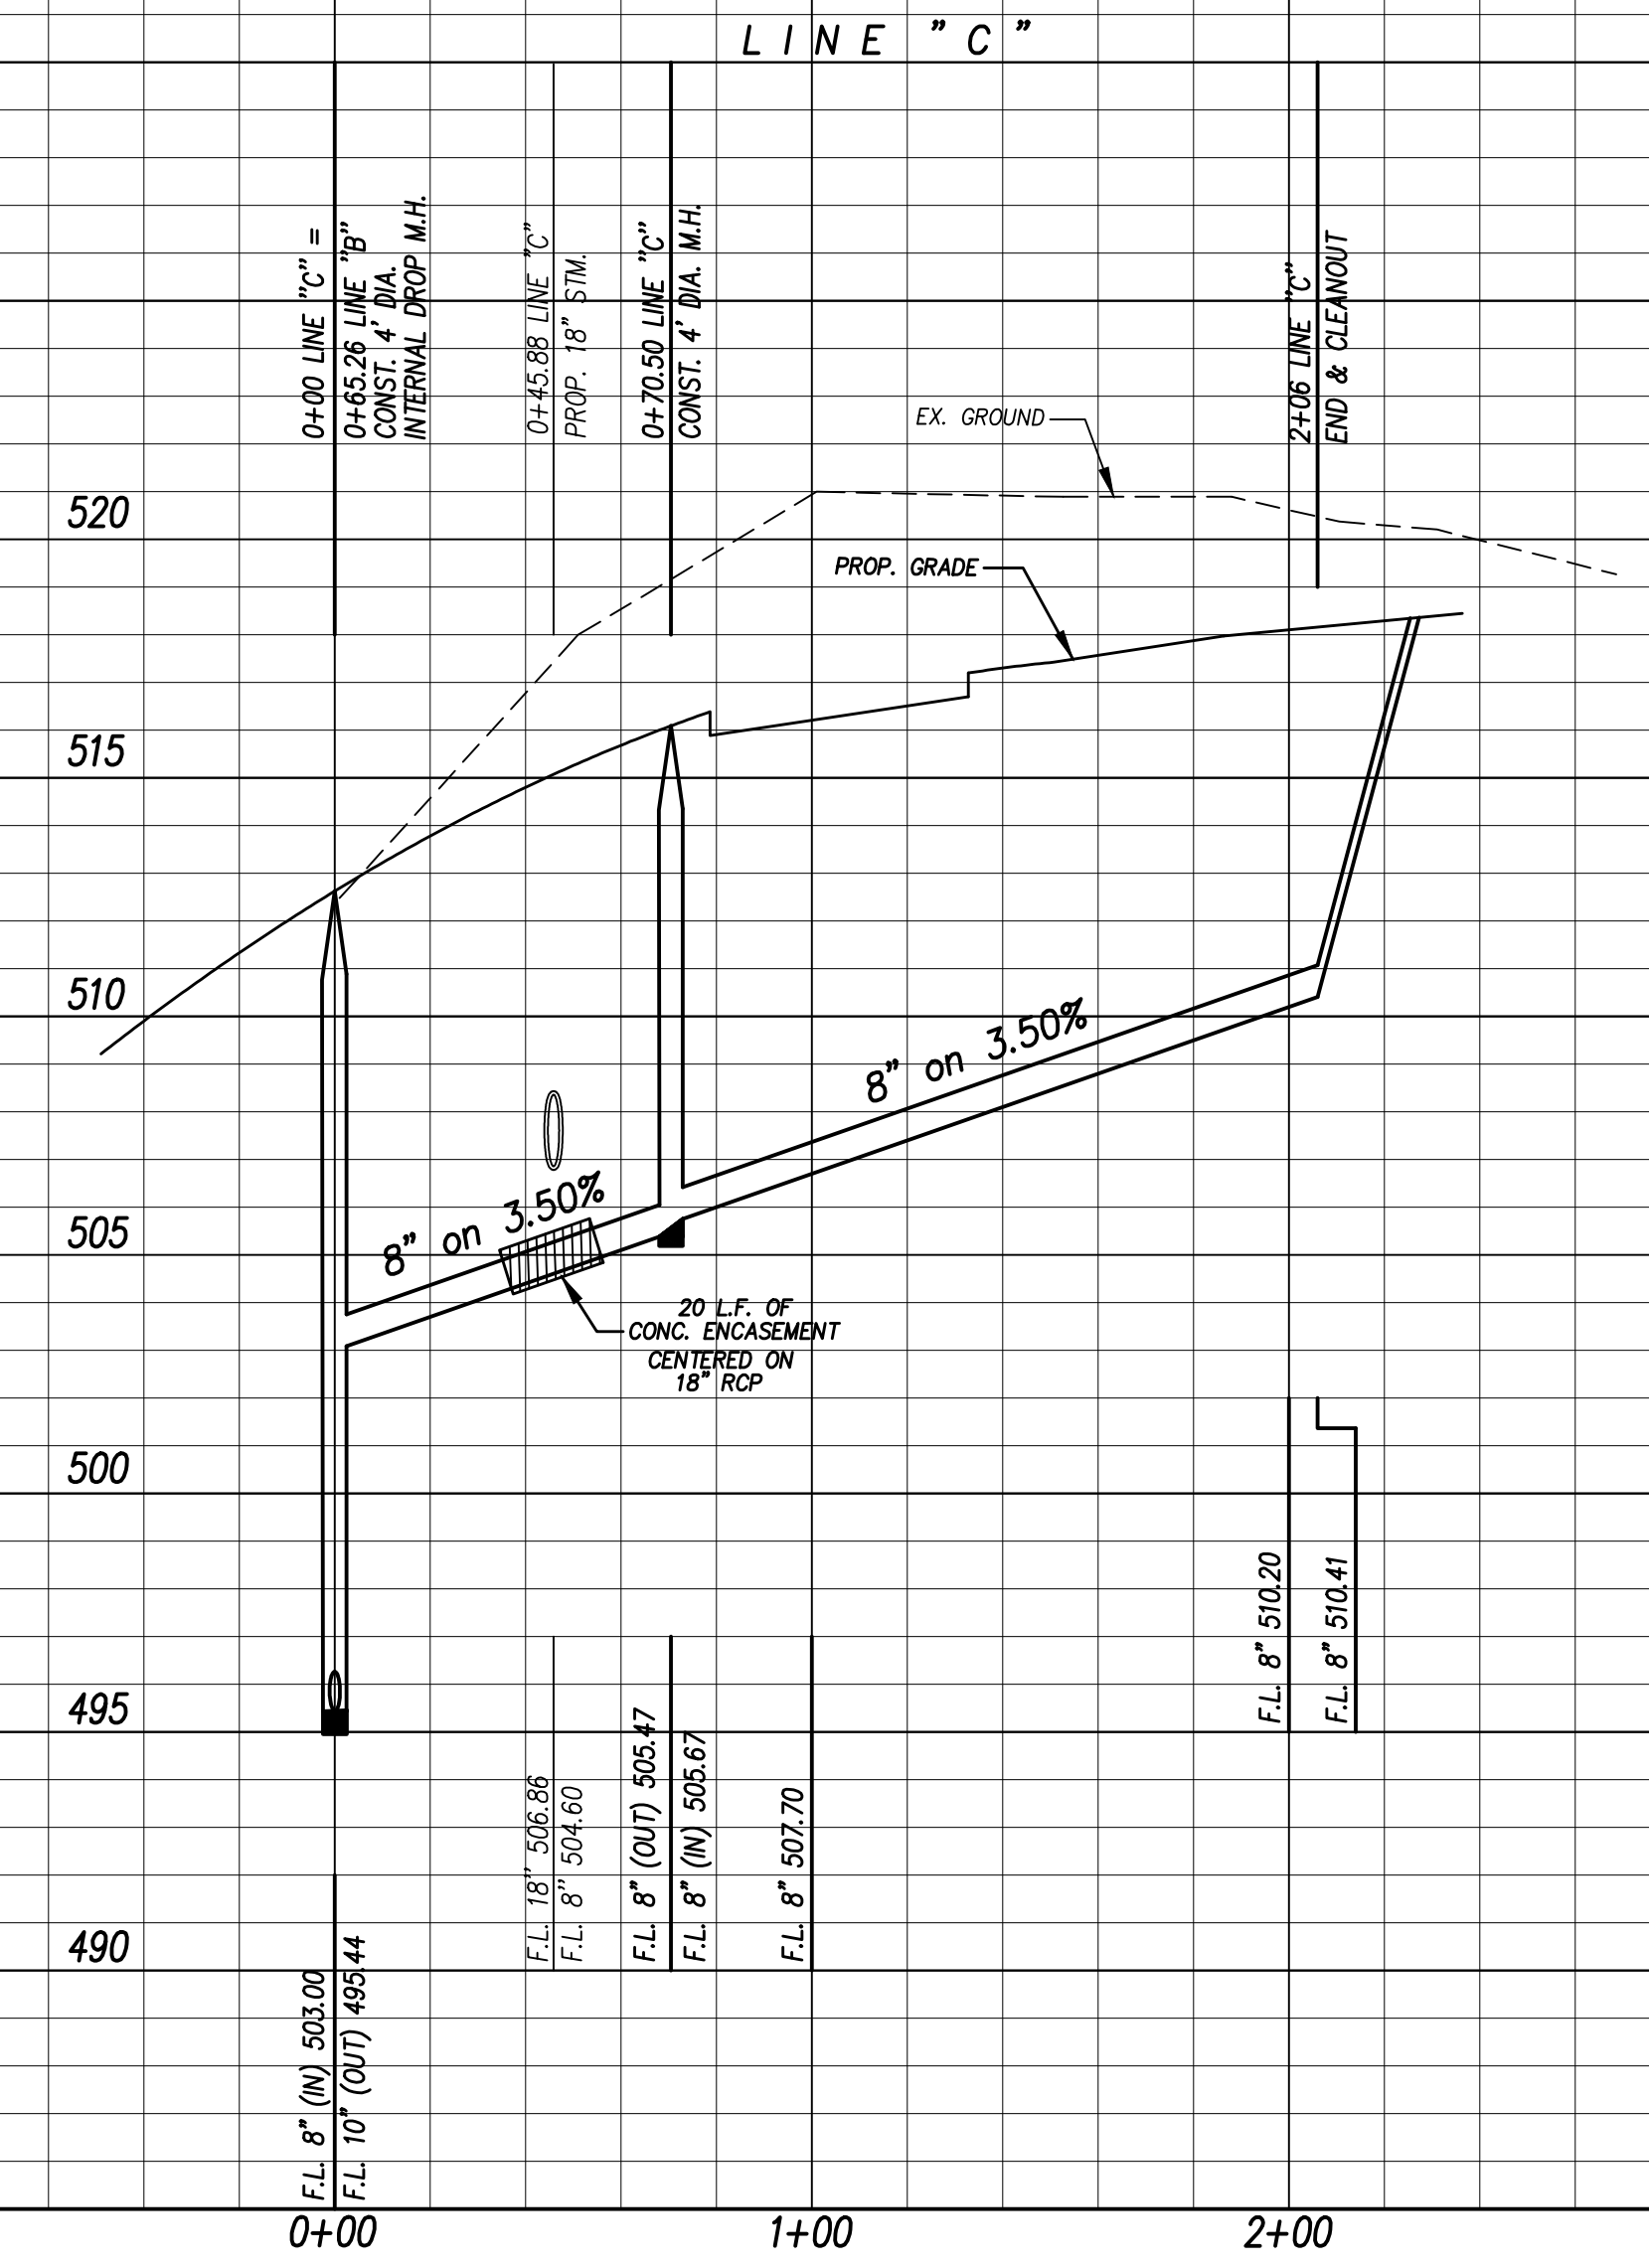

LINE "B"

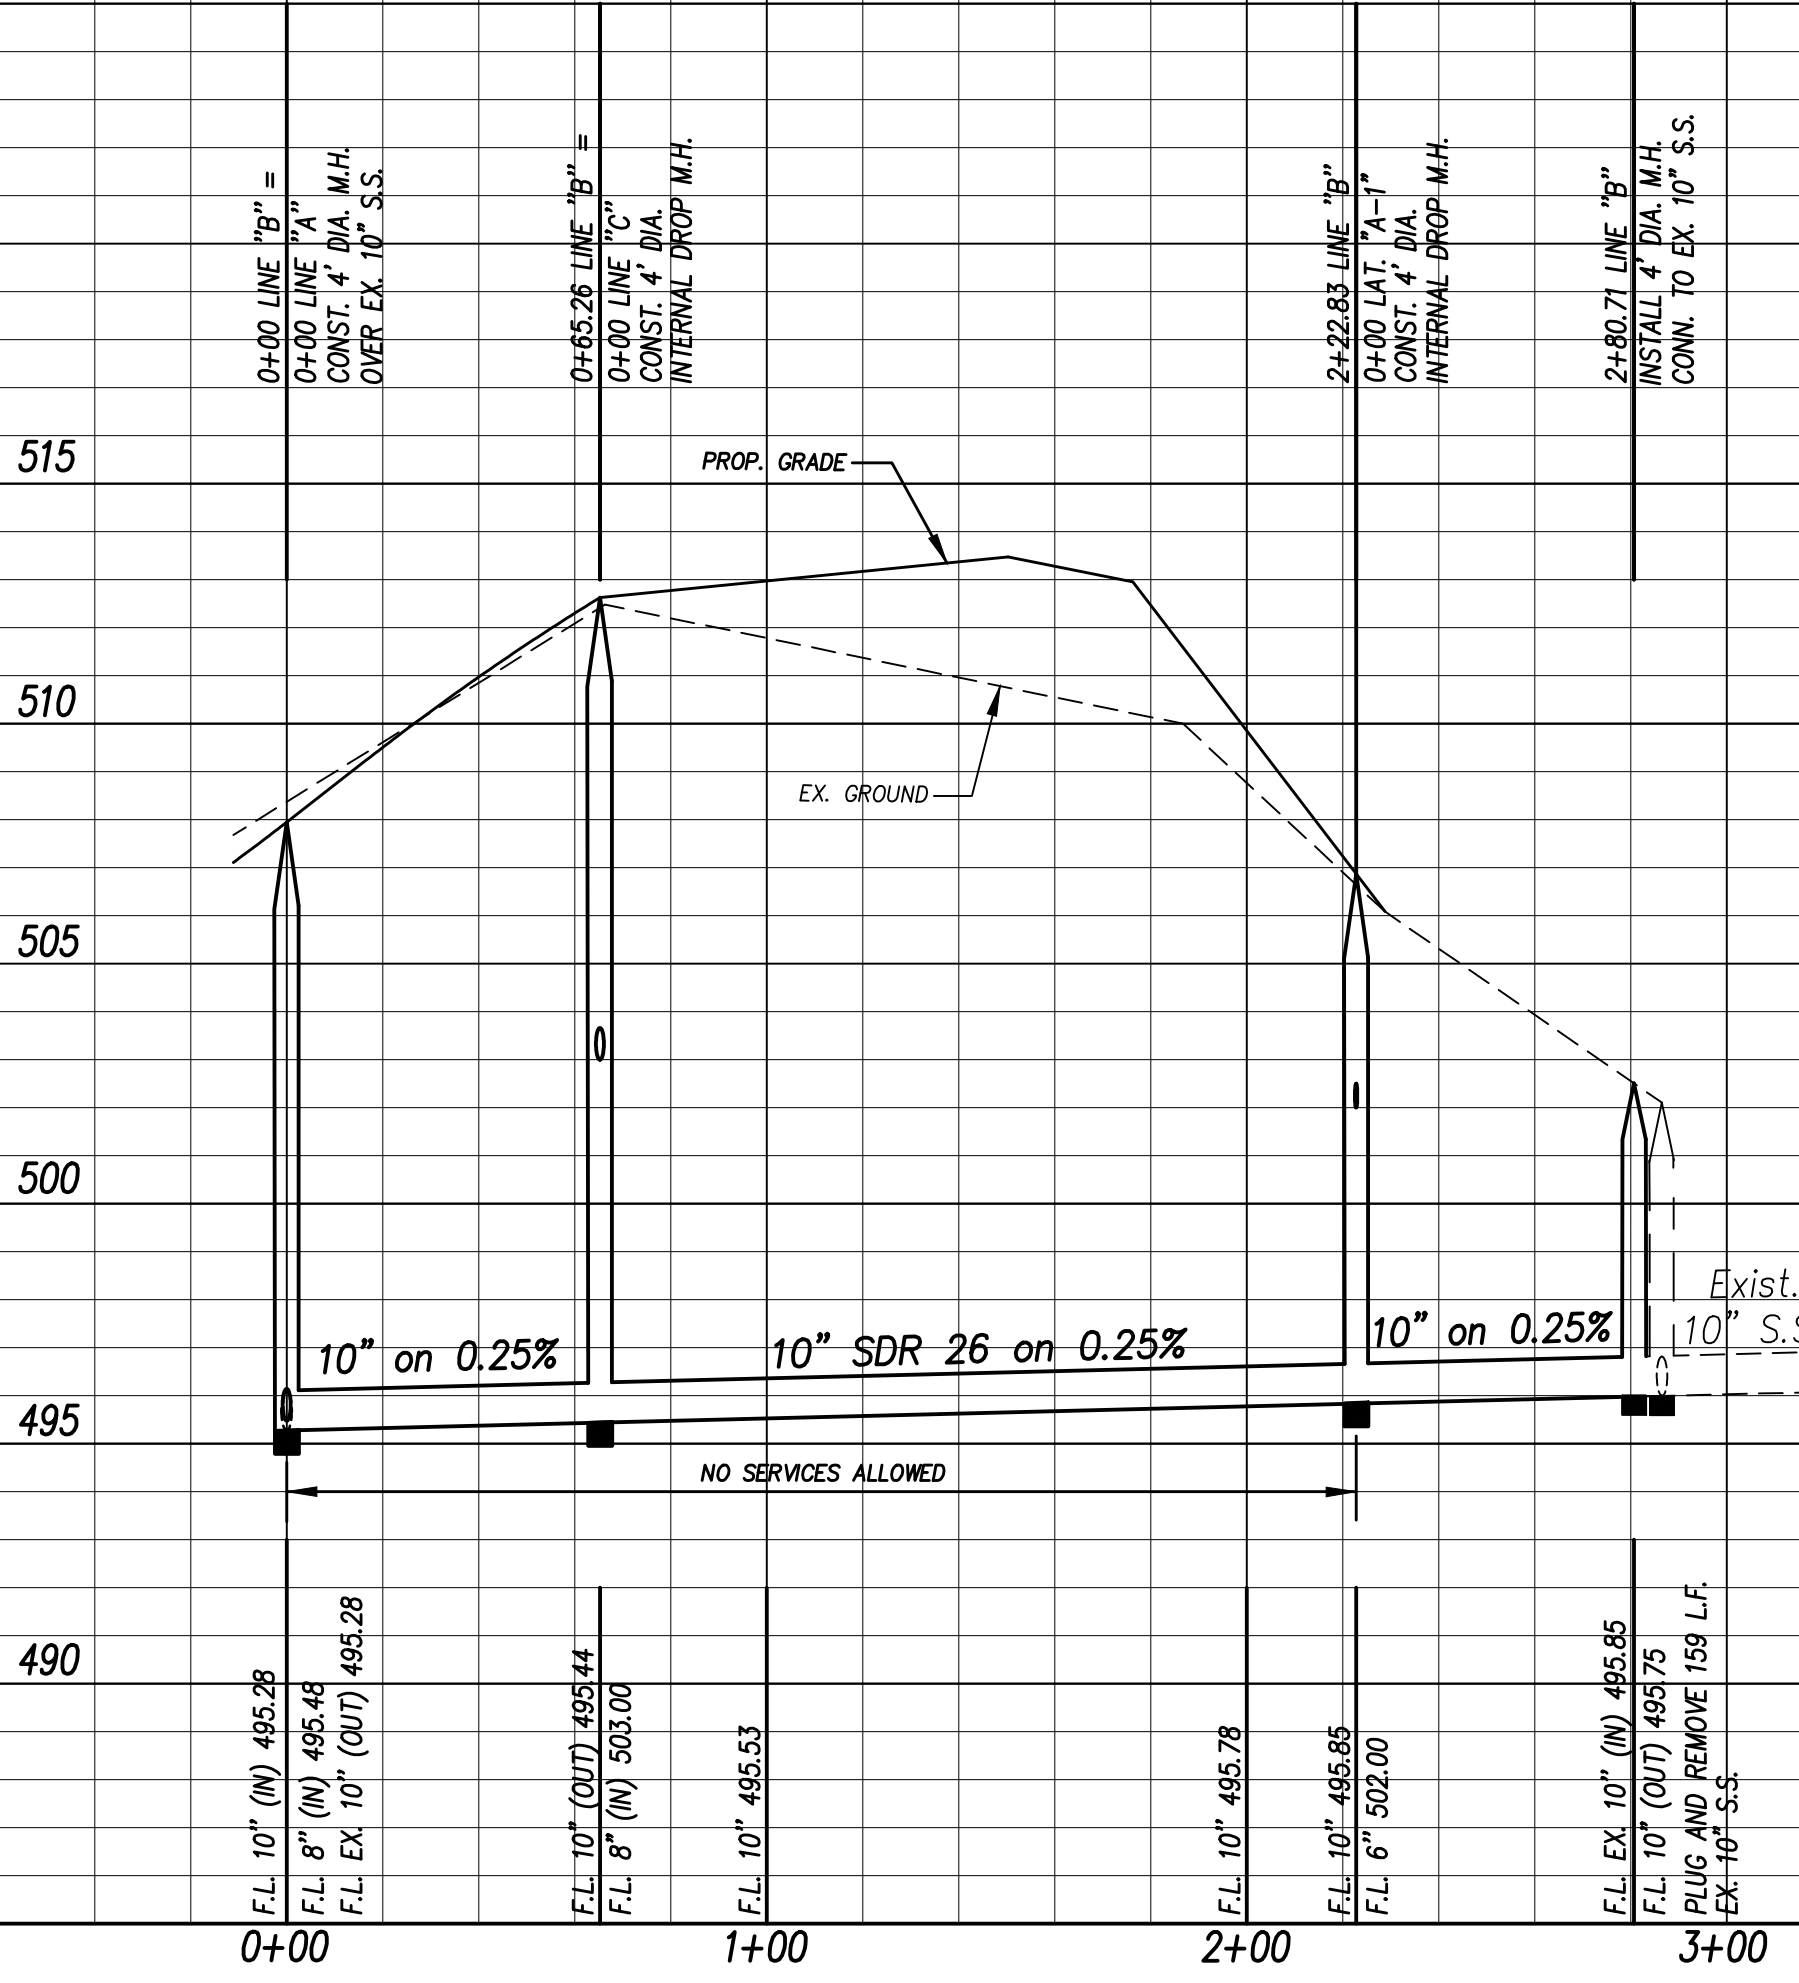


BENCHMARK
 SET "X" CUT IN CENTER OF CONCRETE MEDIAN IN FRONT OF HOUSE #1310 RIDGE ROAD. APPROXIMATELY 38'-21" EAST OF WEST CURVE LINE AND 10' SOUTH OF MEDIAN NOSE.
 ELEV=554.18

CAUTION EXISTING UTILITIES !!!
 EXISTING UTILITIES AND UNDERGROUND FACILITIES INDICATED ON THESE PLANS HAVE BEEN LOCATED FROM REFERENCE INFORMATION. IT SHALL BE THE RESPONSIBILITY OF THE CONTRACTOR TO VERIFY BOTH HORIZONTALLY AND VERTICALLY THE LOCATION OF ALL EXISTING UTILITIES AND UNDERGROUND FACILITIES PRIOR TO CONSTRUCTION. TO TAKE THE NECESSARY PRECAUTIONS IN ORDER TO PROTECT ALL FACILITIES ENCOUNTERED. THE CONTRACTOR SHALL PRESERVE AND PROTECT ALL EXISTING UTILITIES FROM DAMAGE DURING CONSTRUCTION.

Owner:
Dan Bobst
 5133 F.M. 549 • Rockwall, Texas • 75032
 Phone: 214-553-5505

Eagle Point Estates
 Rockwall, Texas

~ Civil Engineer ~
F.C. CUNY CORPORATION
 #2 Horizon Court • Heath, Texas 75032 • (469) 402-7700
 Texas Registered Engineering Firm F-7449

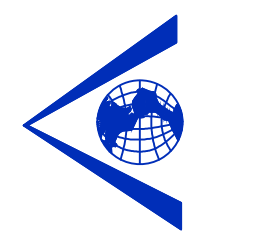

Drawn By: F.C. CUNY	Checked By: F.C. CUNY
Date: 08/11	Project No.:
Sheet Title: Sanitary Sewer Profiles	

Scale:	Sheet No.:
h : 1" = 40'	6 of 12
v : 1" = 4'	

Z:\Projects\5-Residential\Dan Bobst\AS BUILT\106 - SANITARY SEWER PROFILES.dwg