

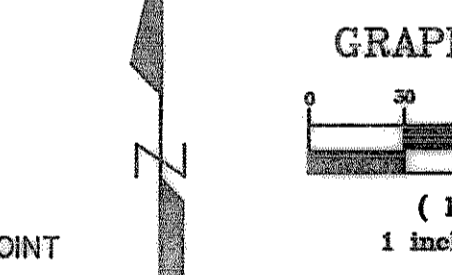
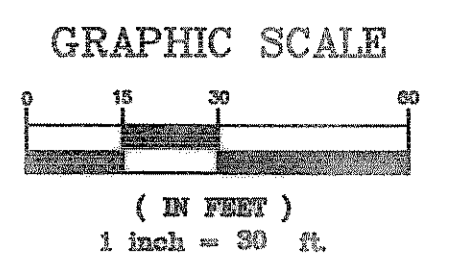


S:\Land Projects\2004\268-06\dwg\01C02PAY.dwg 5/27/2004 10:23:09 AM CST

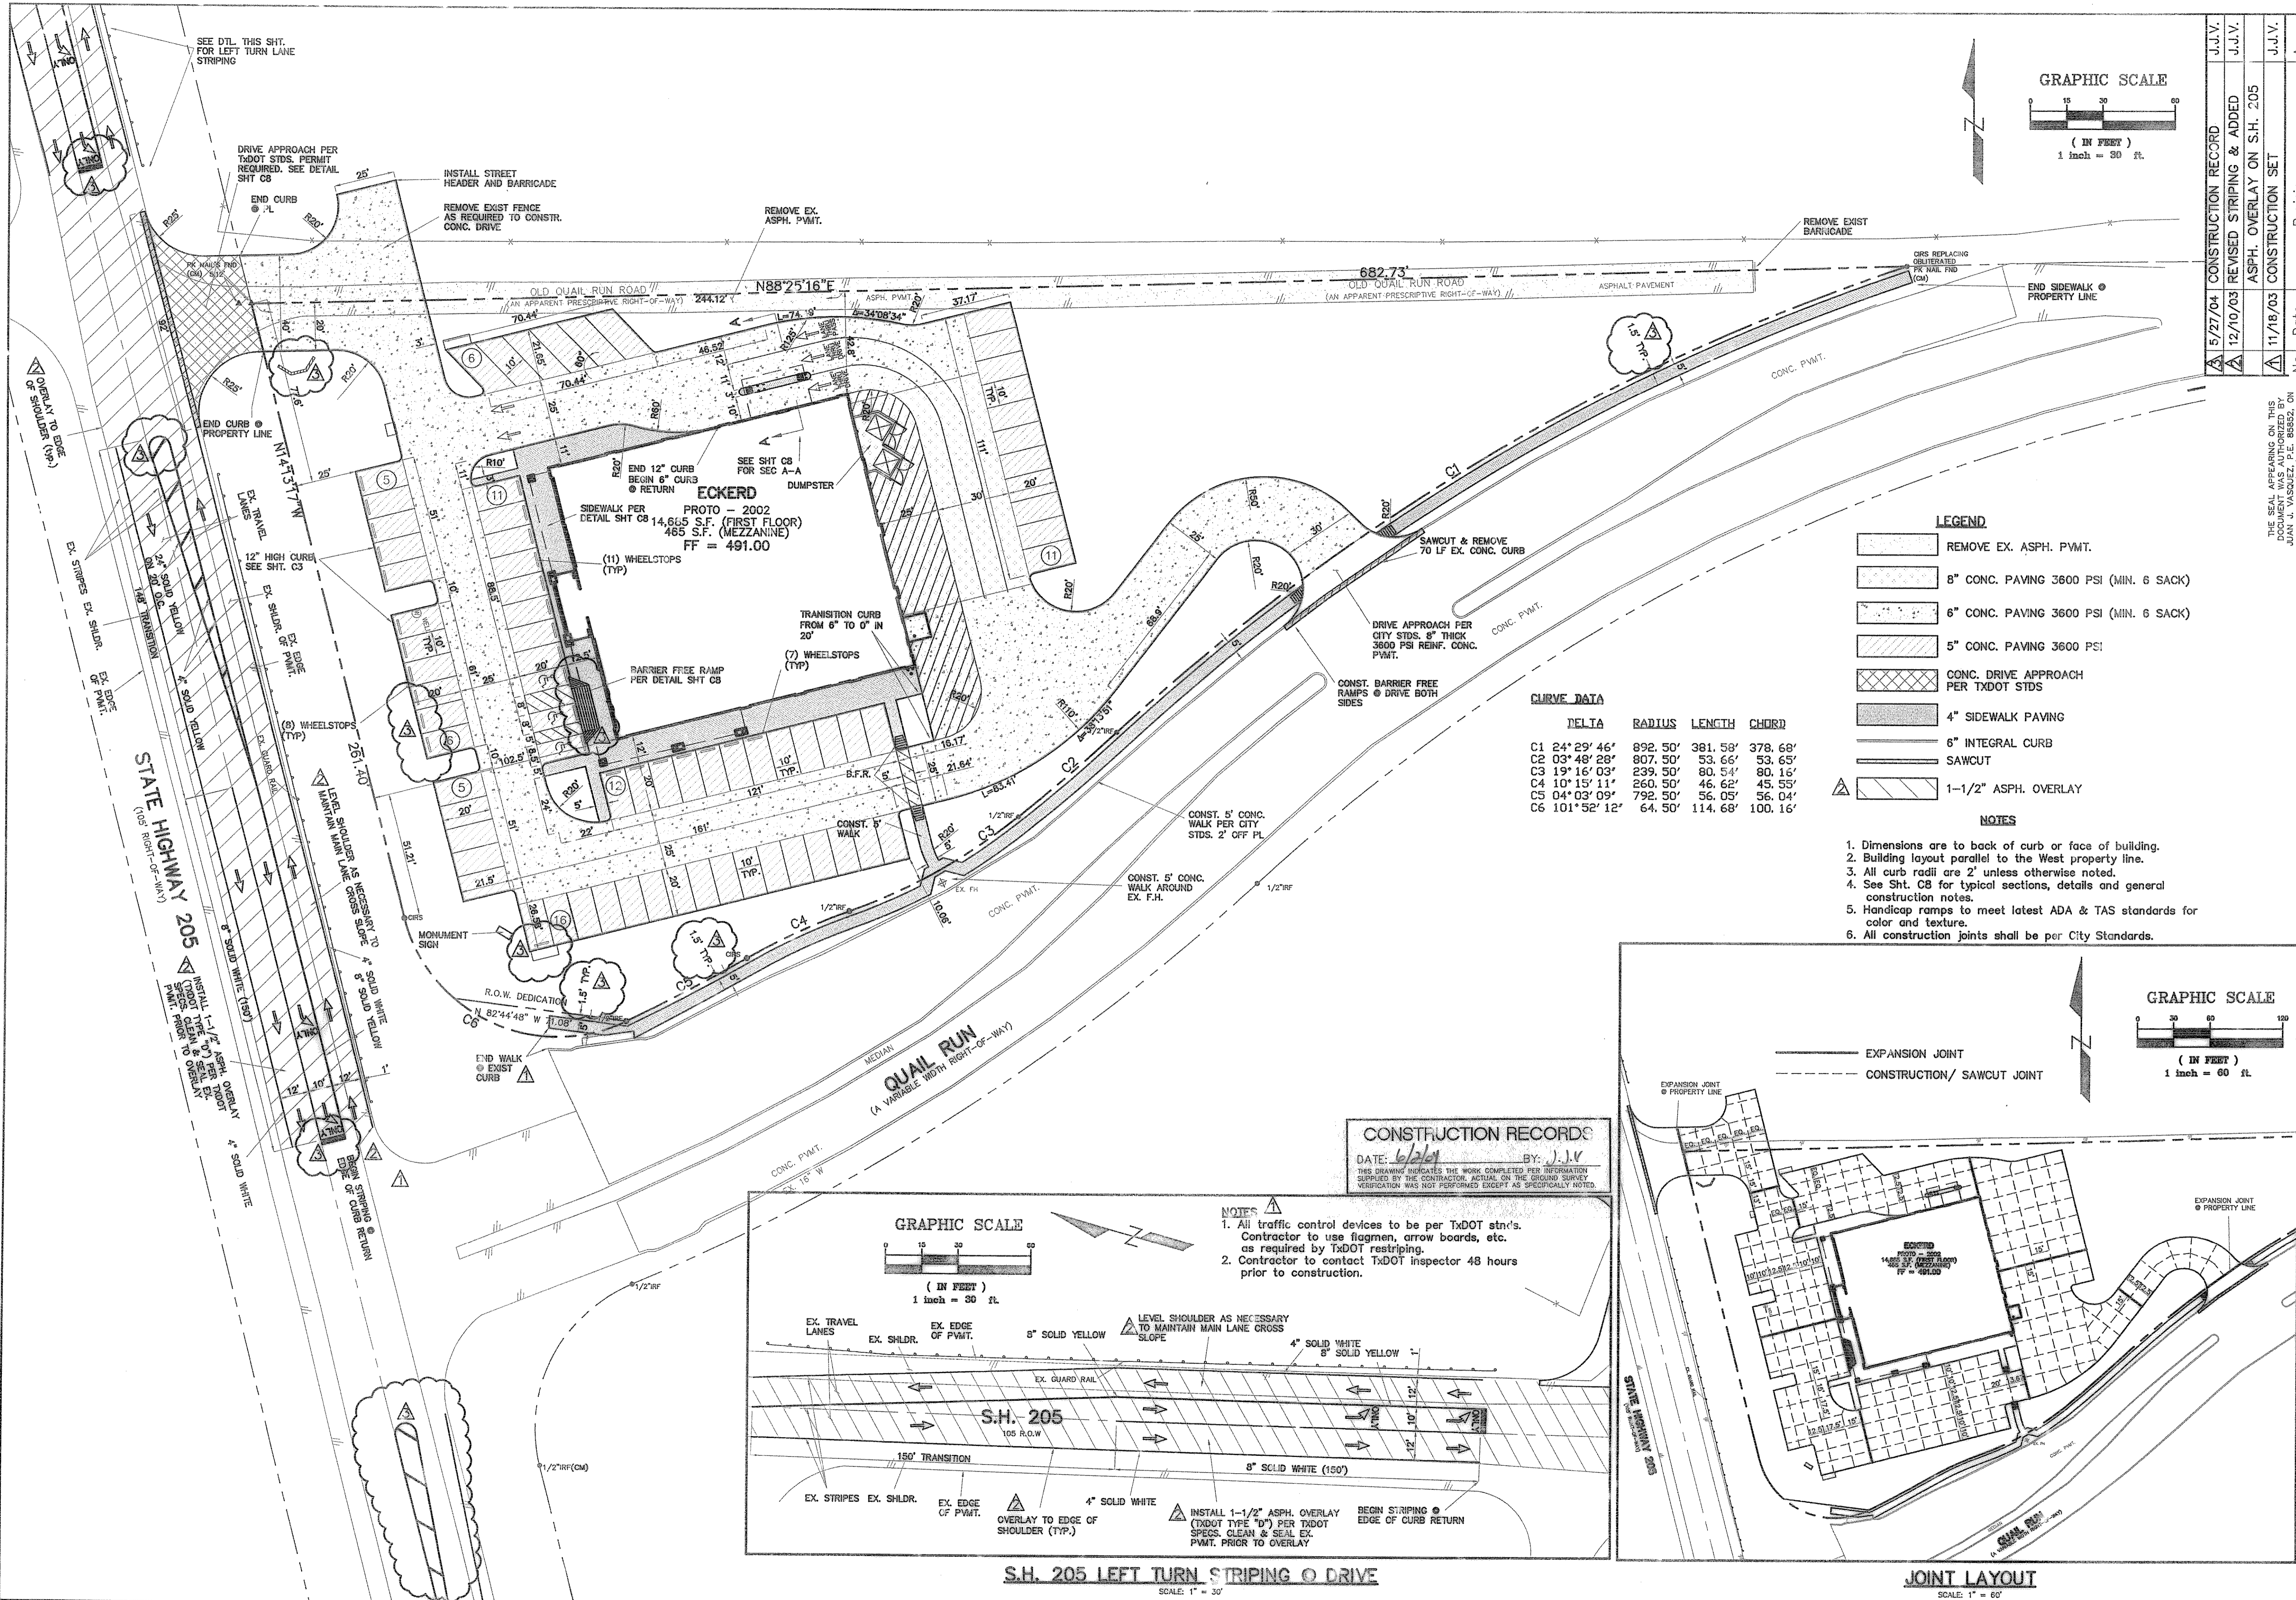

No.	Date	Revisions
1	5/27/04	CONSTRUCTION RECORD
2	12/10/03	REVISED STRIPING & ADDED ASPH. OVERLAY ON S.H. 205
3	11/18/03	CONSTRUCTION SET

TOMDEN ENGINEERING
 12655 N. CENTRAL EXPY., SUITE 1016
 DALLAS, TX. 75243
 972.386-6446 FAX 972.386-6409
 tomden@aolmail.net

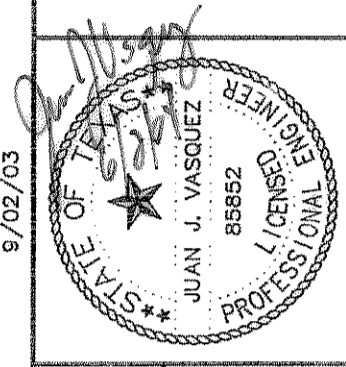

ECKERD - ROCKWALL, TEXAS

ARCHITECT:
 GENESIS DESIGN GROUP, INC.
 2080 N. HIGHWAY 360, STE. 200
 GRAND PRAIRIE, TX. 75050

OWNER:
 MAYS & COMPANY
 5949 SHERRY LANE, # 1570
 DALLAS, TX. 75225

LAYOUT & PAVING PLAN

Scale: NOTED ON PLAN
 Designed by: J.J.V.
 Drawn by: R.W.A./J.K.A.
 Checked by: T.P.J.
 /dwg/268-06/01C02PAY.dwg
 Date: 05/27/04 11:00



SHEET
C2
 OF 8

- LEGEND**
- [Pattern] REMOVE EX. ASPH. P.V.M.T.
 - [Pattern] 8" CONC. PAVING 3600 PSI (MIN. 6 SACK)
 - [Pattern] 6" CONC. PAVING 3600 PSI (MIN. 6 SACK)
 - [Pattern] 5" CONC. PAVING 3600 PSI
 - [Pattern] CONC. DRIVE APPROACH PER TxDOT STDS
 - [Pattern] 4" SIDEWALK PAVING
 - [Pattern] 6" INTEGRAL CURB
 - [Pattern] SAWCUT
 - [Pattern] 1-1/2" ASPH. OVERLAY
- NOTES**
- Dimensions are to back of curb or face of building.
 - Building layout parallel to the West property line.
 - All curb radii are 2' unless otherwise noted.
 - See Sht. C8 for typical sections, details and general construction notes.
 - Handicap ramps to meet latest ADA & TAS standards for color and texture.
 - All construction joints shall be per City Standards.

CURVE DATA

DELTA	RADIUS	LENGTH	CHORD
C1 24°29'46"	892.50'	381.58'	378.68'
C2 03°48'28"	807.50'	53.66'	53.65'
C3 19°16'03"	239.50'	80.54'	80.16'
C4 10°15'11"	260.50'	46.62'	45.55'
C5 04°03'09"	792.50'	56.05'	56.04'
C6 101°52'12"	64.50'	114.68'	100.16'

CONSTRUCTION RECORDS
 DATE: 6/2/04 BY: J.J.V.
 THIS DRAWING INDICATES THE WORK COMPLETED PER INFORMATION SUPPLIED BY THE CONTRACTOR. ACTUAL ON THE GROUND SURVEY VERIFICATION WAS NOT PERFORMED EXCEPT AS SPECIFICALLY NOTED.

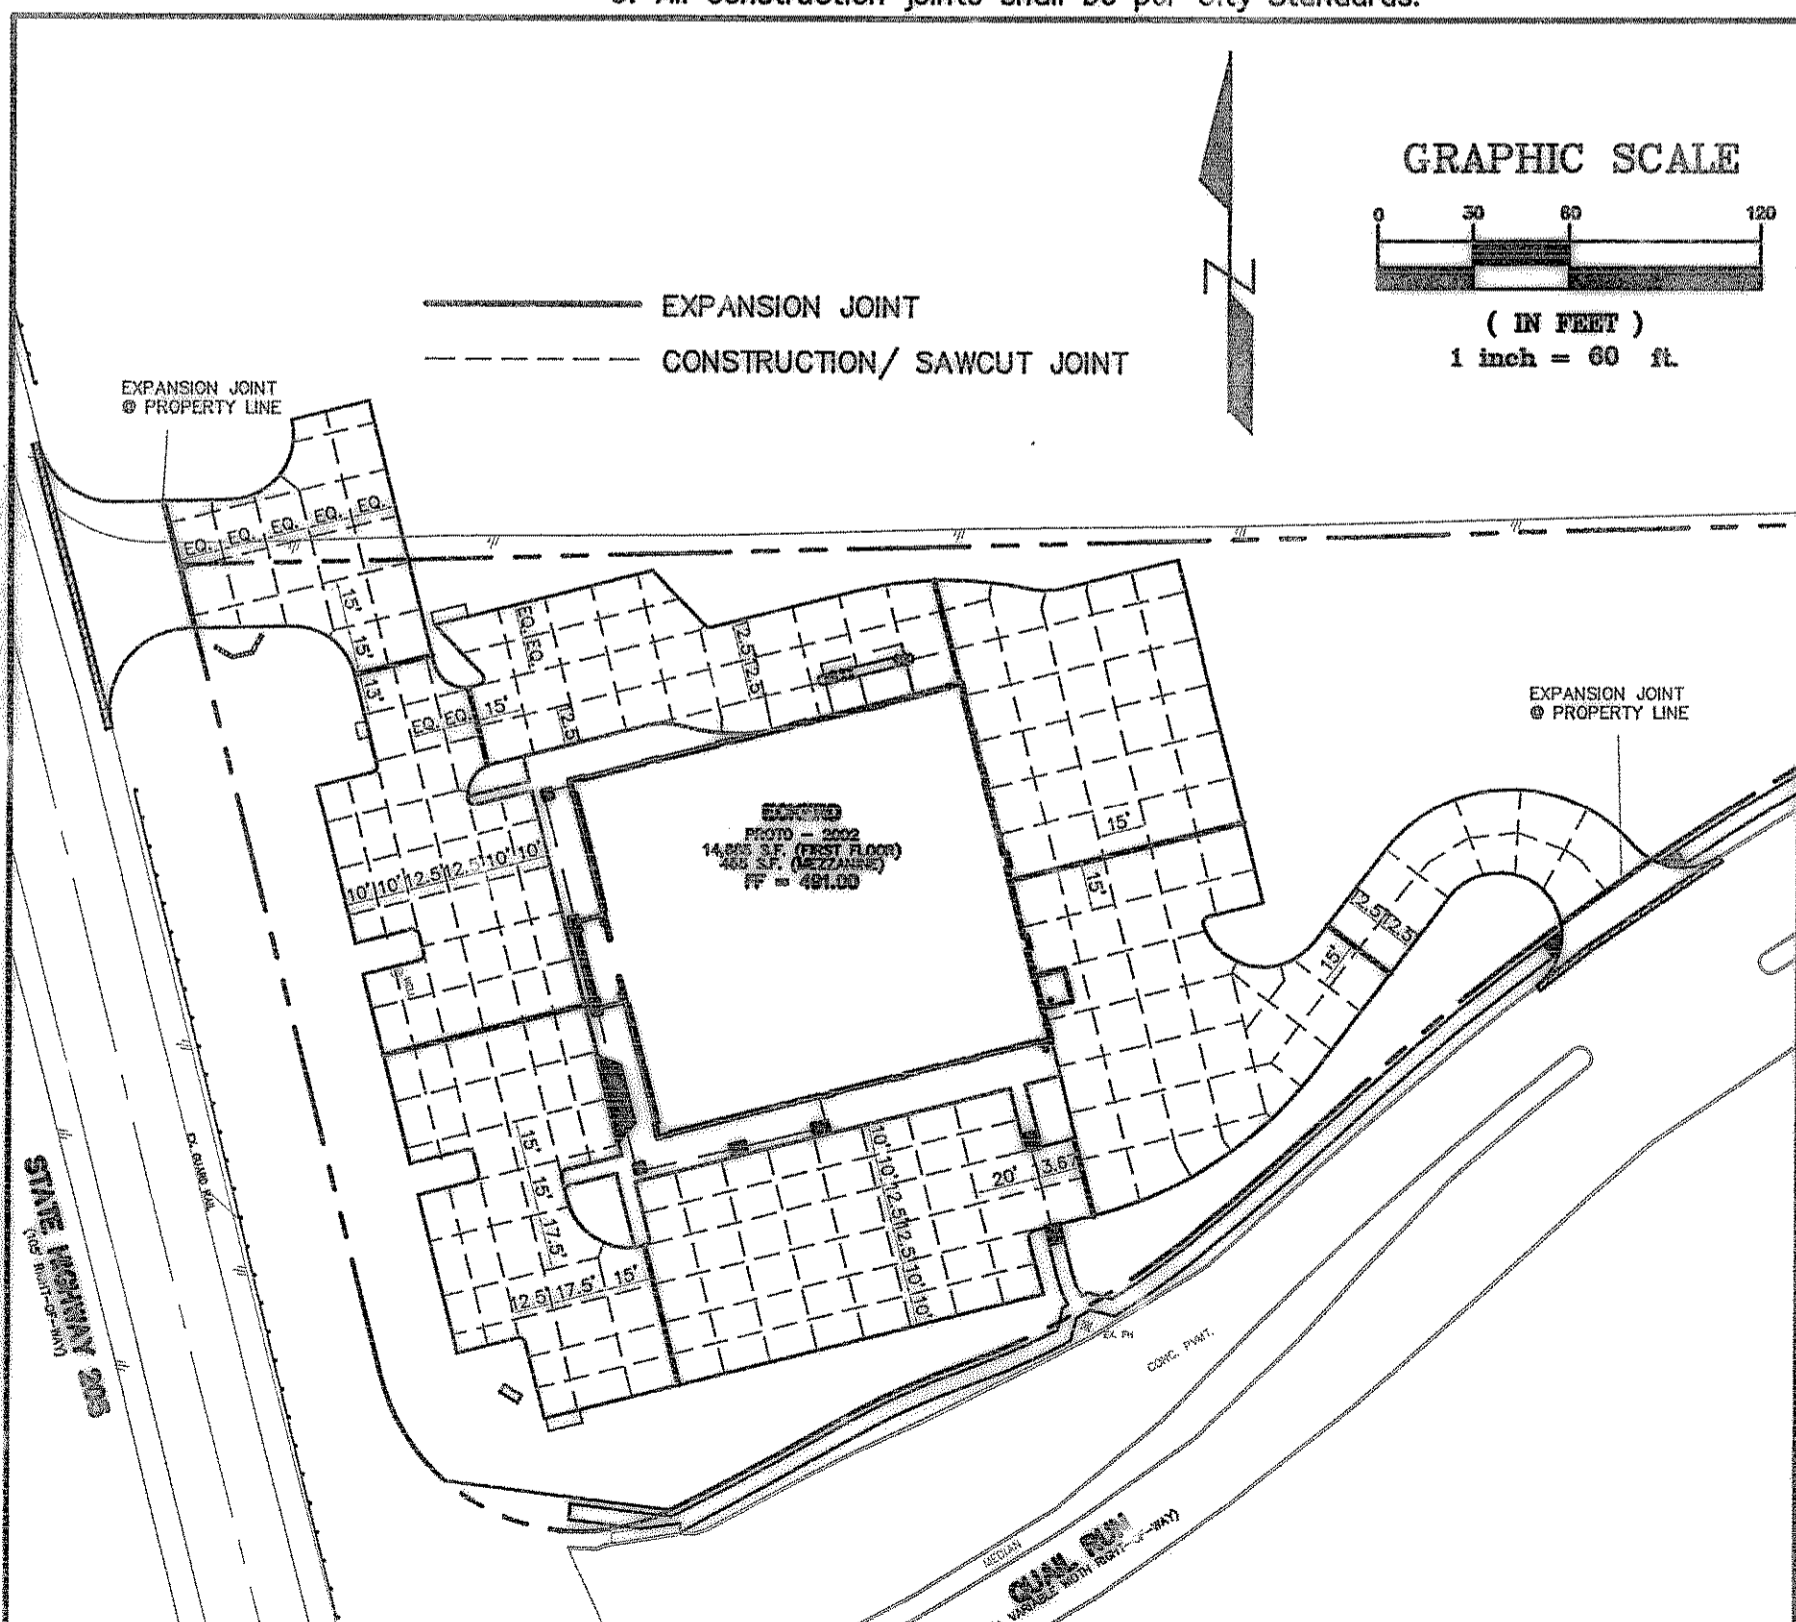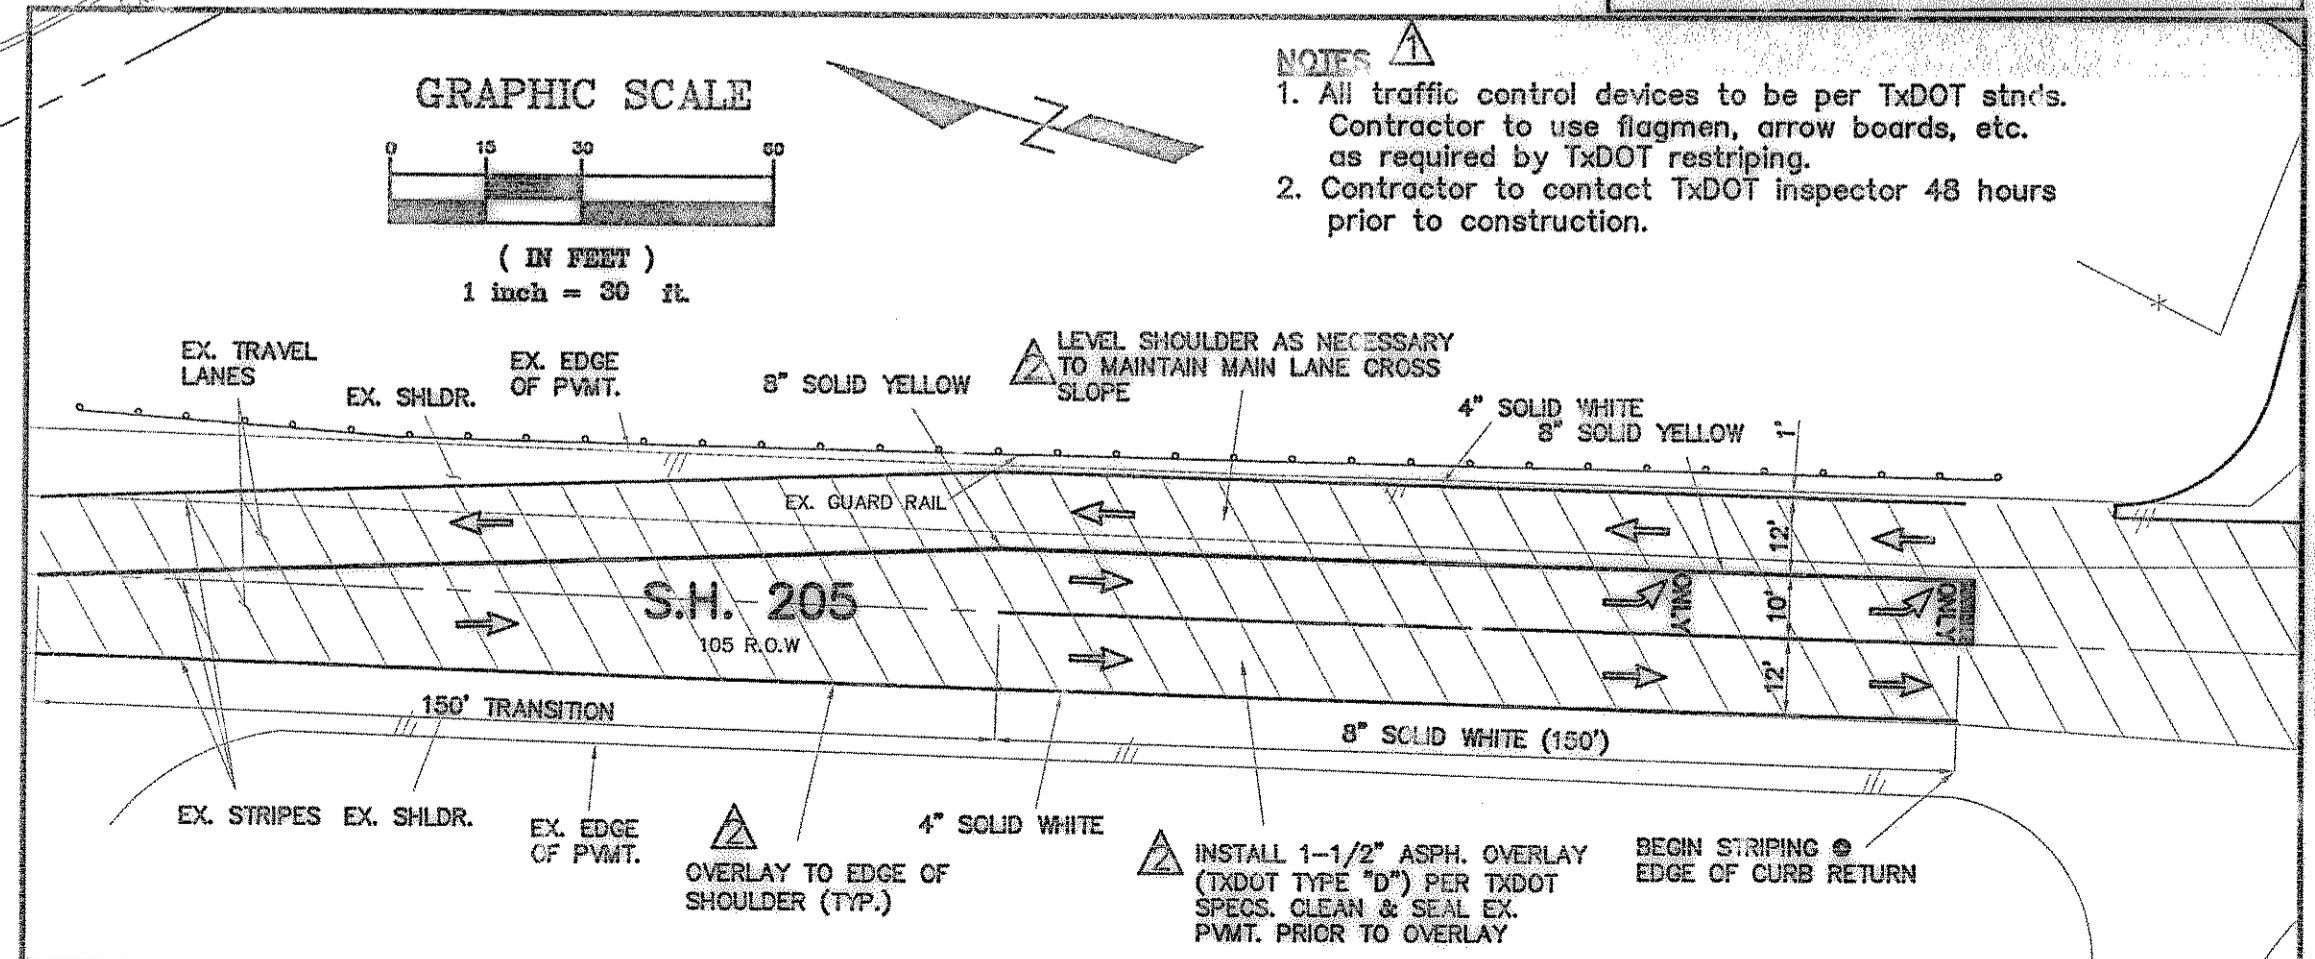

S.H. 205 LEFT TURN STRIPING DRIVE
 SCALE: 1" = 30'

JOINT LAYOUT
 SCALE: 1" = 60'