


**EVERGREEN AT ROCKWALL**

**STORM SEWER PROFILES - 2**

Scale: AS SHOWN  
 Designed by: KHA  
 Drawn by: KHA  
 Checked by: KHA  
 Date: DECEMBER 2006  
 Project No. 063890013

5/27/2008 2:55pm  
 X:\GIS\PROJECTS\2006\12\06\063890013\DWG\SSW\SSW\_C18.dwg  
 Images: BDDI\BDF\ALST

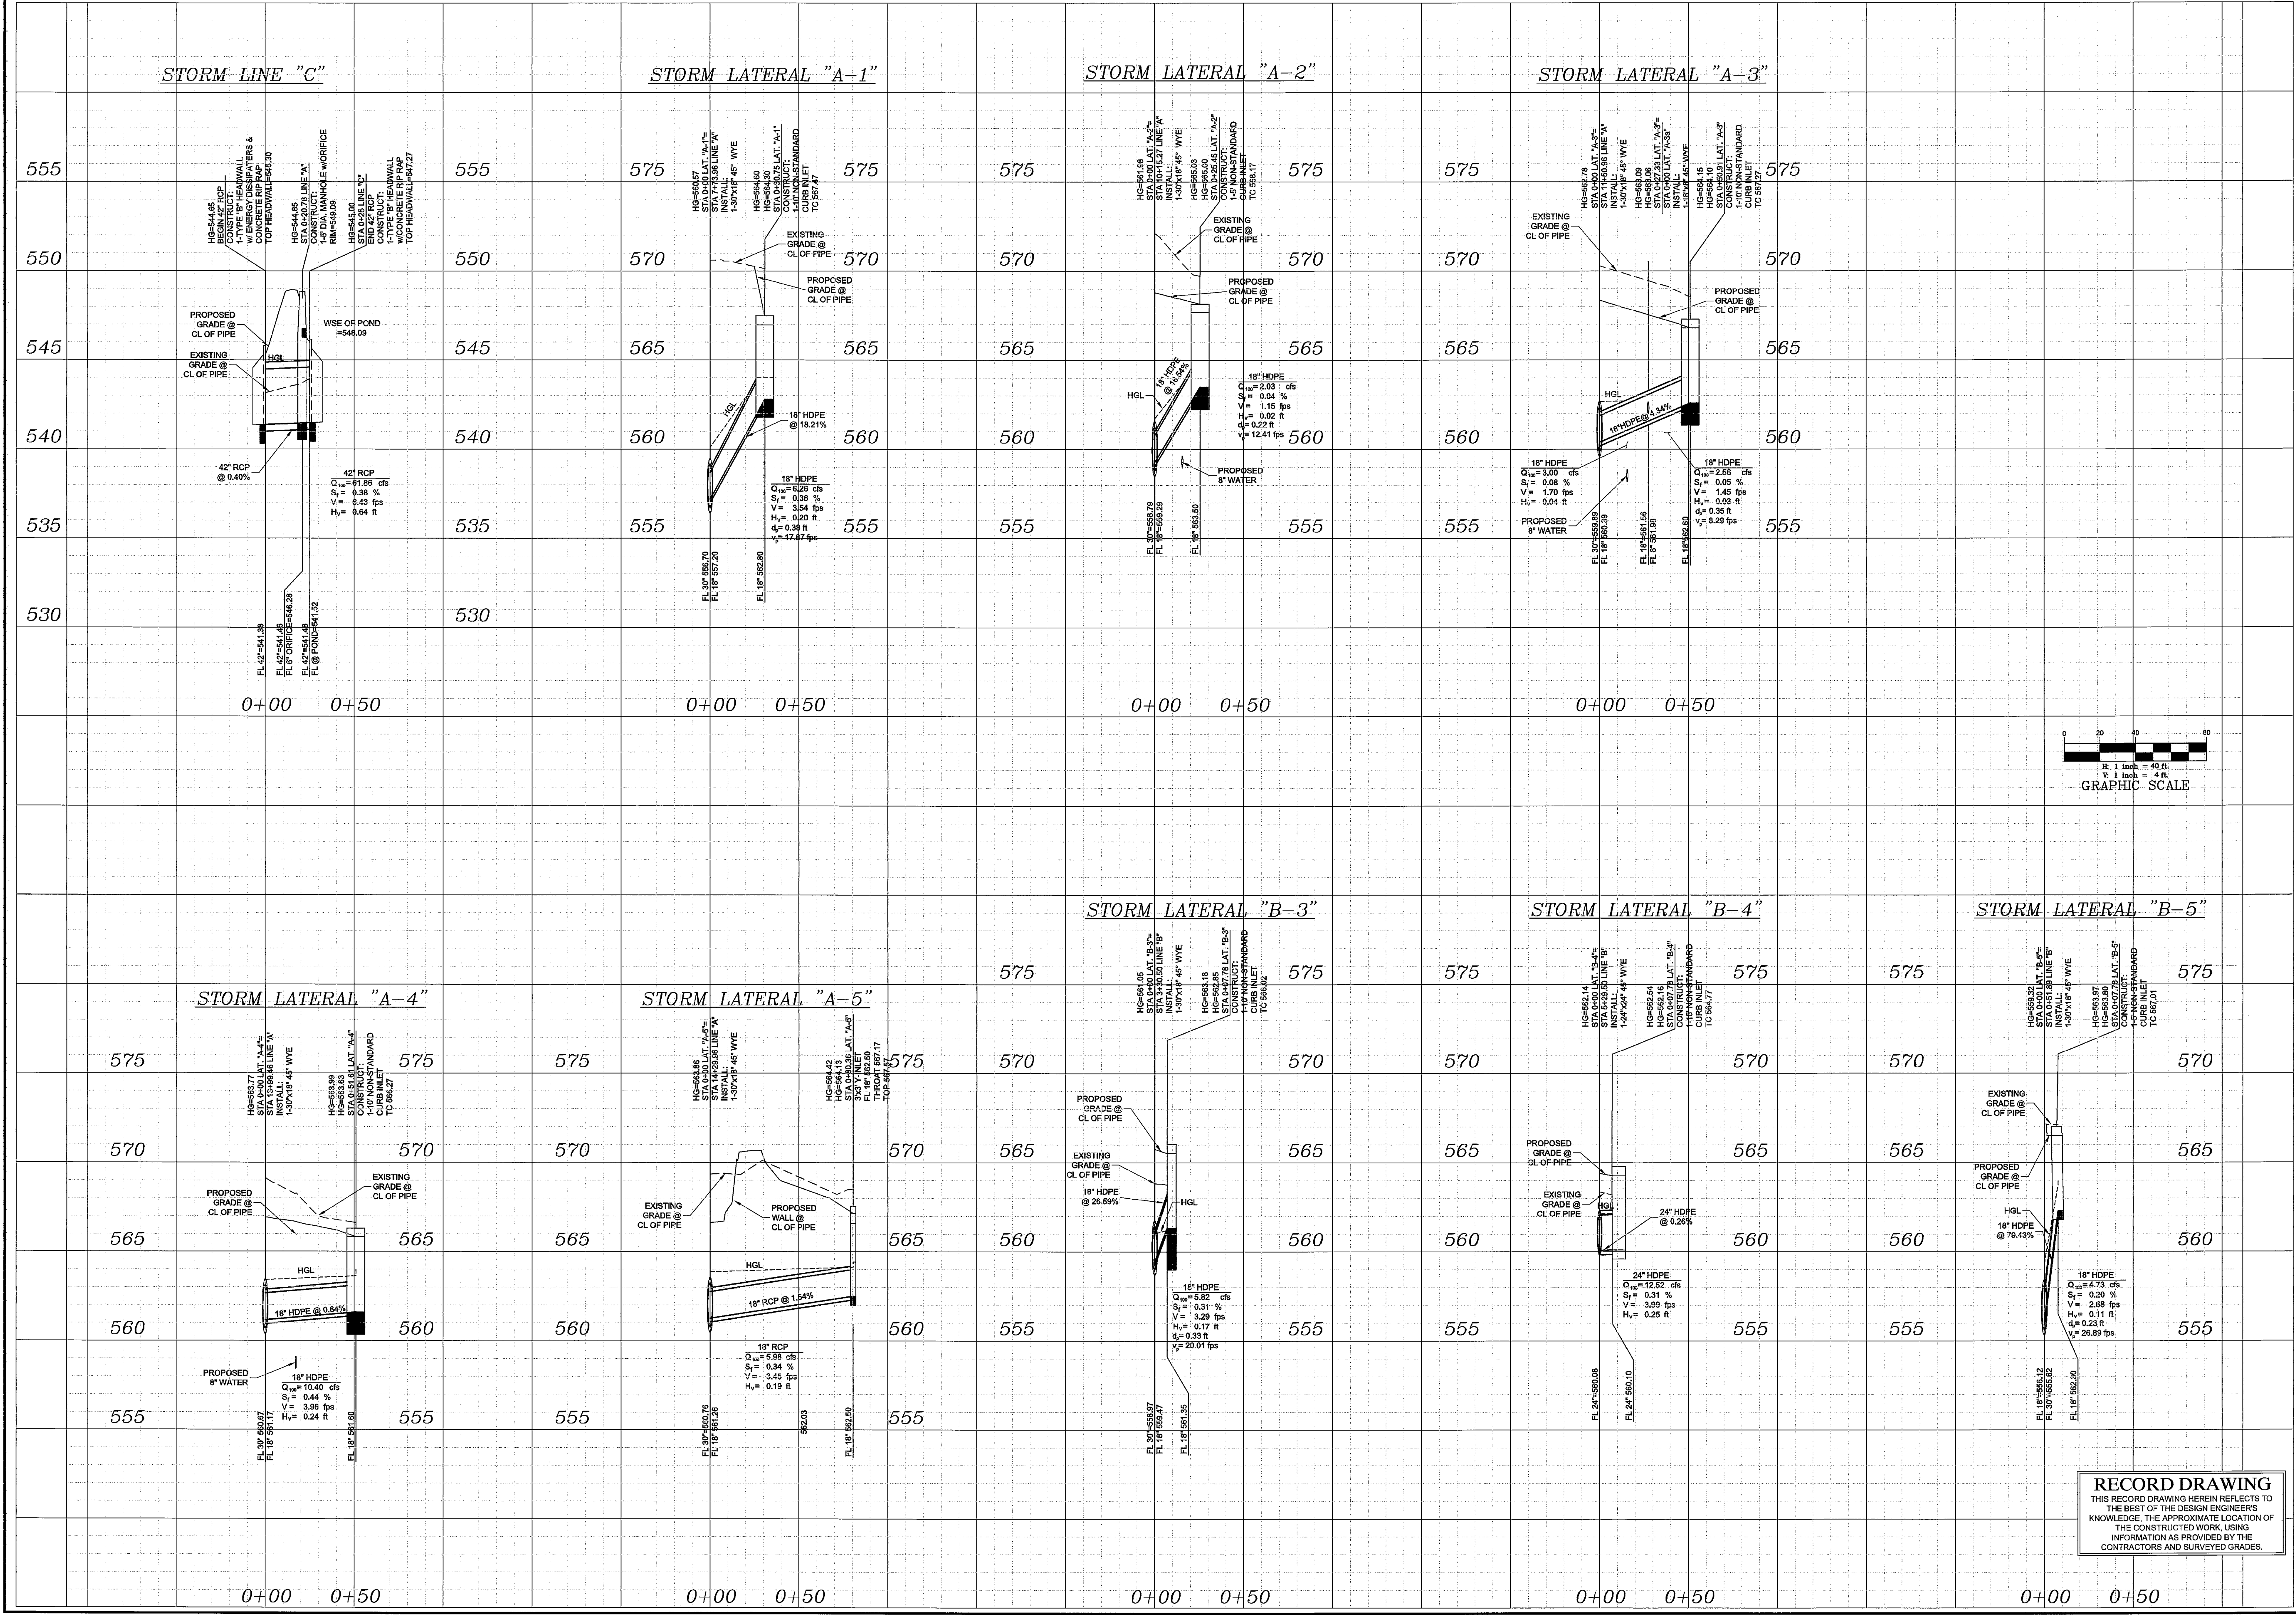

**RECORD DRAWING**  
 THIS RECORD DRAWING HEREIN REFLECTS TO THE BEST OF THE DESIGN ENGINEERS KNOWLEDGE, THE APPROXIMATE LOCATION OF THE CONSTRUCTED WORK, USING INFORMATION AS PROVIDED BY THE CONTRACTORS AND SURVEYED GRADES.